


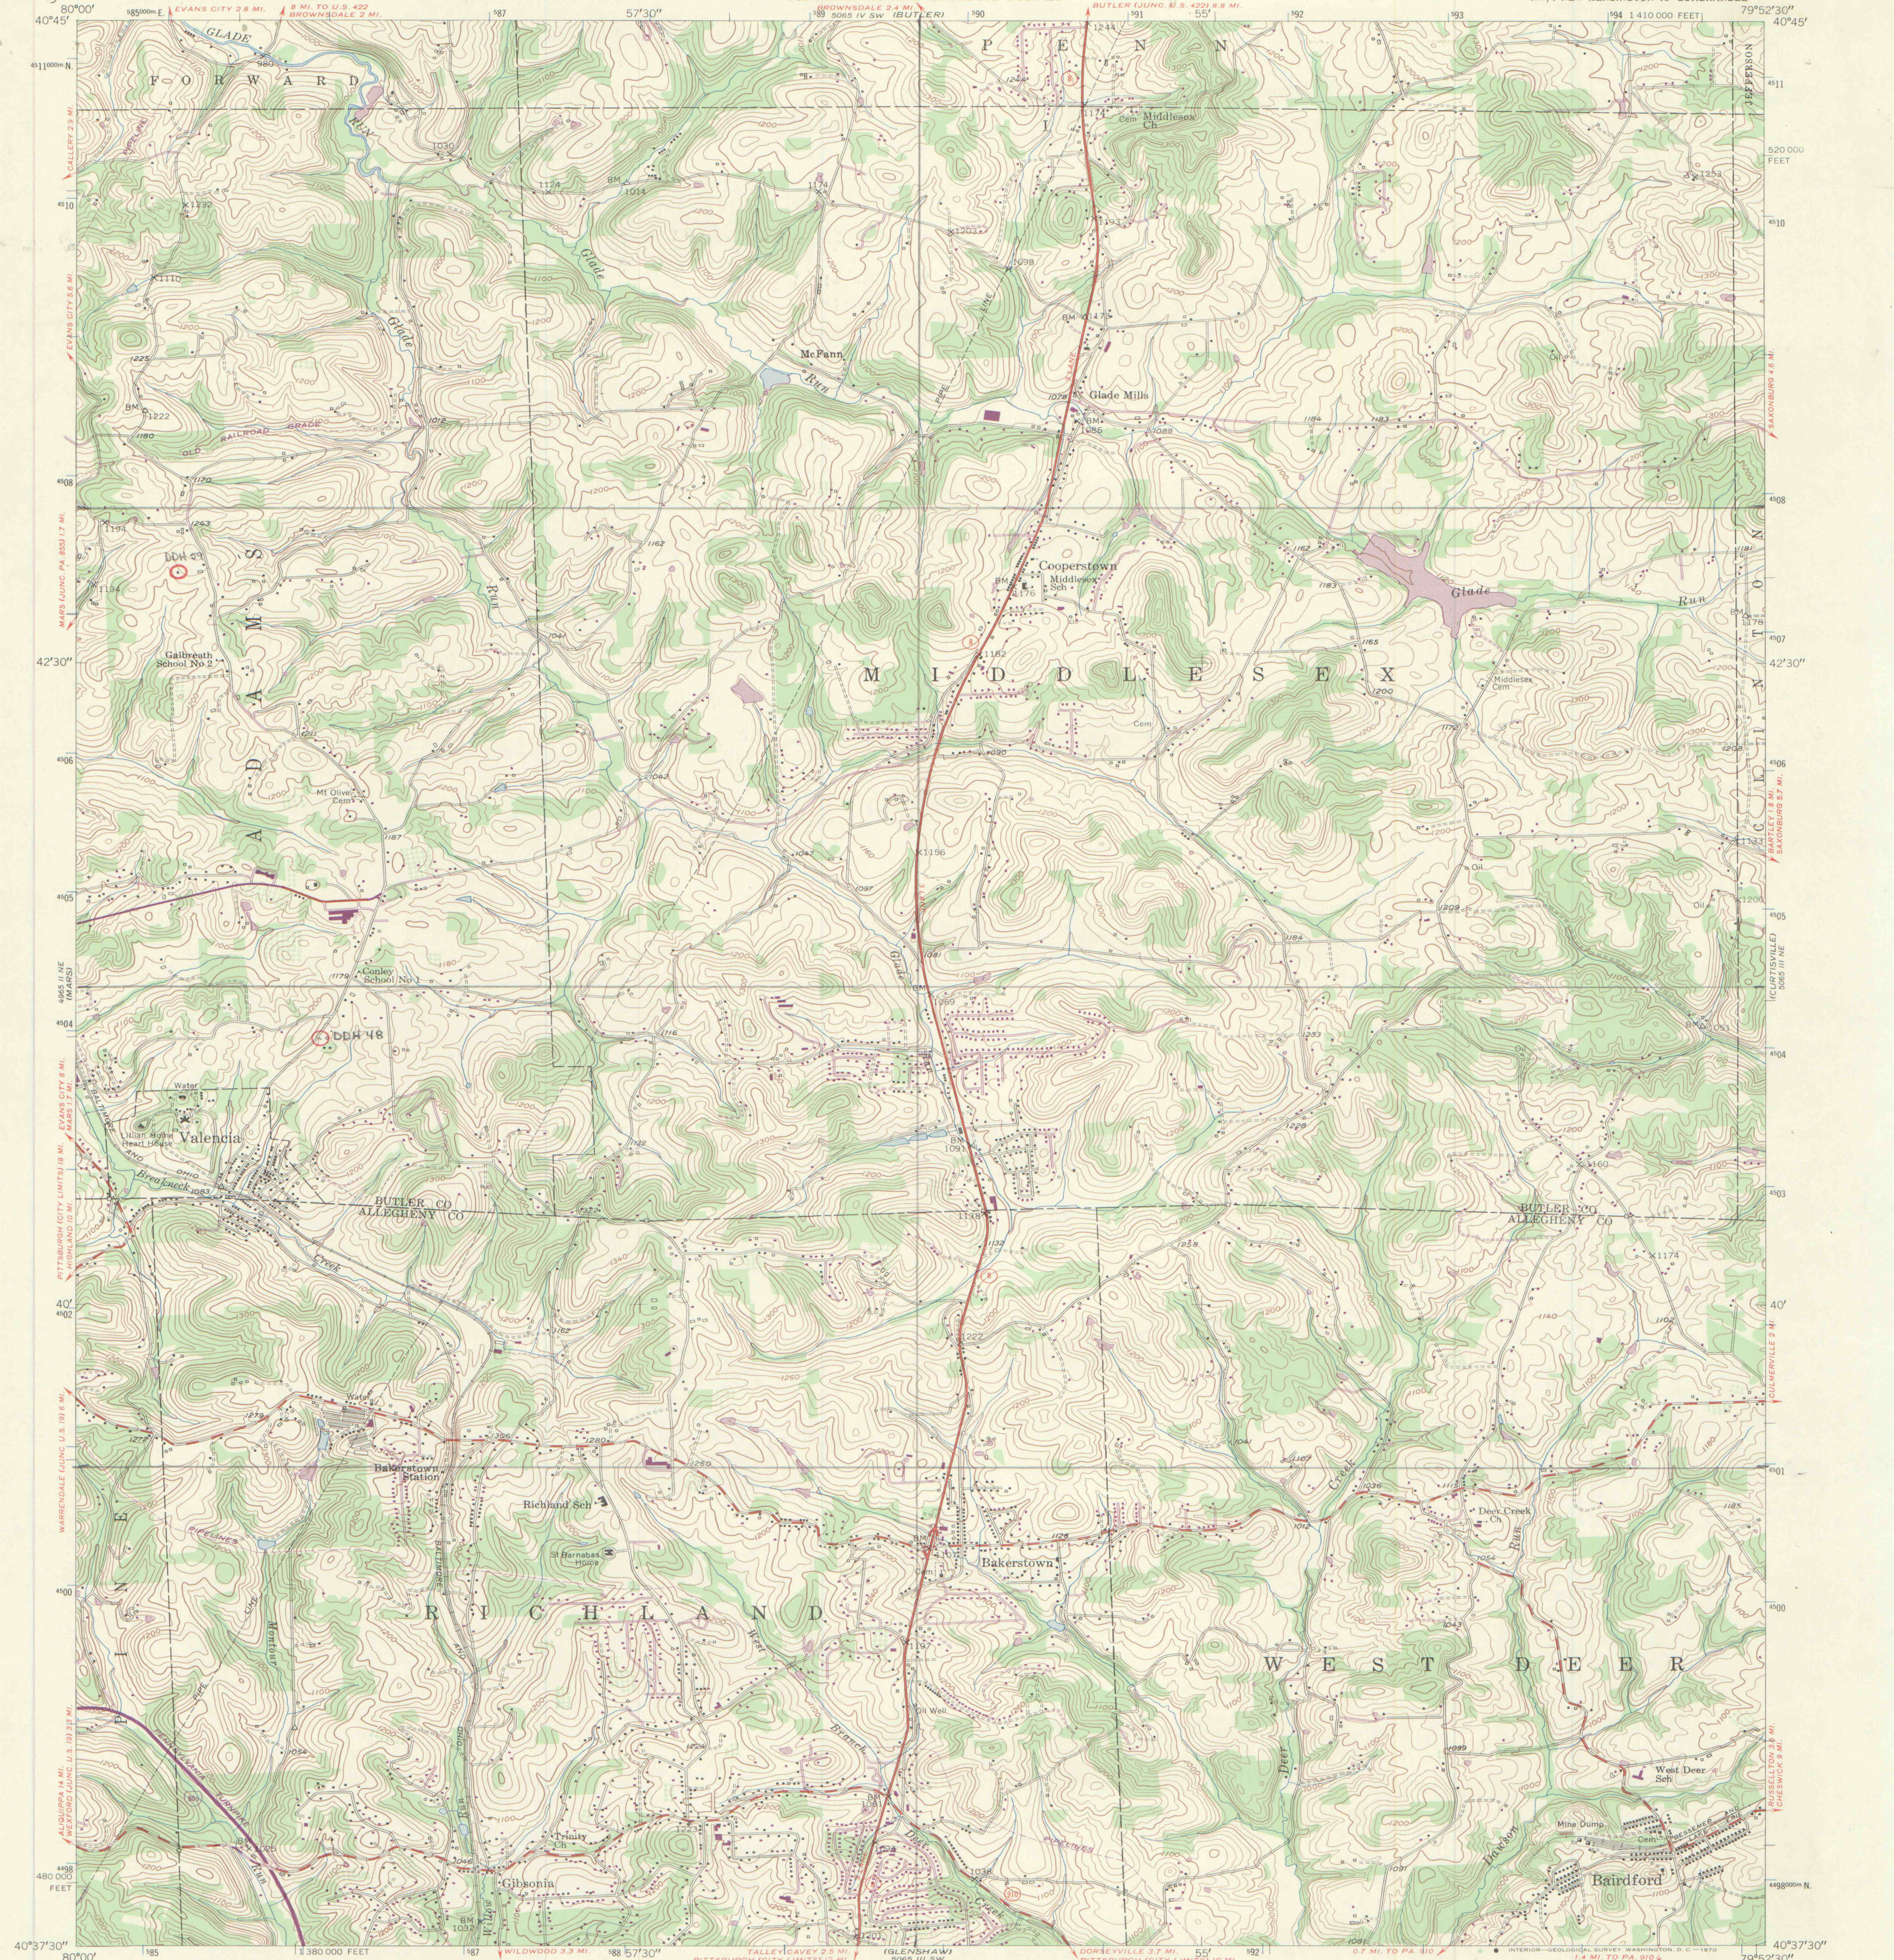

Maped, edited, and published by the Geological Survey

Control by USGS and USC&GS

Topography from aerial photographs by multiplex methods

Aerial photographs taken 1947. Field check 1950

Polyconic projection. 1927 North American datum

10,000-foot grid based on Pennsylvania coordinate system,

south zone

1000-meter Universal Transverse Mercator grid ticks,


zone 17, shown in blue

Revisions shown in purple compiled in cooperation with


State of Pennsylvania agencies from aerial photographs taken 1969

This information not field checked

UTM GRID AND 1969 MAGNETIC NORTH
DECLINATION AT CENTER OF SHEET

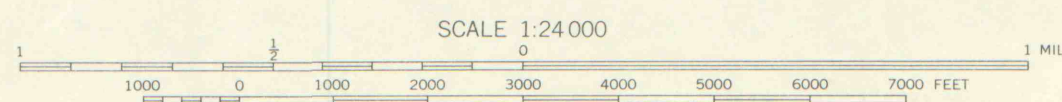

DIAMOND DRILL HOLE
Location Maps
A-02

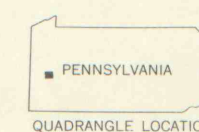

ROAD CLASSIFICATION
Heavy-duty 4 LANE 16 LANE Light-duty
Medium-duty 4 LANE 16 LANE Unimproved dirt
U. S. Route State Route
Interstate Route

VALENCIA, PA.
NW/4 NEW KENSINGTON 15' QUADRANGLE
N4037.5-W7952.5/7.5

1950
PHOTOREVISED 1969

AMS 5065 III NW-SERIES V831

IMAPS#09392