


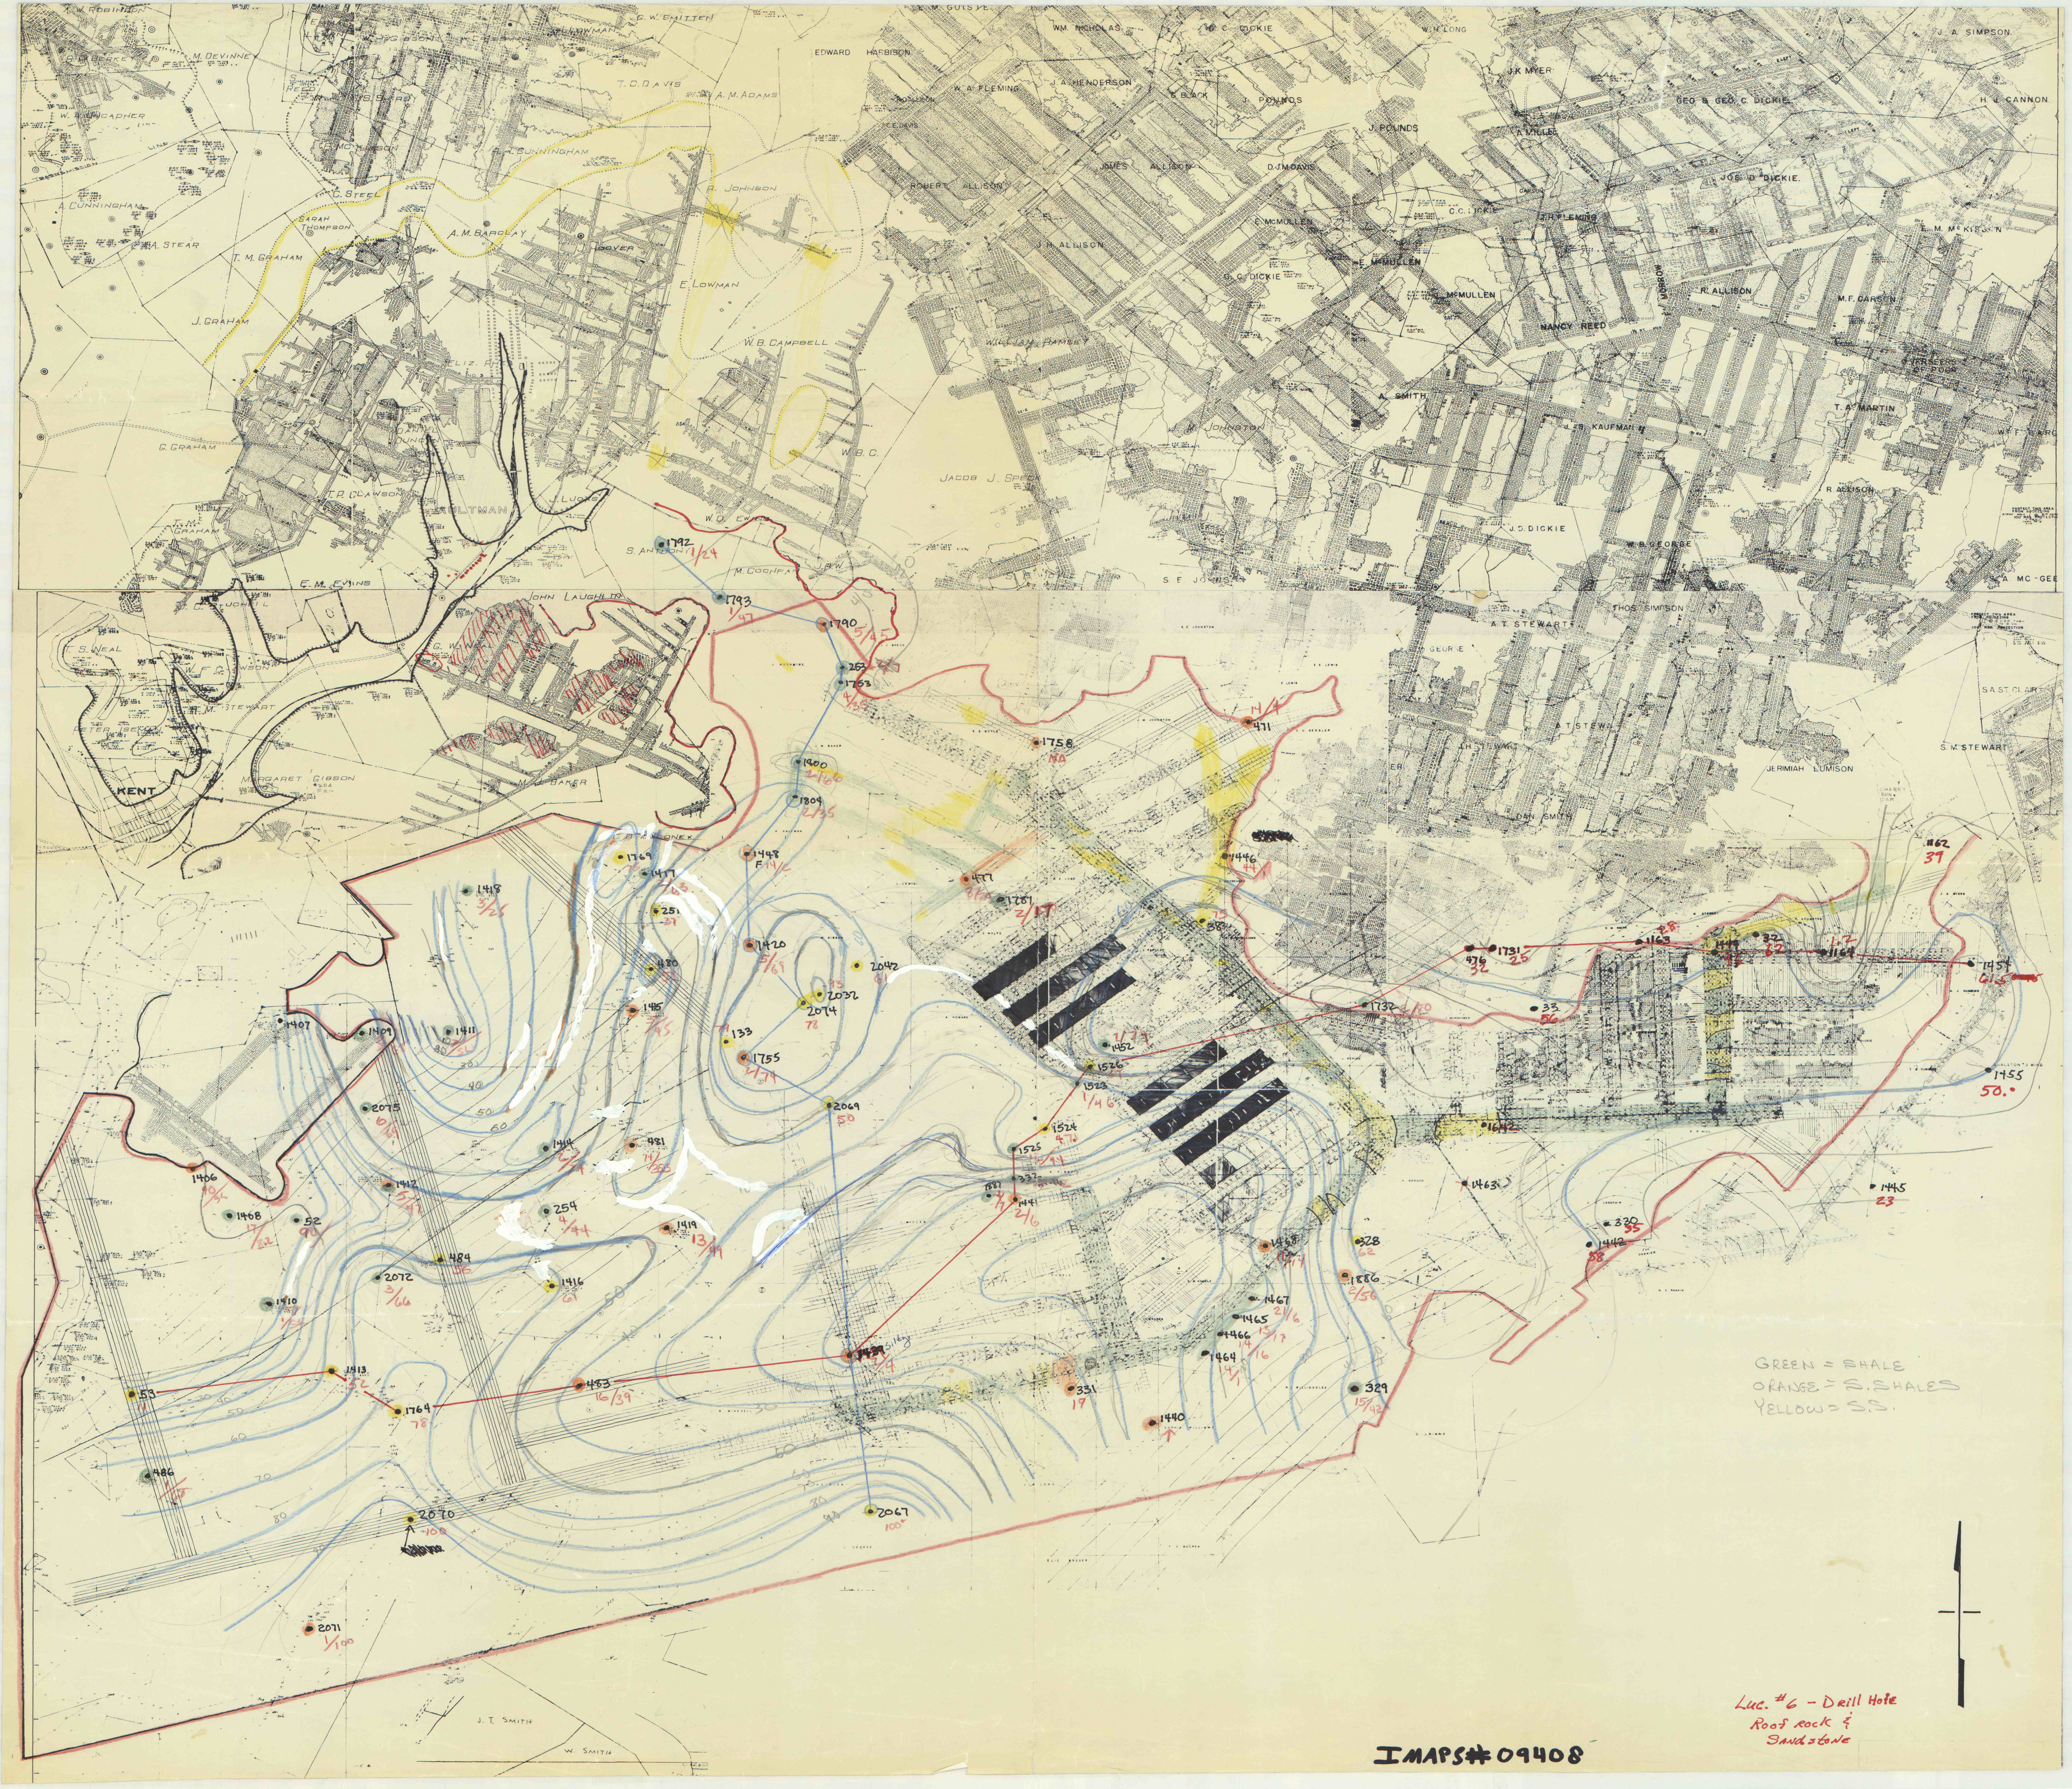

GREEN = SHALE
ORANGE = S. SHALES
YELLOW = S.S.

Luc. #6 - Drill Hole
Roof rock &
Sandstone

IMAPS# 09408