


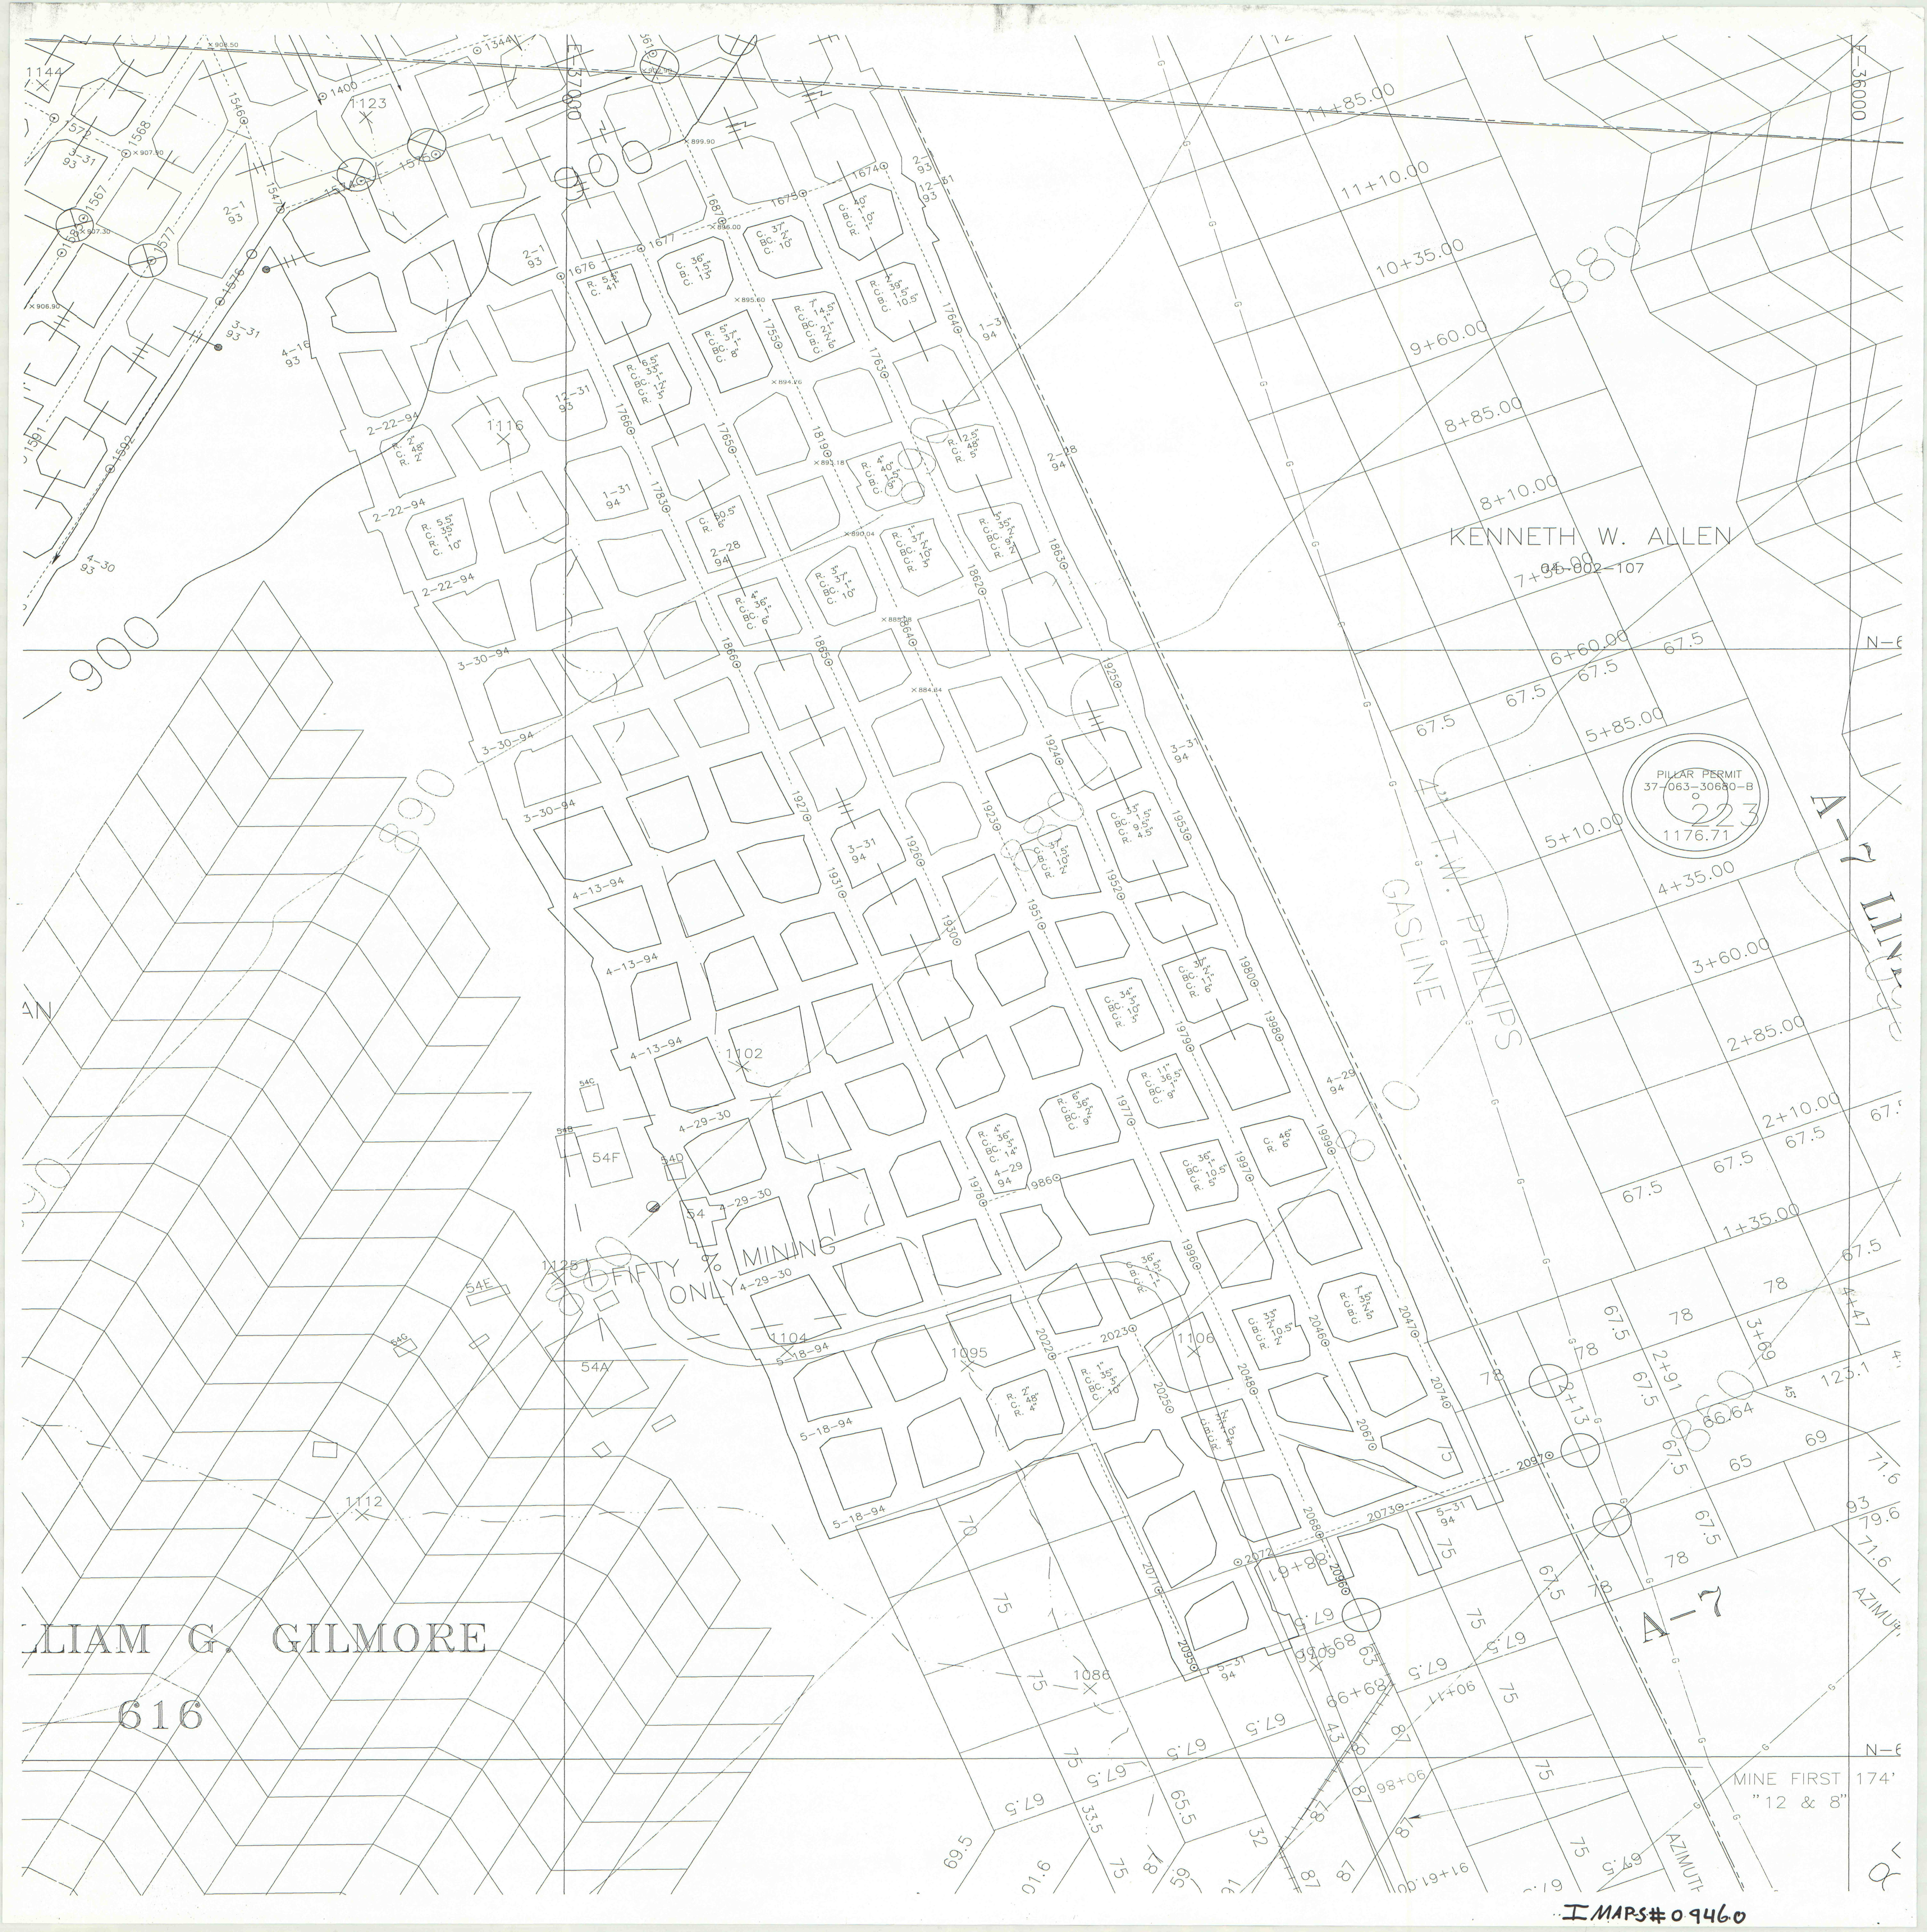

616

IMARS# 09460