


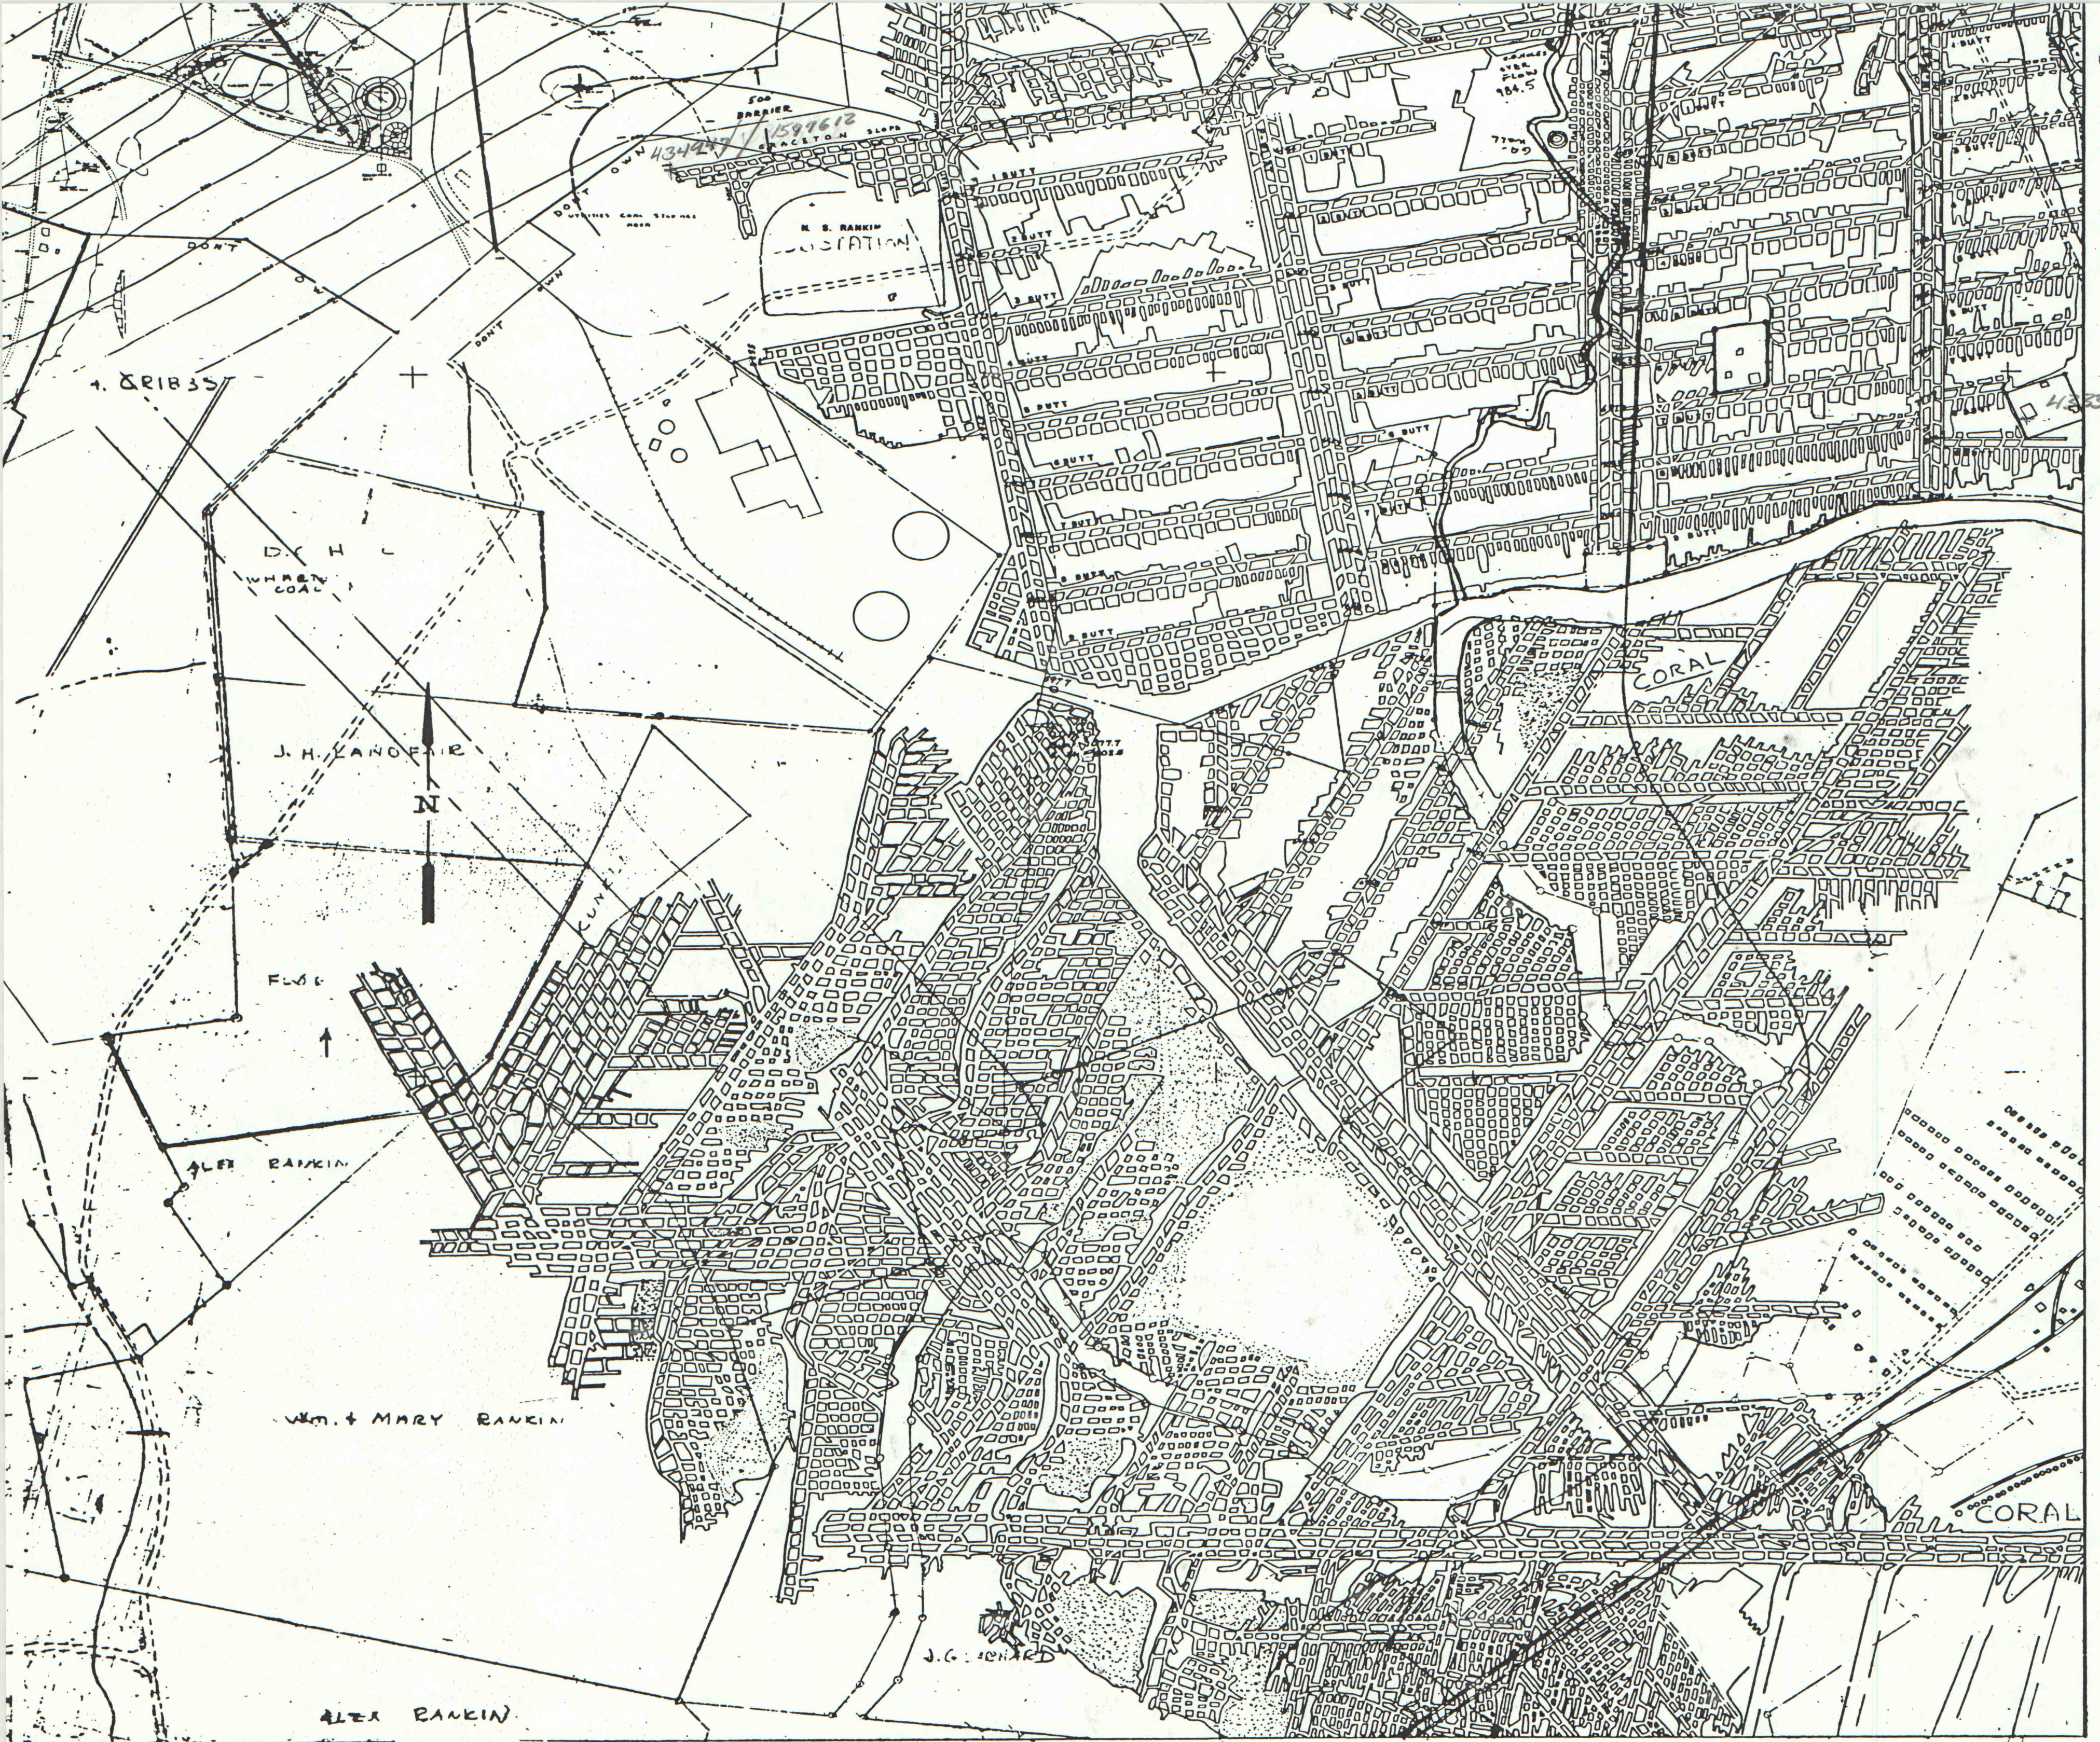

FIT TO 8

42335/1604463

500'
1"=1000' - KENT-ERNEST- LUC. "E"

7

IMAPS#09467