


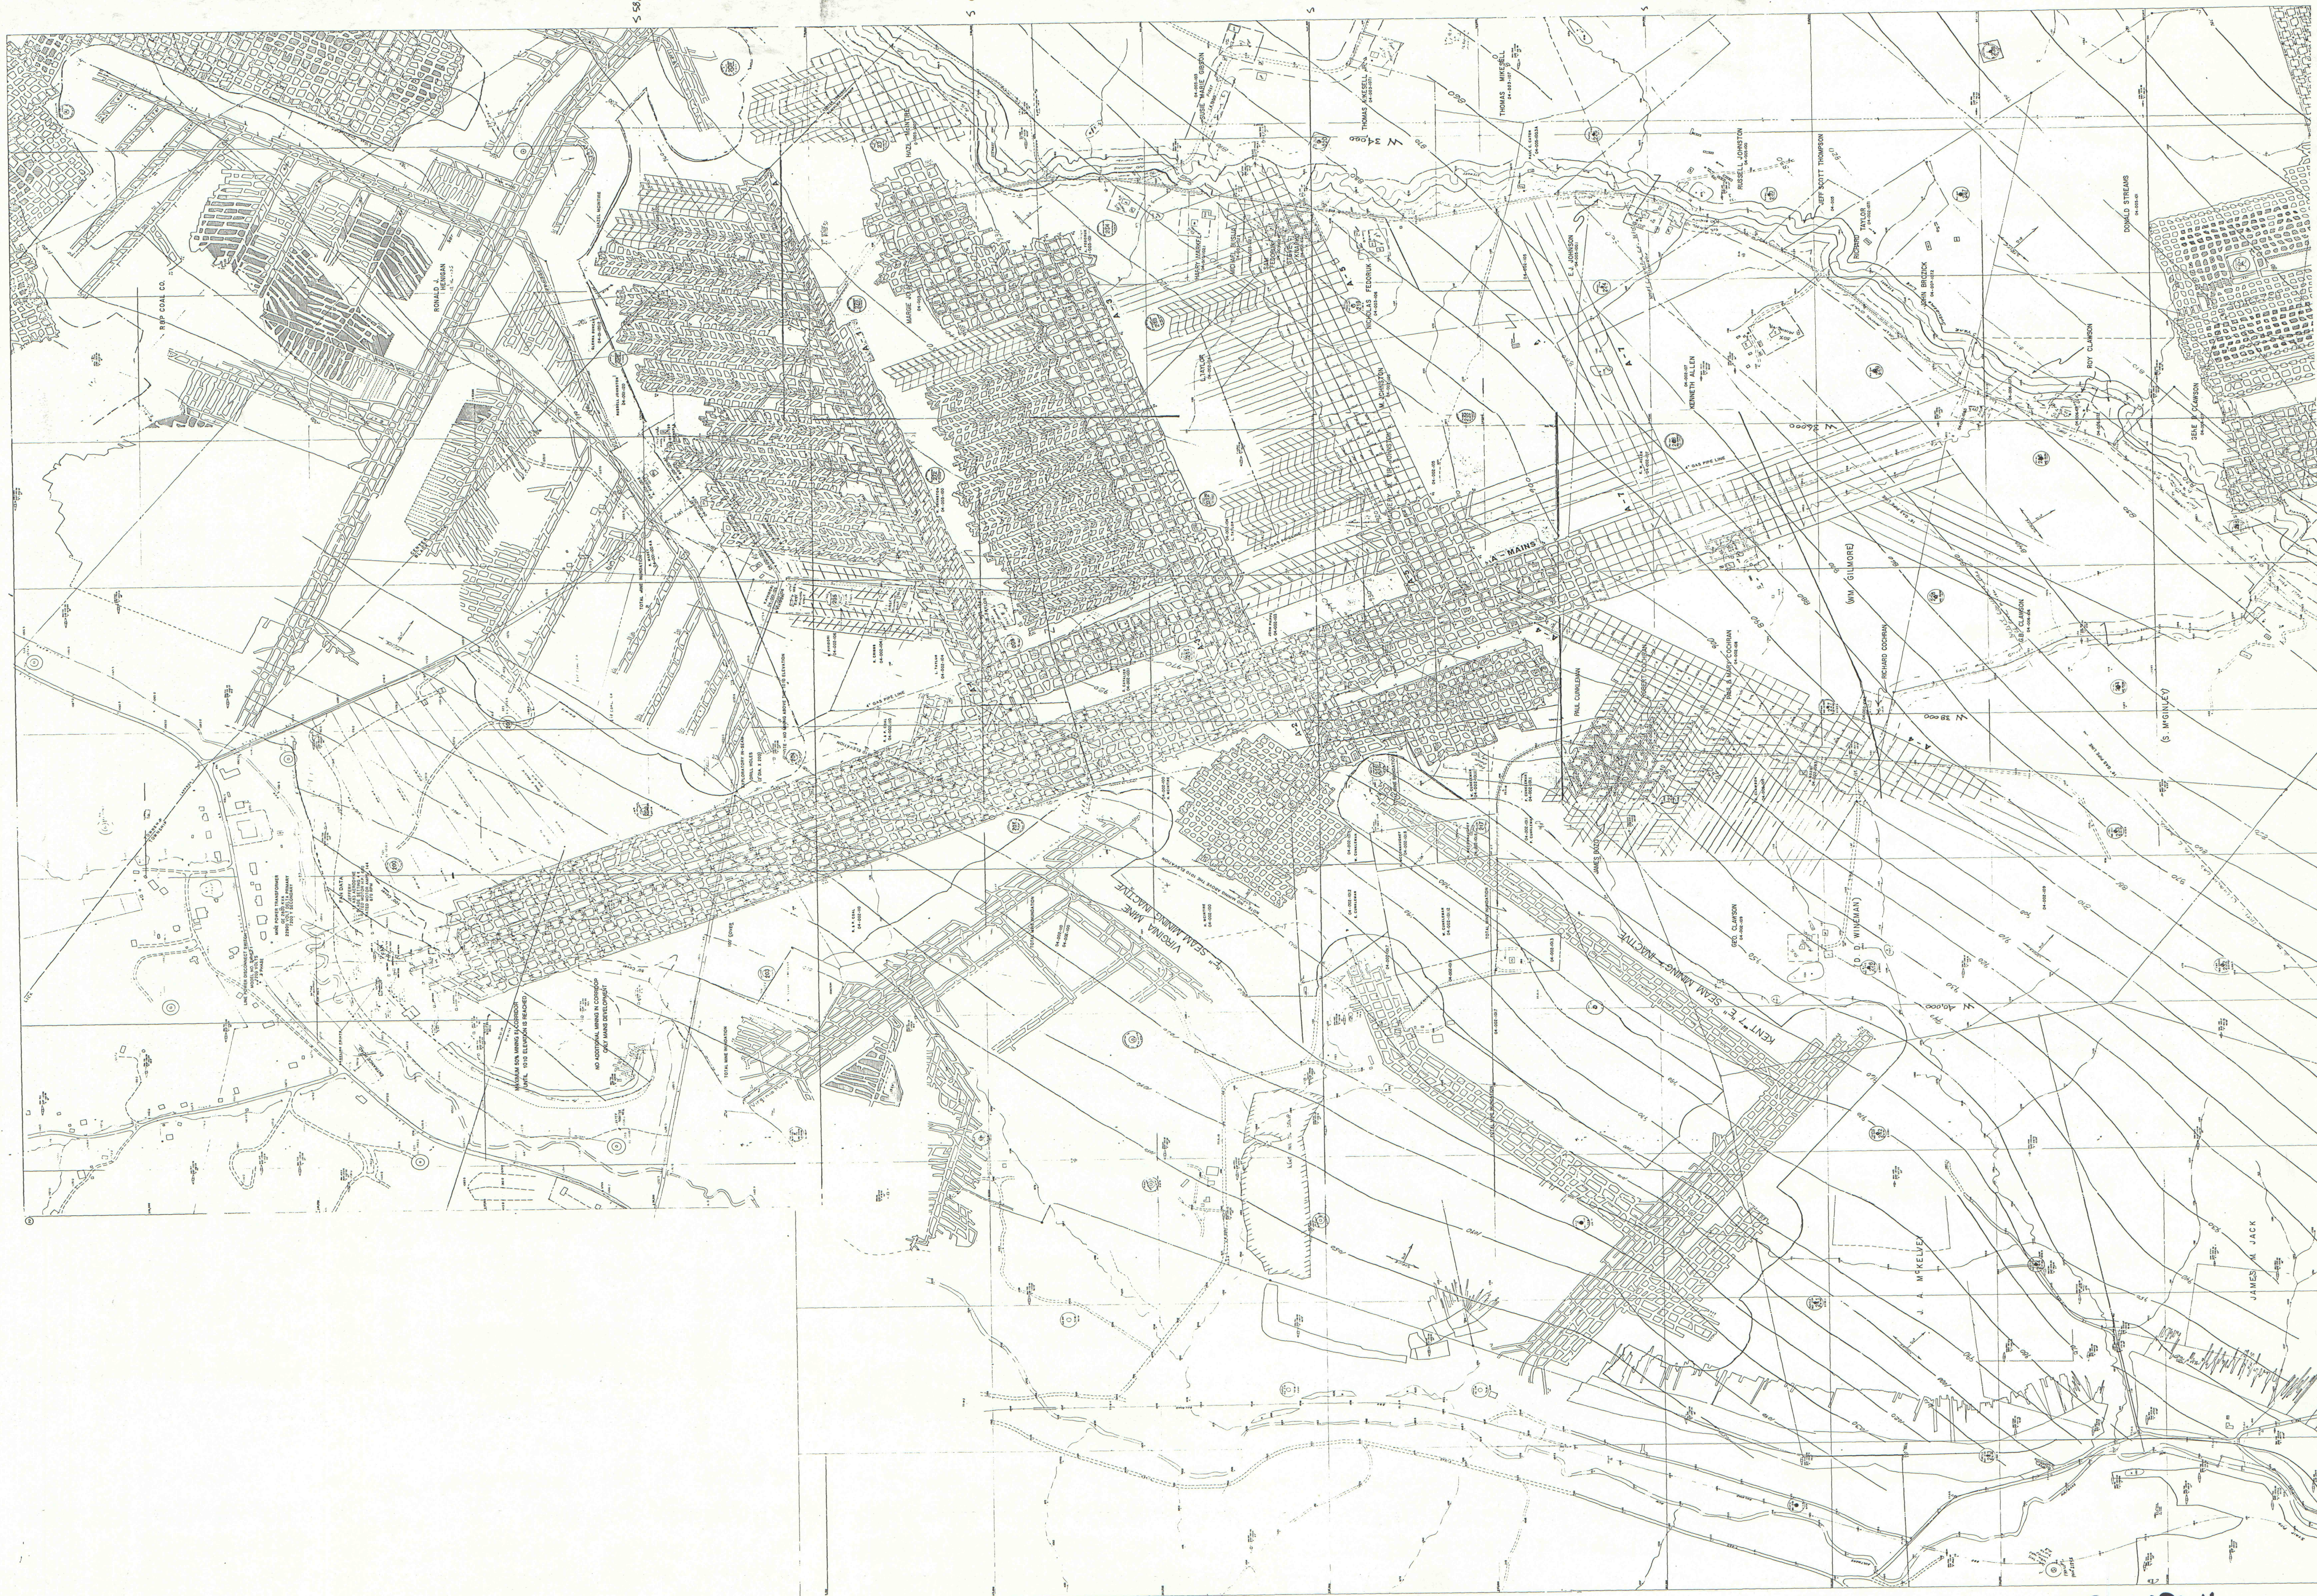

I-MAPS #
09470