


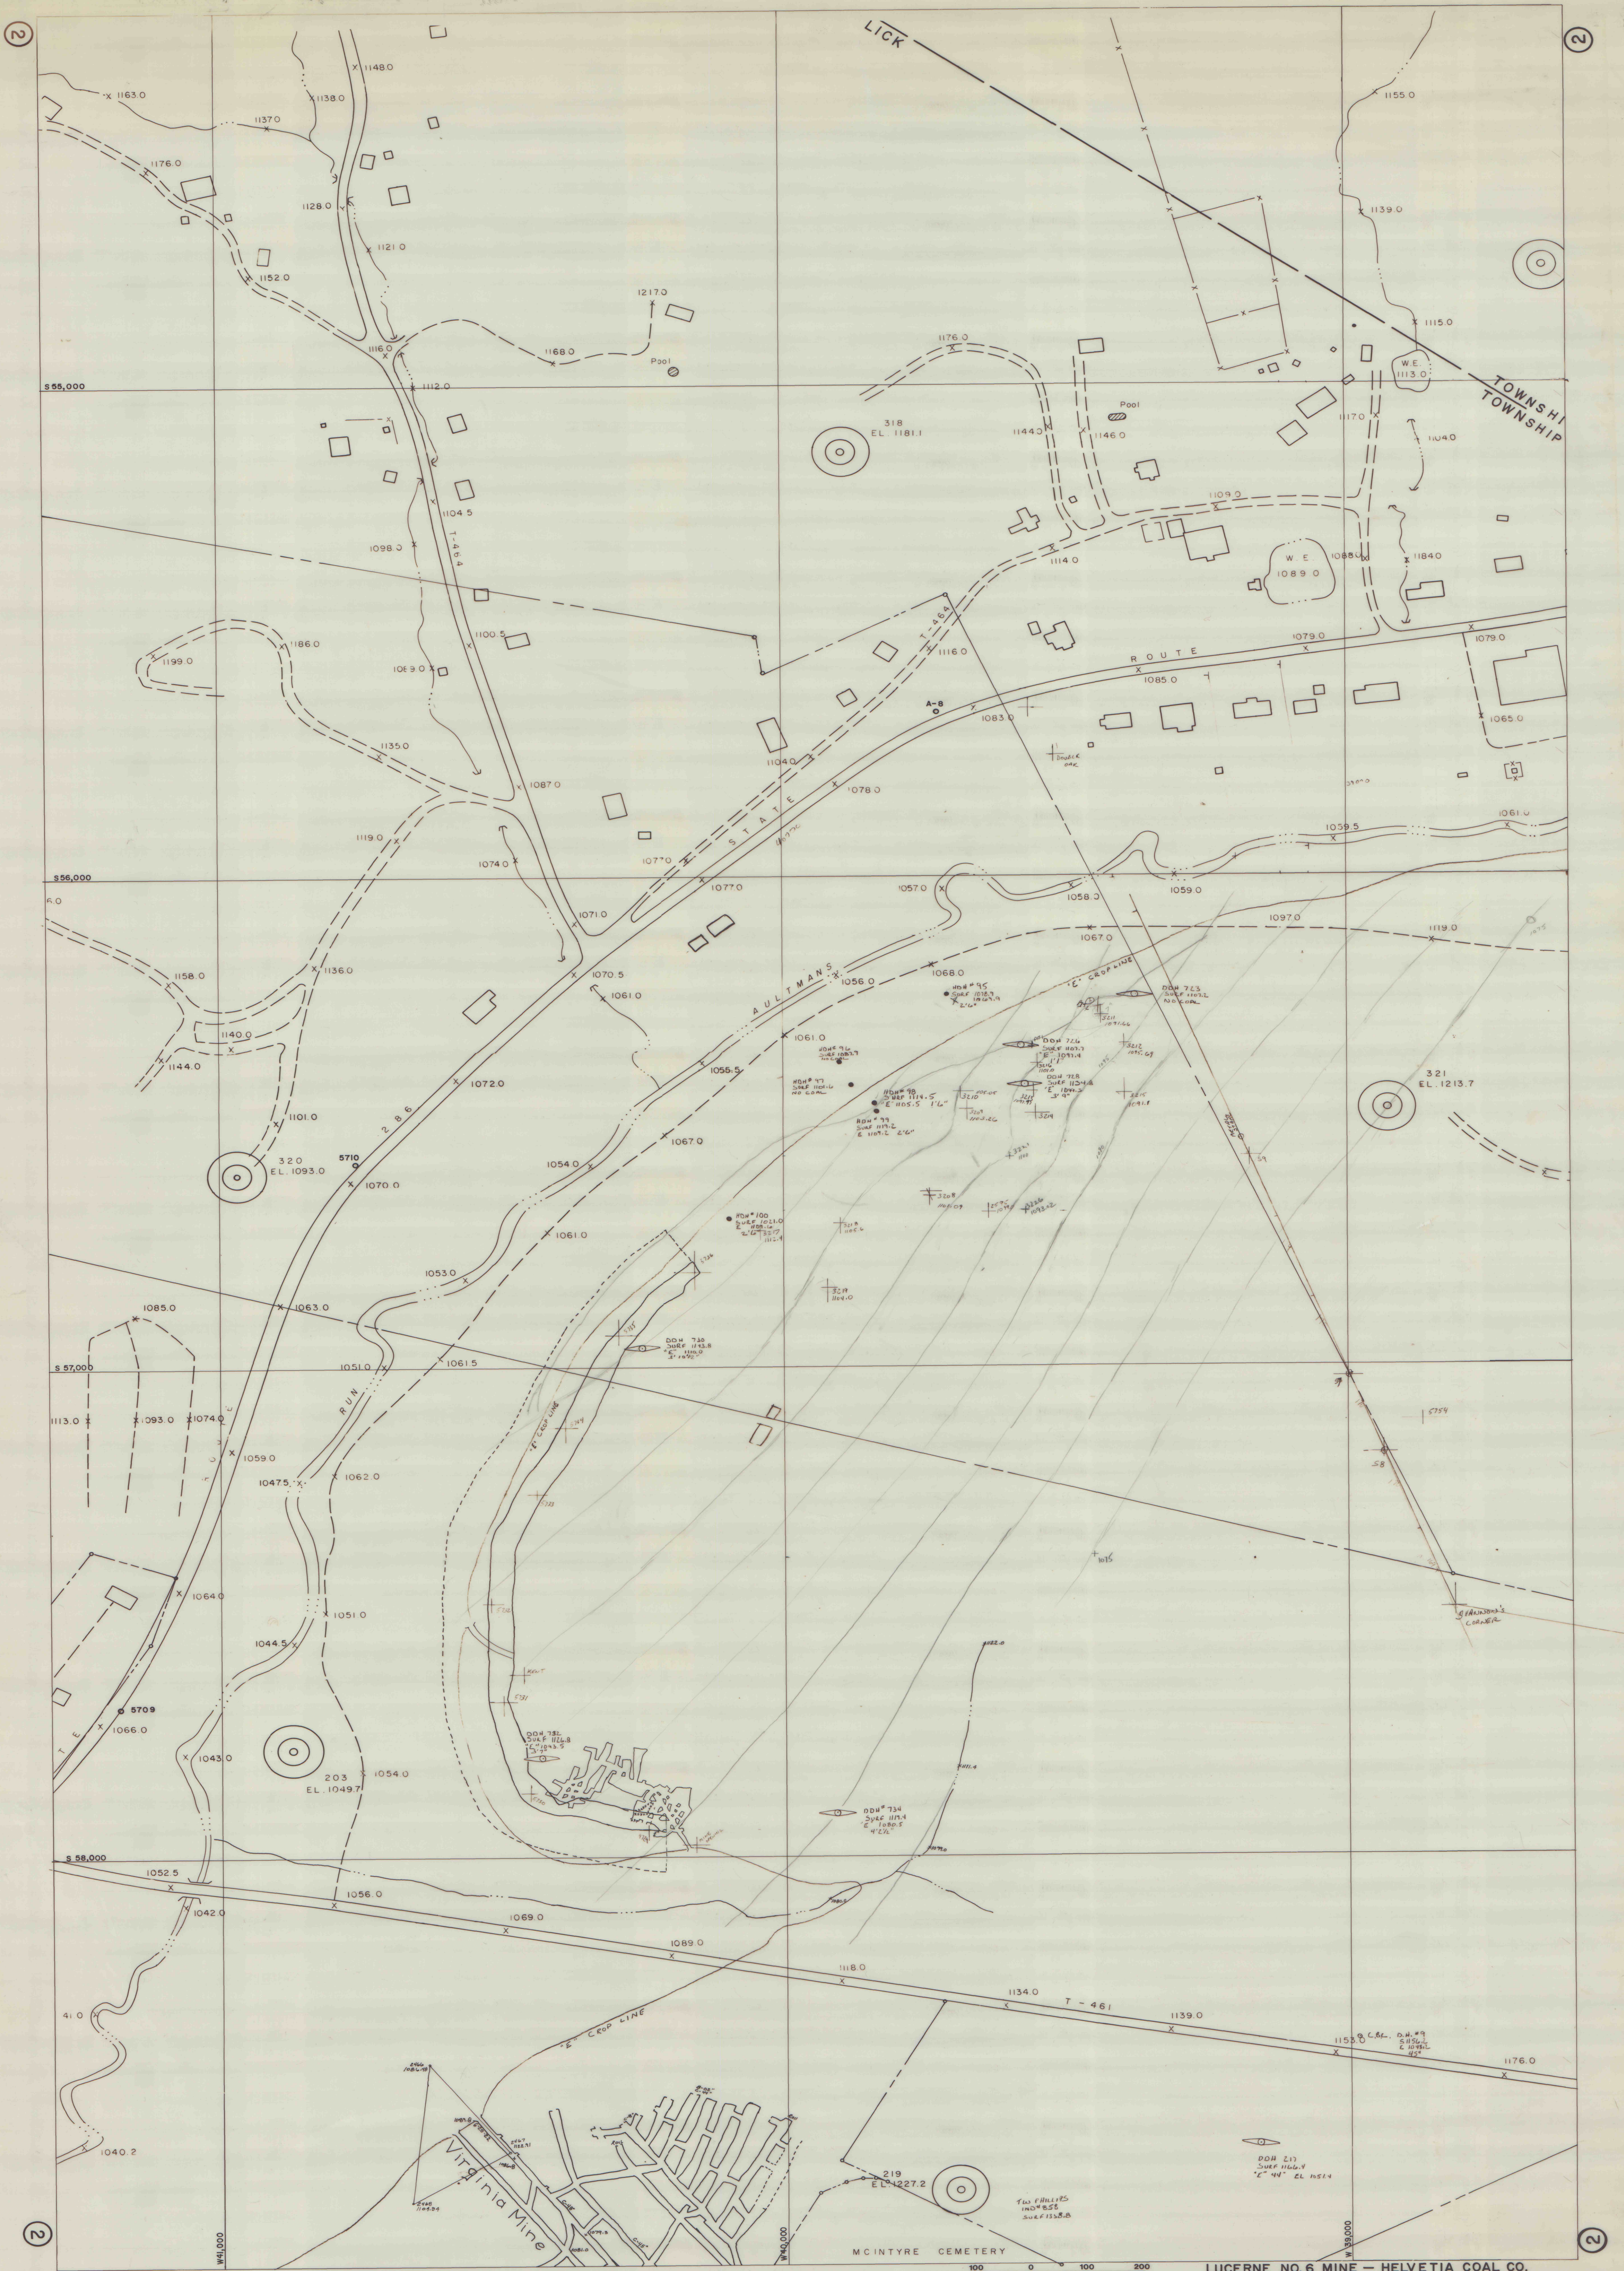

HARDCOPY

IMAPS 09503

LUCERNE NO. 6 MINE - HELVETIA COAL CO.
BLACKLICK TWP., INDIANA CO.