


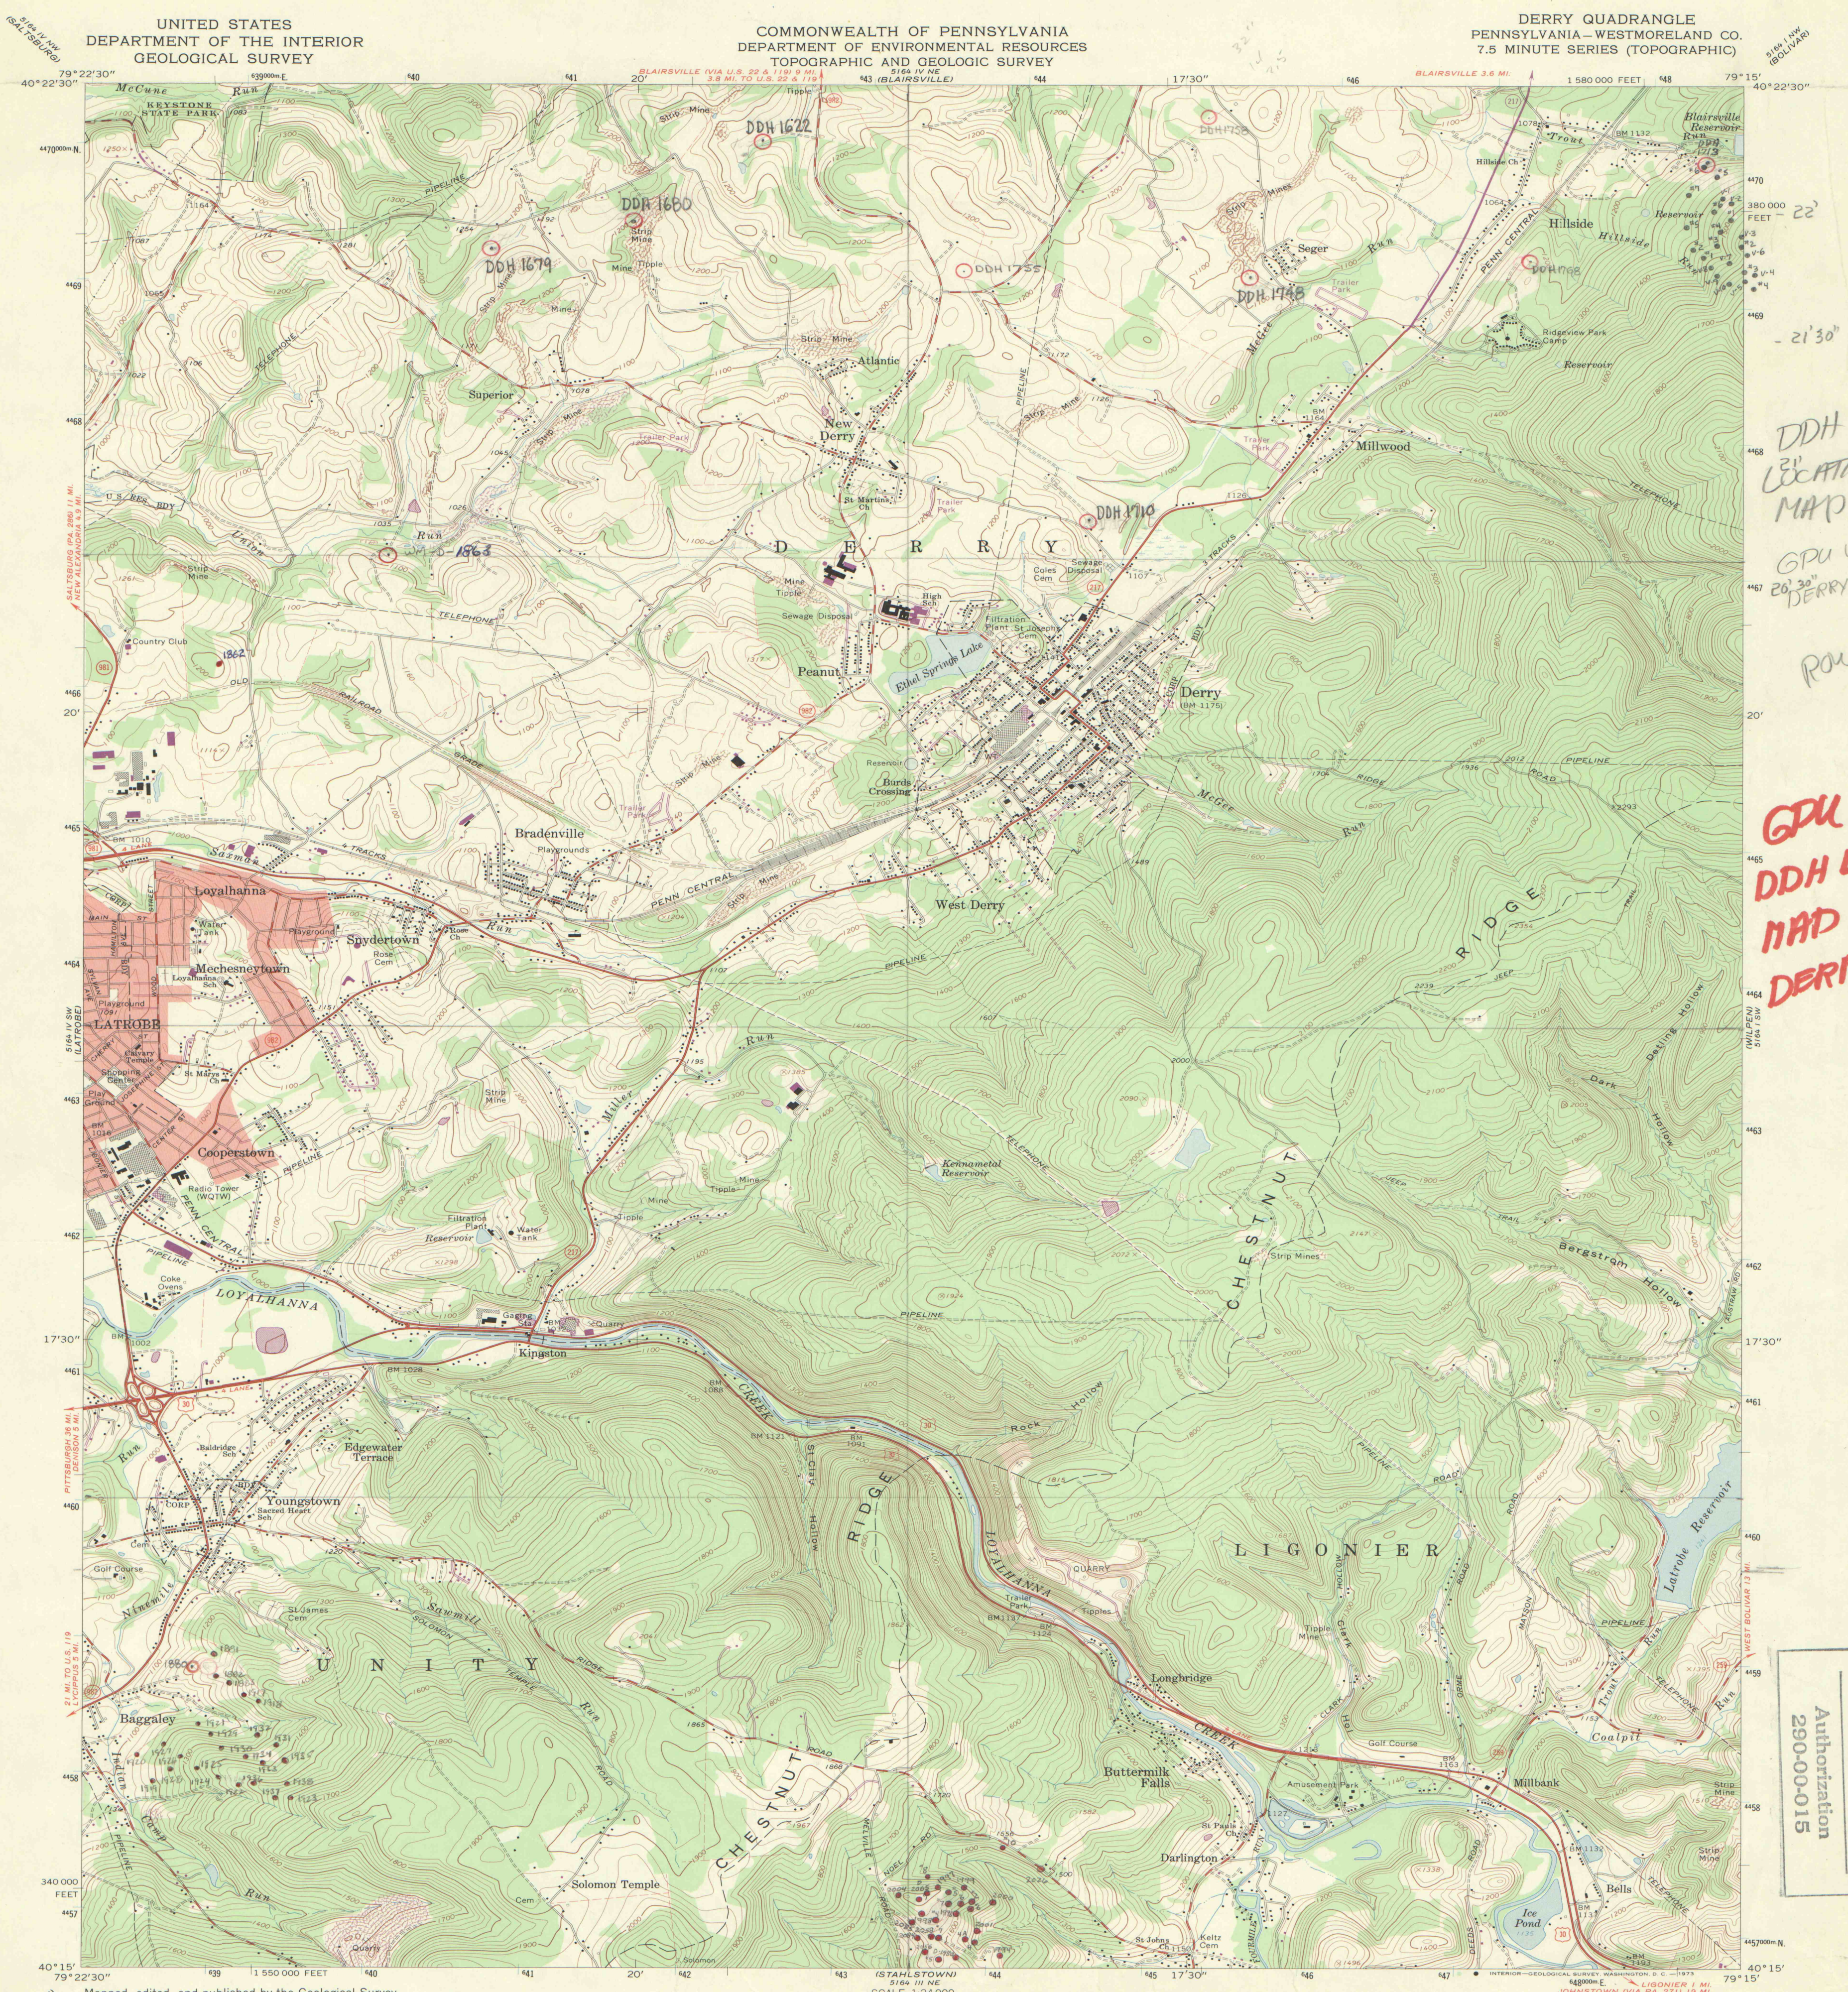


UNITED STATES
DEPARTMENT OF THE INTERIOR
GEOLOGICAL SURVEY

COMMONWEALTH OF PENNSYLVANIA
DEPARTMENT OF ENVIRONMENTAL RESOURCES
TOPOGRAPHIC AND GEOLOGIC SURVEY

DERRY QUADRANGLE
PENNSYLVANIA—WESTMORELAND CO.
7.5 MINUTE SERIES (TOPOGRAPHIC)

Mapped, edited, and published by the Geological Survey
Control by USGS and USC&GS
Topography by photogrammetric methods from aerial photographs
taken 1962. Field checked 1964
Polyconic projection. 1927 North American datum
10,000-foot grid based on Pennsylvania coordinate system, south zone
1000-meter Universal Transverse Mercator grid ticks, zone 17,
shown in blue
Fine red dashed lines indicate selected fence and field lines where
generally visible on aerial photographs. This information is unchecked
Red tint indicates area in which only landmark buildings are shown
U. S. Reservation boundary from maps by U. S. Corps of Engineers
Area covered by dashed light-blue pattern is subject to controlled
inundation by Loyalhanna Dam

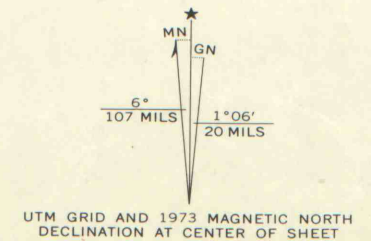

DIAMOND DRILL HOLE
Location Maps
A-02
4-7-D
NOT TO BE TAKEN FROM OFFICE

Revisions shown in purple compiled in cooperation with
State of Pennsylvania agencies from aerial photographs
taken 1973. This information not field checked

ROAD CLASSIFICATION
Heavy-duty ——— Light-duty ———
Medium-duty ——— Unimproved dirt ———
U. S. Route ——— State Route ———

DERRY, PA.
N4015—W7915/7.5
1964
PHOTOREVISED 1973
AMS 5164 IV SE-SERIES V831

Exploration Services
Division
Authorization
290-00-015

DDH
LOCATION
MAP
GPU WEST CO.
DERRY QUAD
ROW 6-D
GPU
DDH LOCATI
MAP
DERRY

h260 #53YWI