


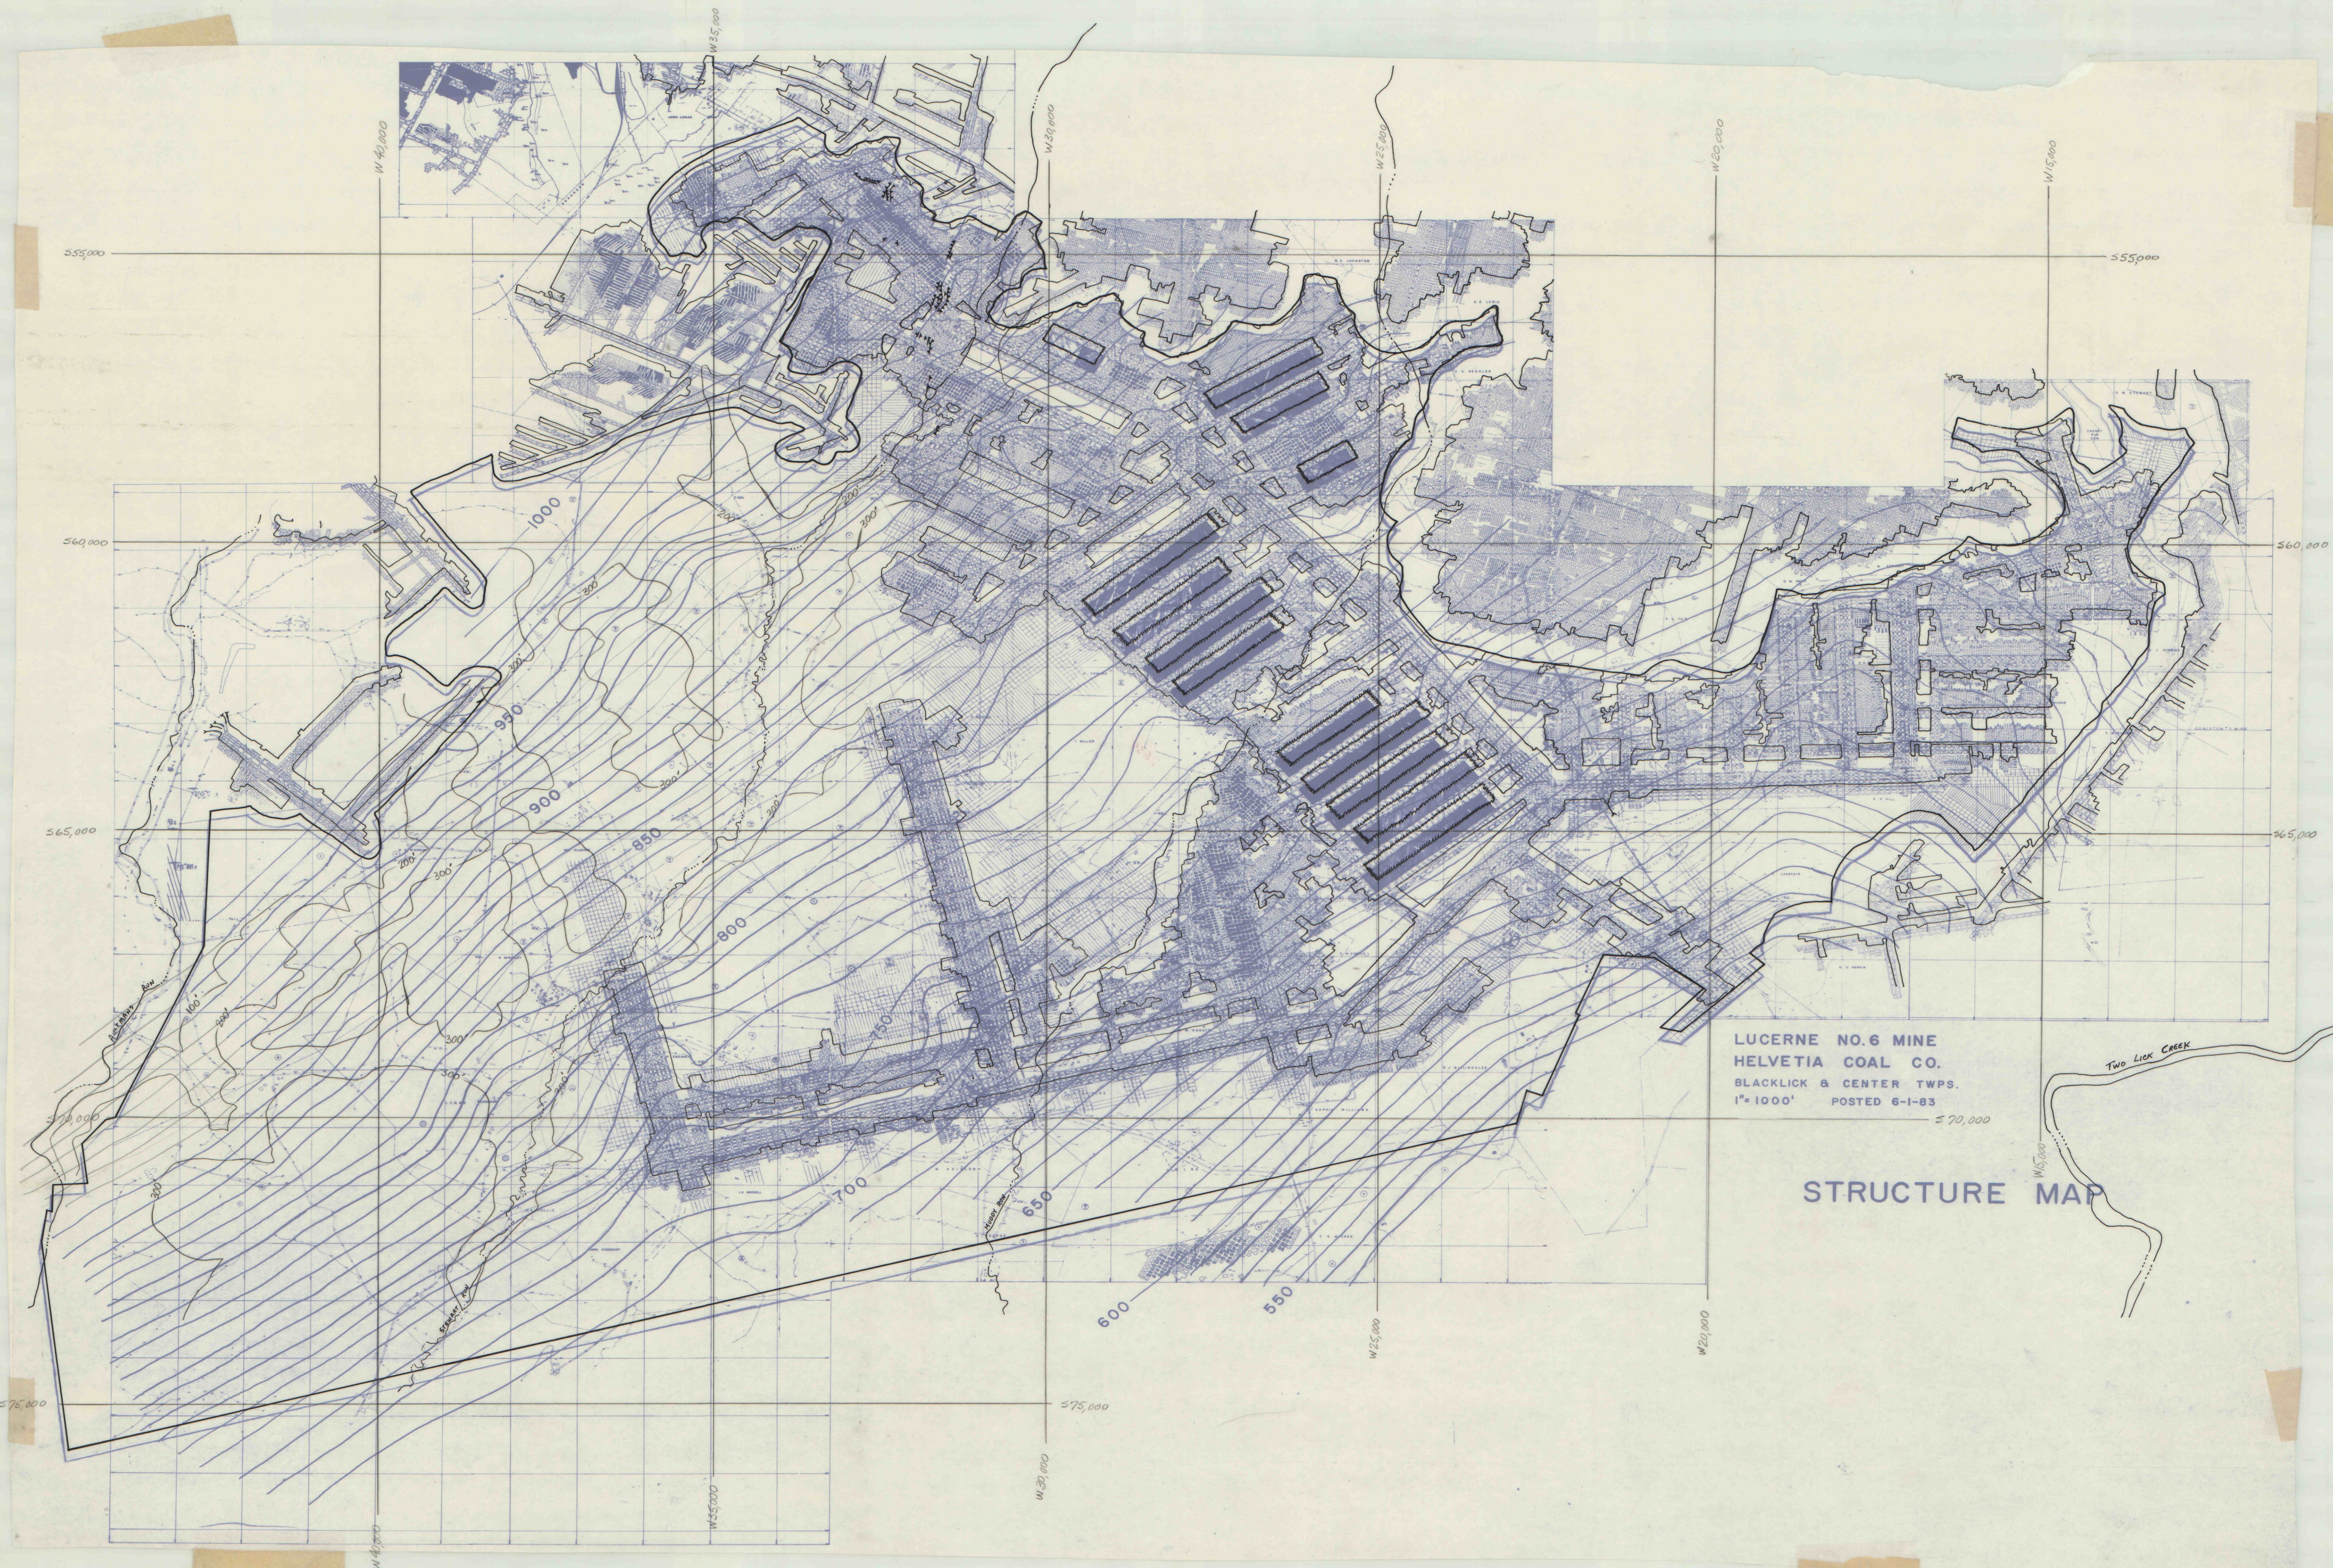

IMAPS# 09518