
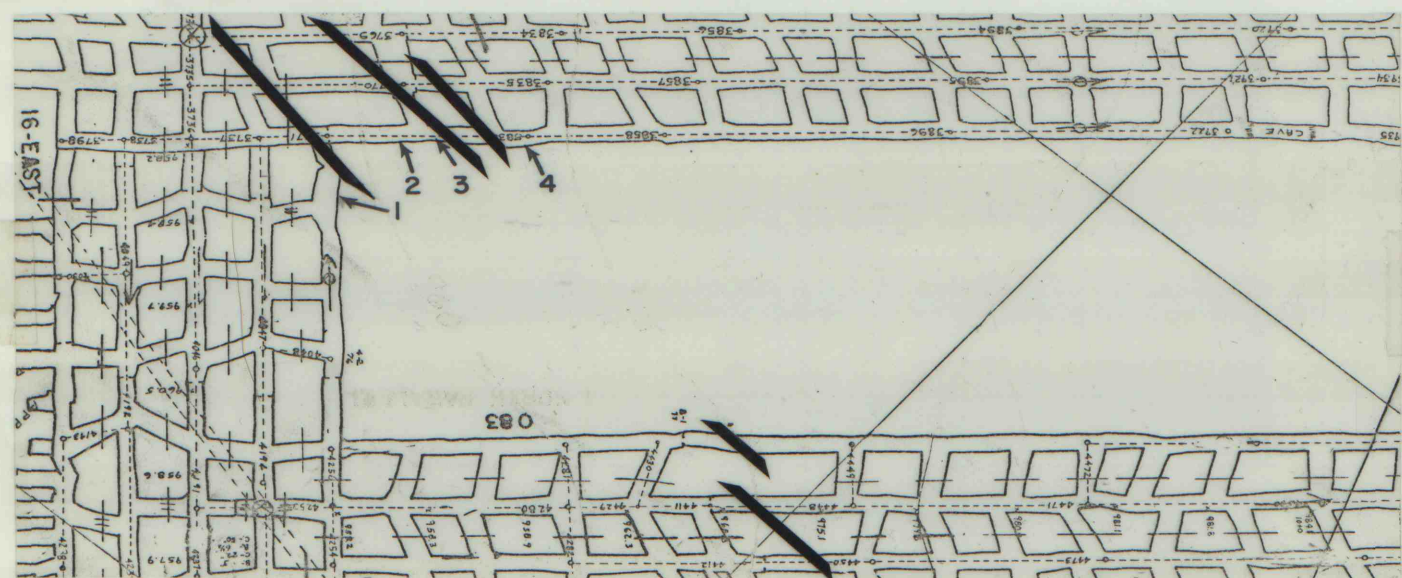


LUCERNE 6

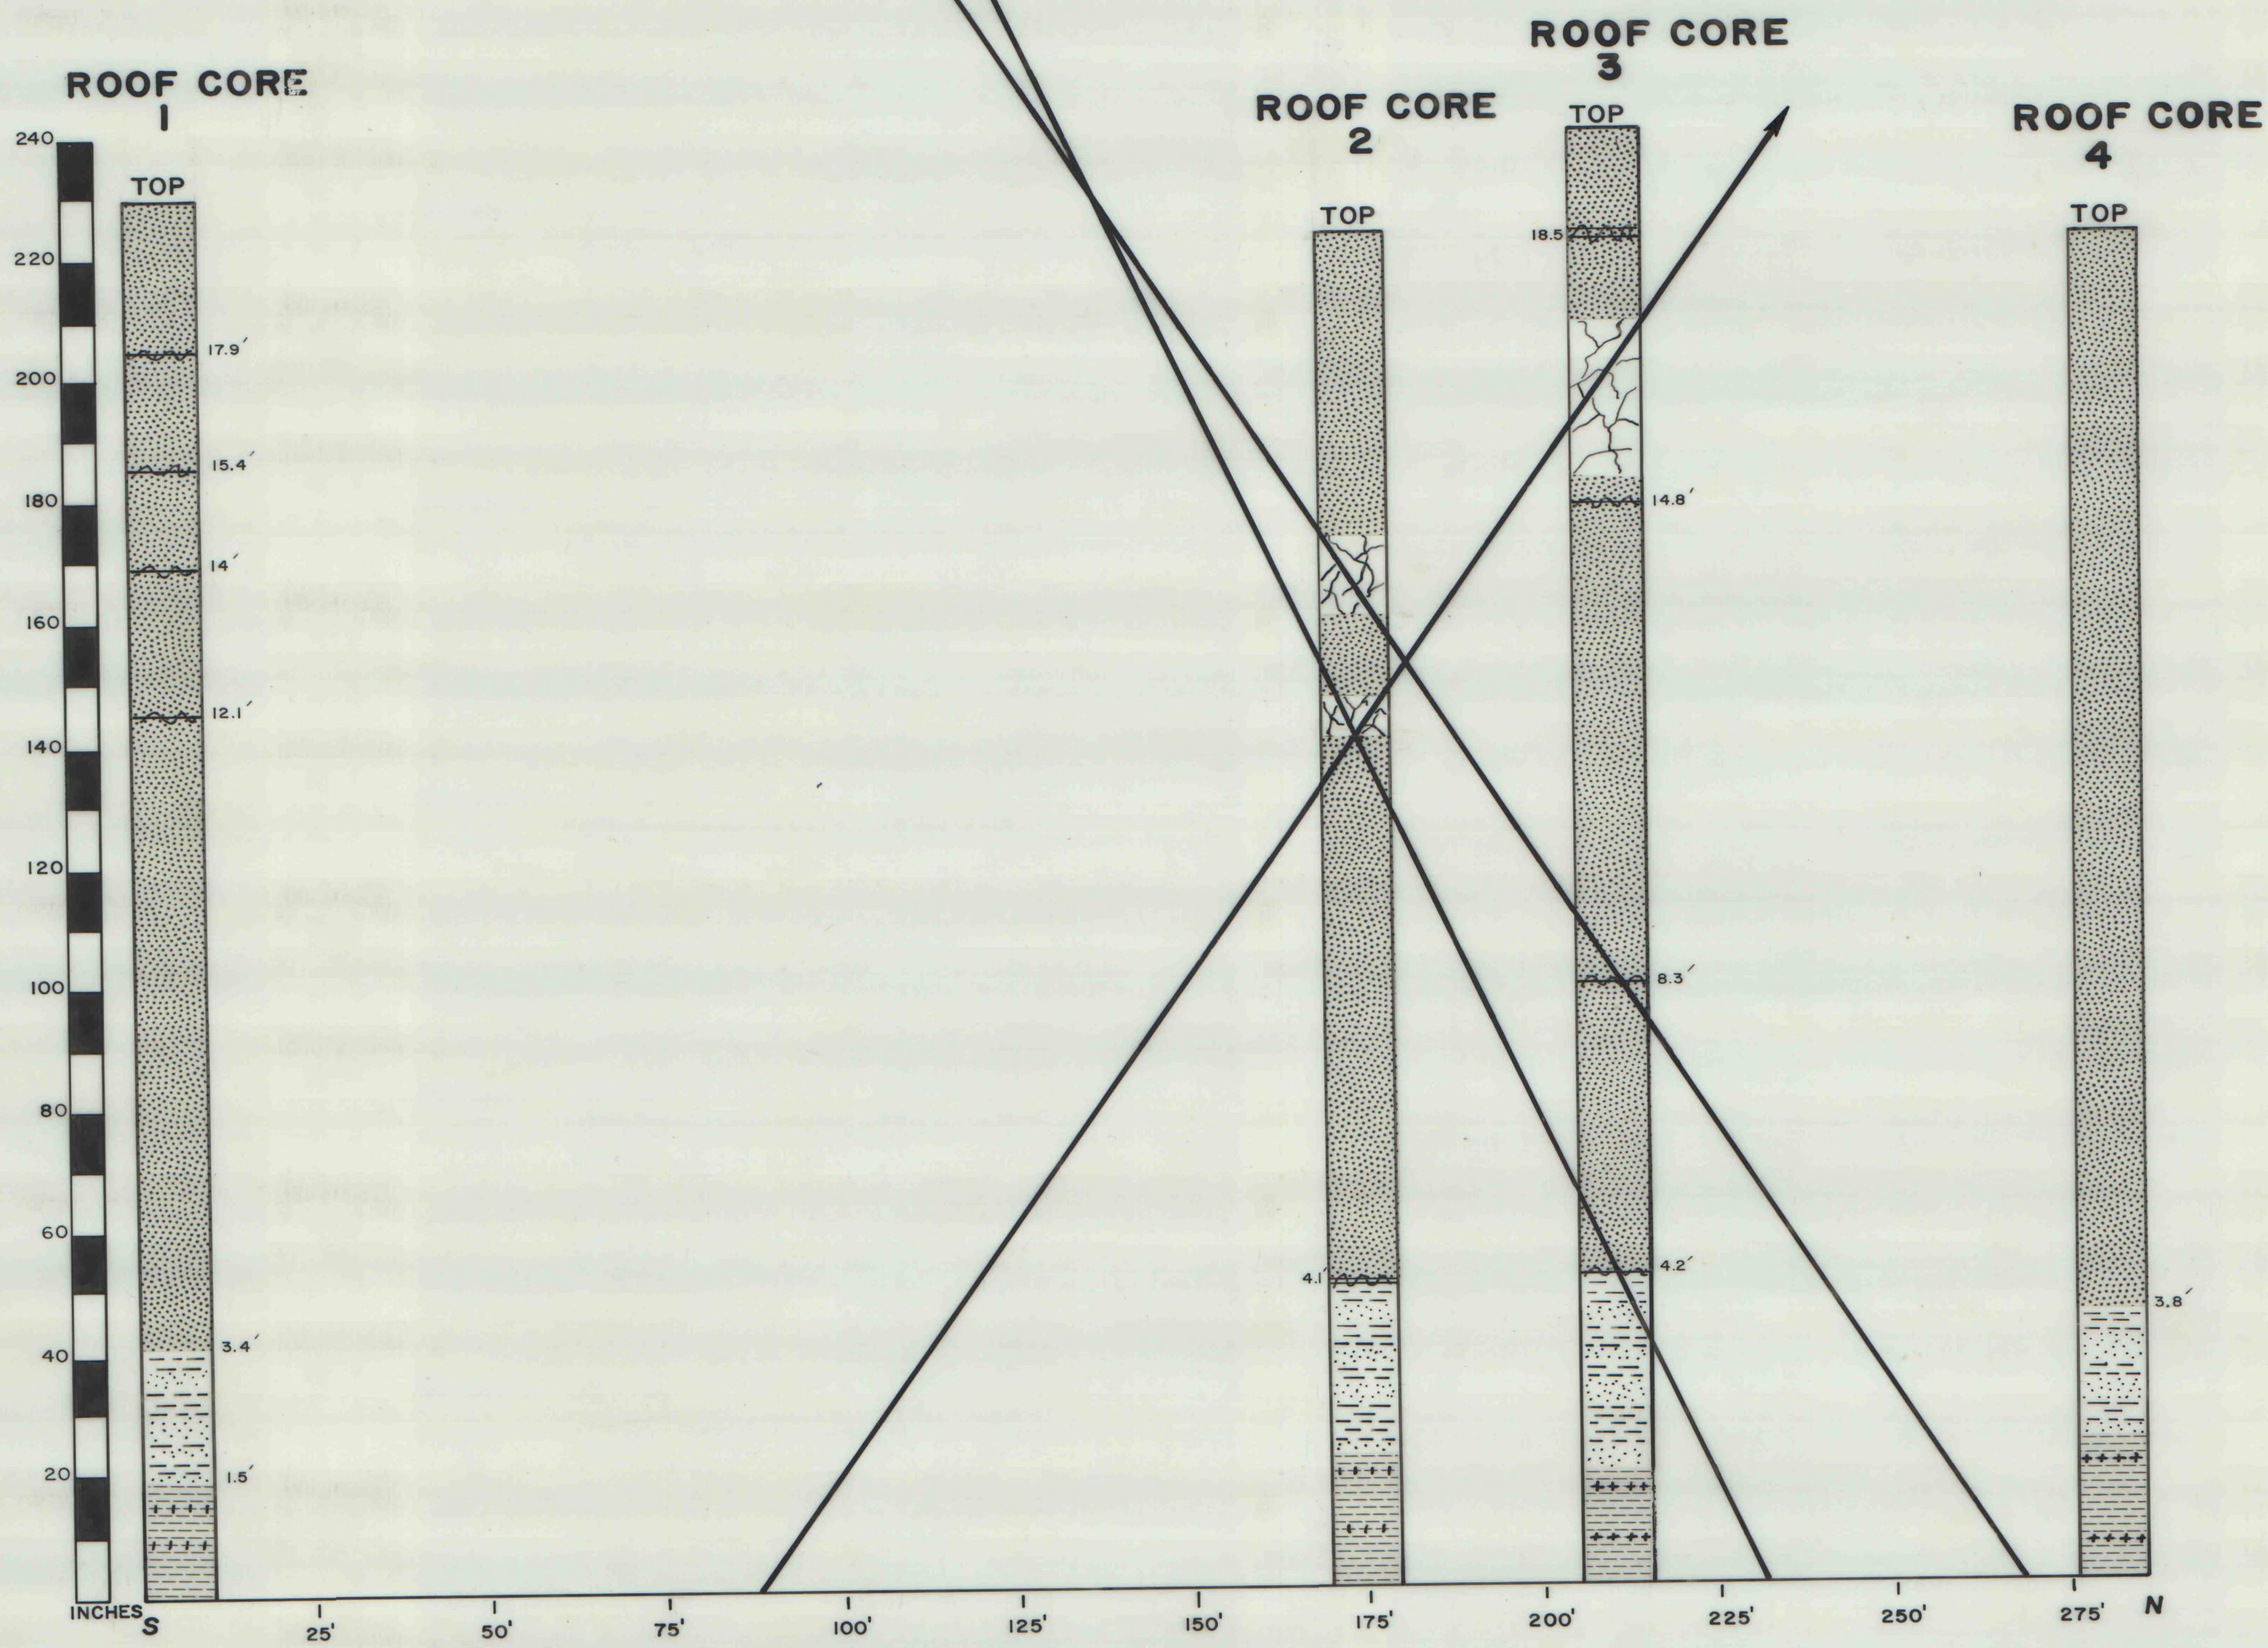

- SANDSTONE
 - SHALE
 - PYRITE
 - MUD
 - FRACTURED
 - FAULT
- VERTICAL SCALE 1:20
HORIZONTAL 1:240
← DRILL HOLE LOCATION