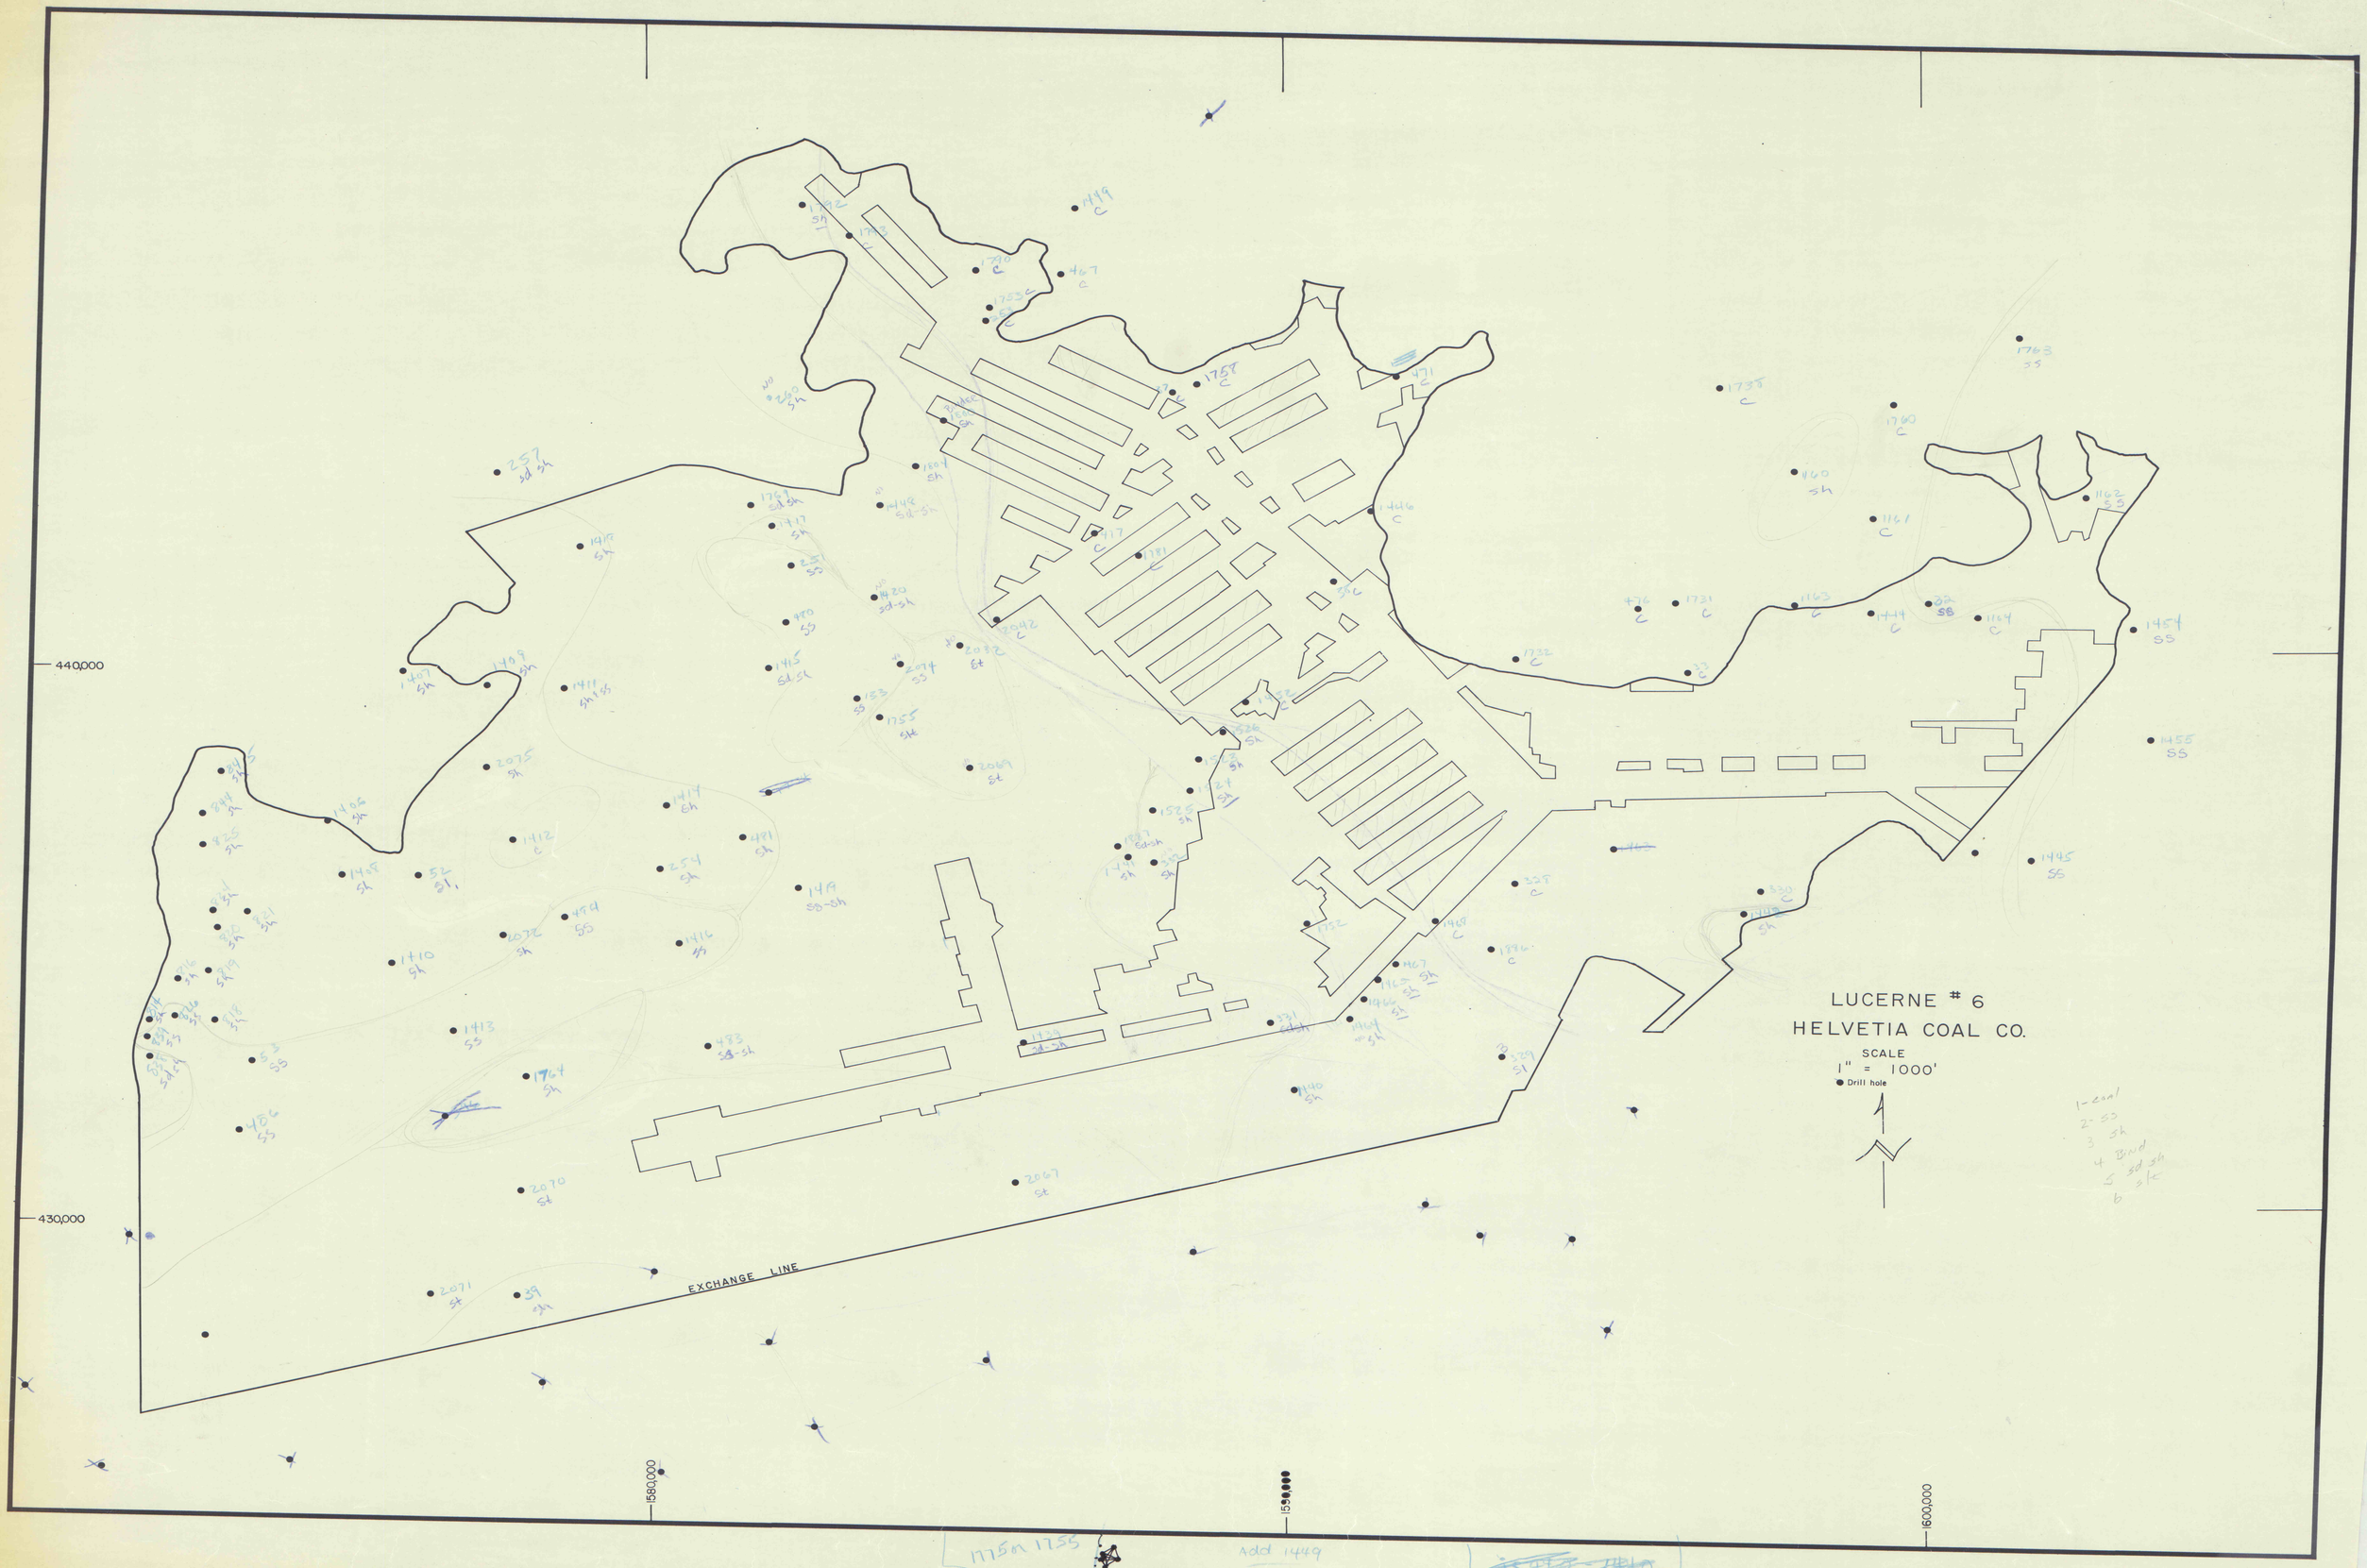

1775n 1755

Add 1449
260
257

~~15 ~~ ~~1810~~

IMAPS # 09538