


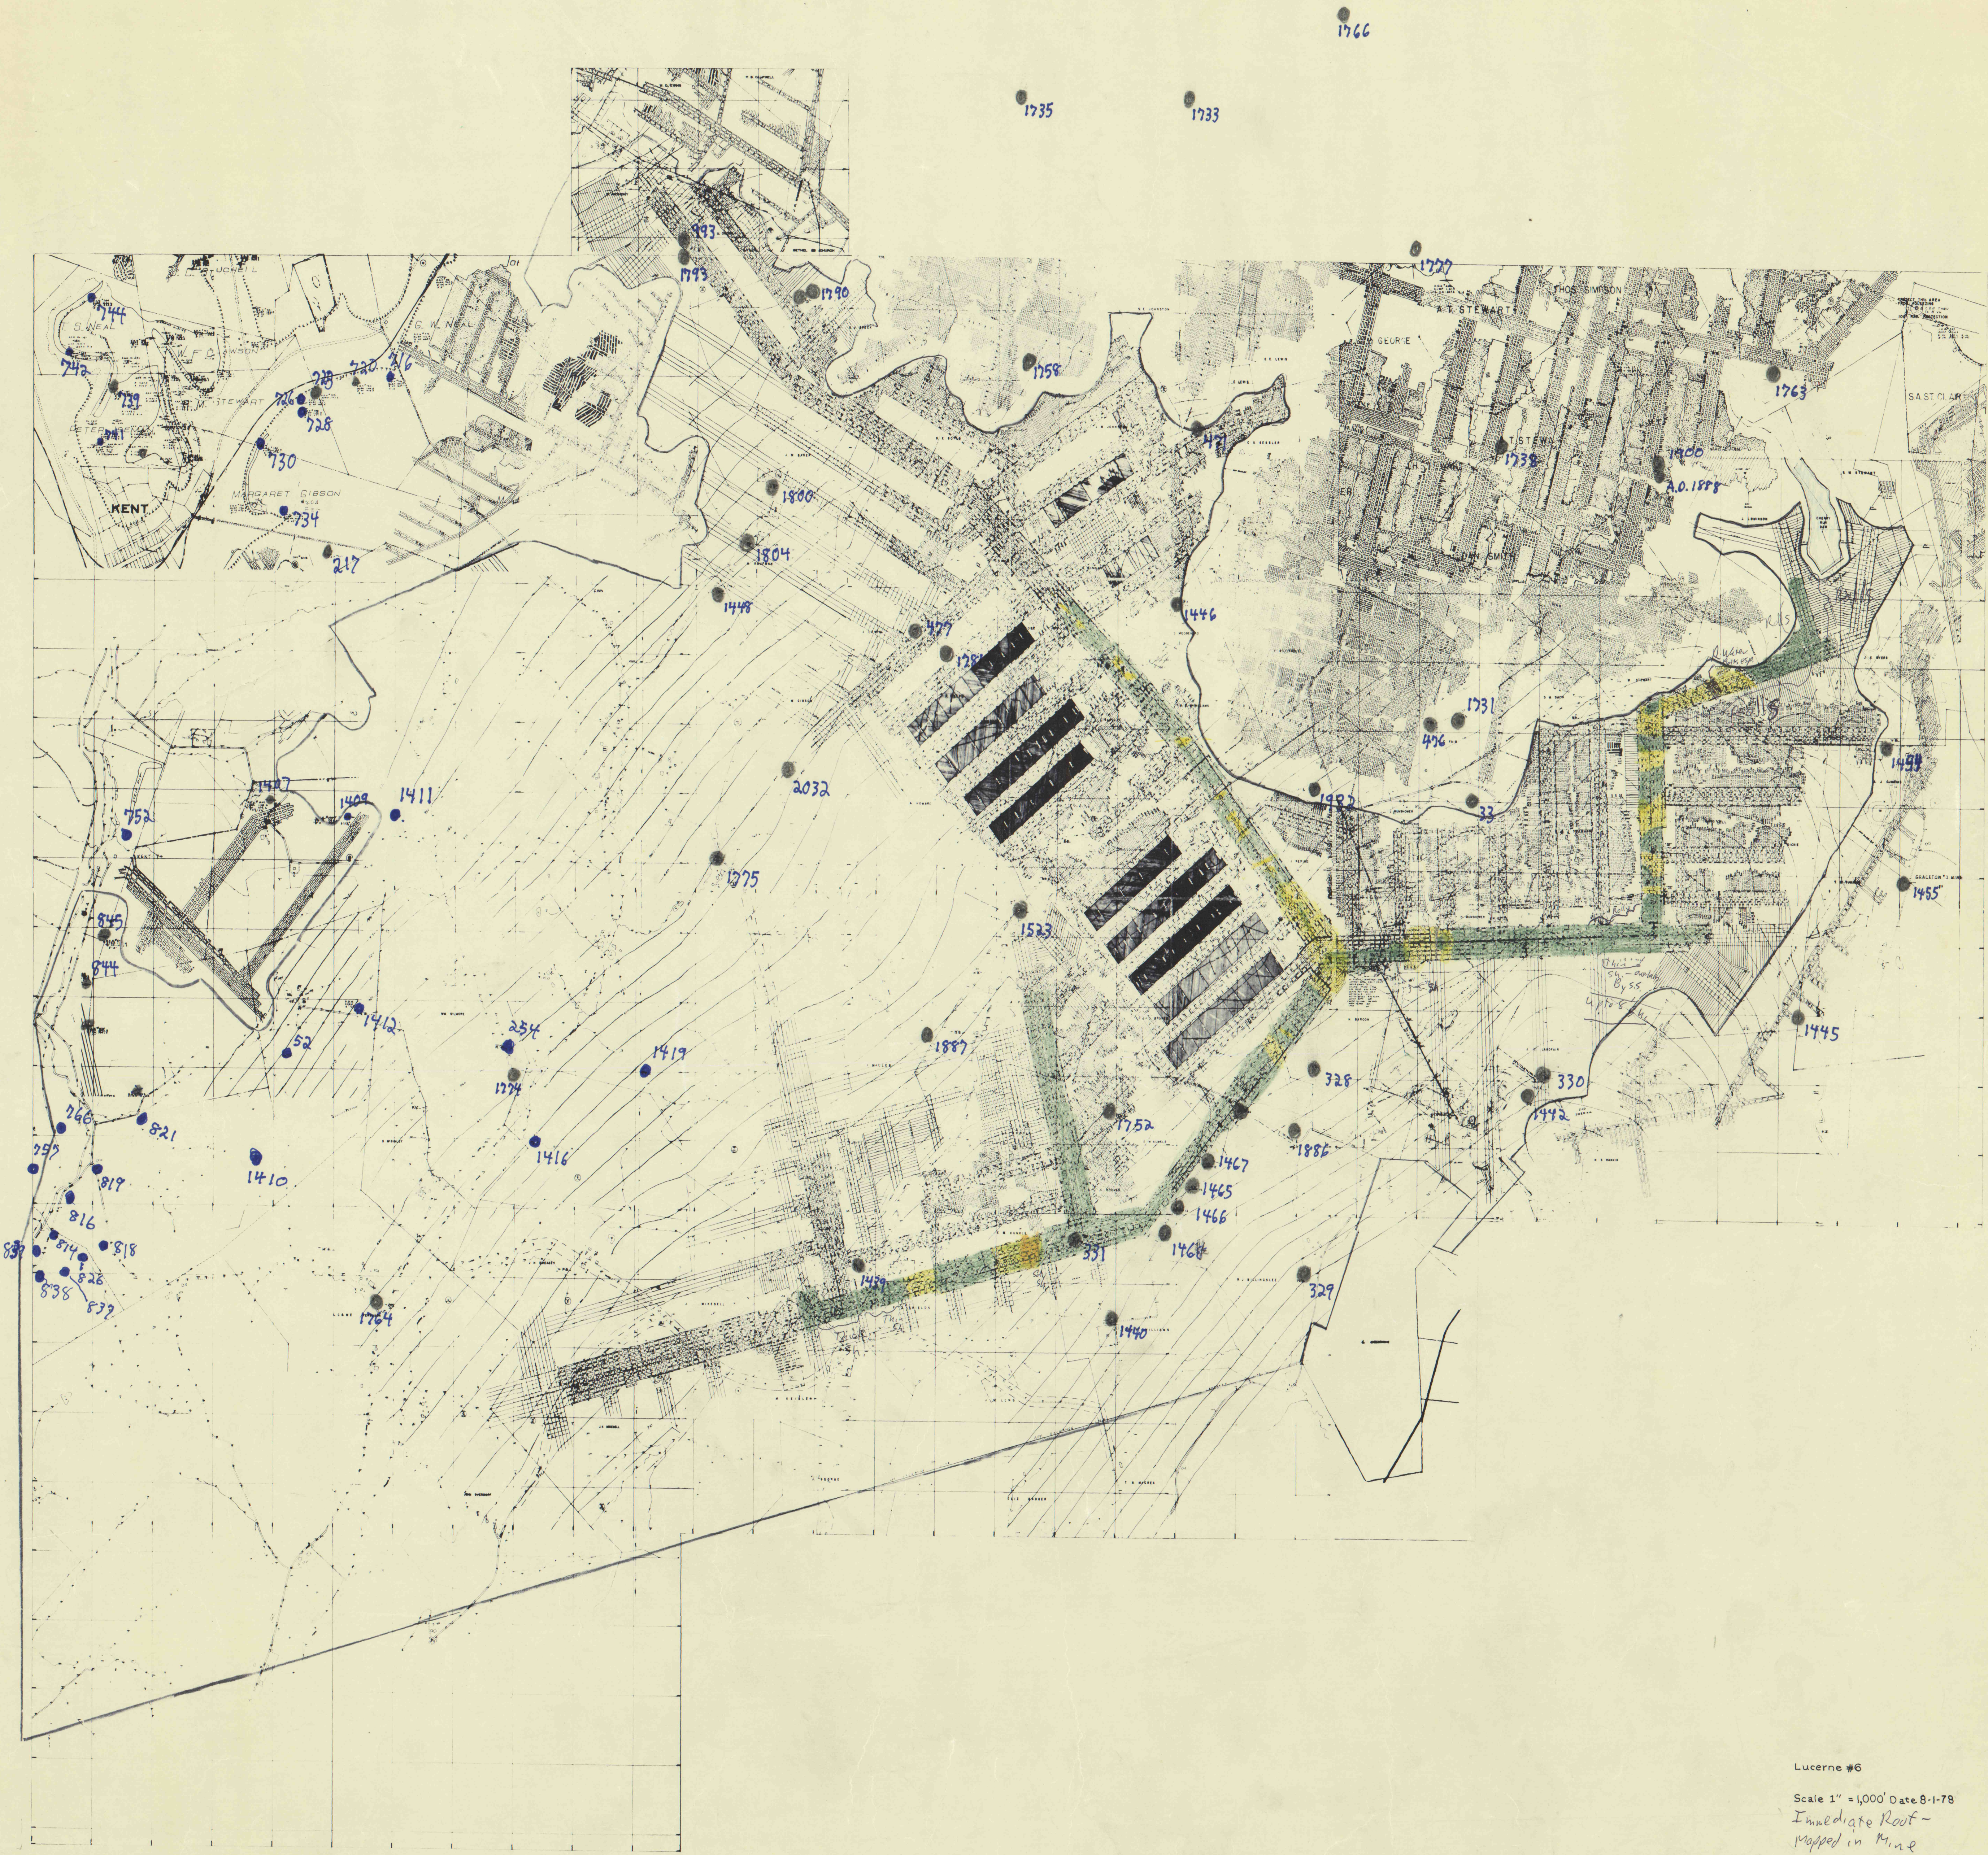

Lucerne #6
Scale 1" = 1,000' Date 8-1-78
Immediate Roof -
Mapped in Mine
● Skale
● Sandstone

IMAP# 29545