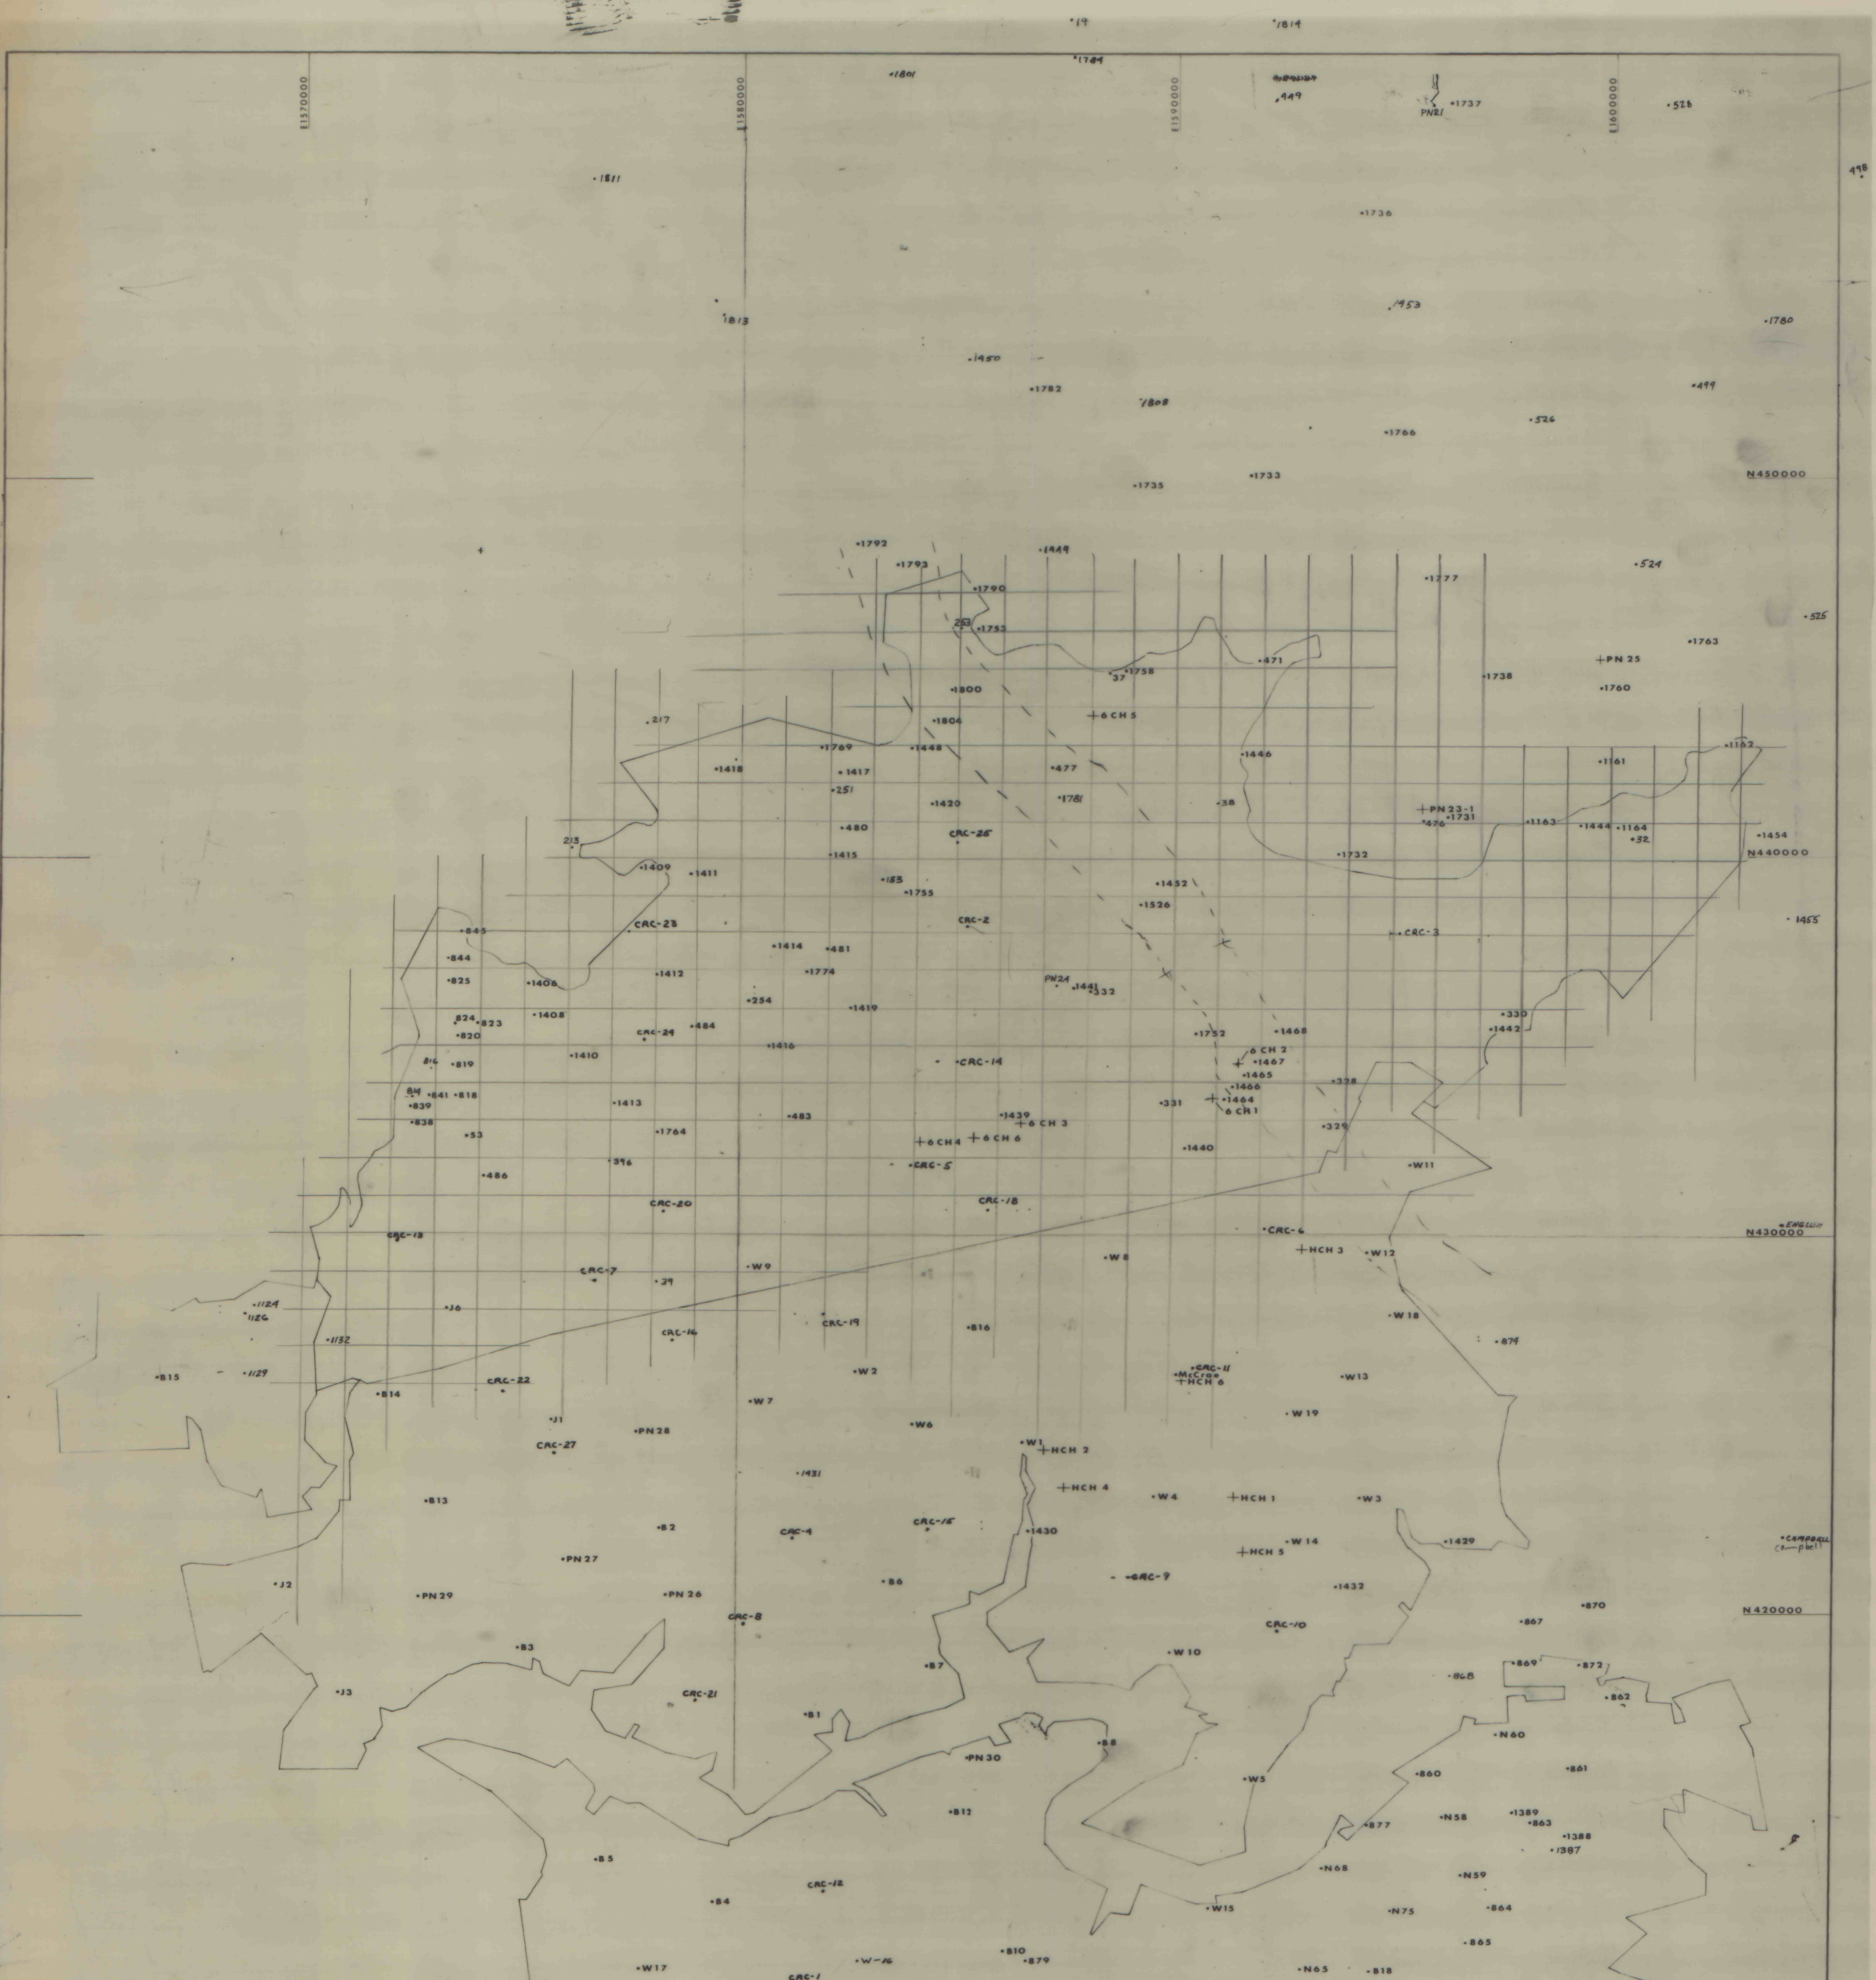

HELEN & HELVEETIA #6 MINE

HOMER CITY —— CAPTIVE RESERVES (E-SEAM)

DRILL HOLE LOCATIONS

Drill Hole Locations Based on Information from:
Coal Resources Dept., G.P.U. Service Corp. - Reading, Pa.; Eng. Dept., R&P - Indiana, Pa.; & Homer City Mine Property Map - Helen Mining Co.

Property Boundaries Taken from:
PENELEC Map (5 20 77) &
Boyd Co. Map (8 71)

· KNOWN LOCATION
+ APPROXIMATE LOCATION

Reliable Locations for the Following Holes have not been Supplied to Joseph W. Leonard:

~~32, 38, 39, 133, 251, 253~~, 631, ~~814, 816, 868, 874~~, 875, ~~1126, 1406~~, ~~1129, 1132, 1407, B9 B11 B10~~, N 71, N 72, N 73, PN 13, PN 14, & PN 16, 496, 497, 218, 298, 1783, 523, 561, 1786, 1802, 1803, 1812.

Note - These holes are not shown on this map

Pa Coordinate System

Scale: 1 in. = 2,000 ft.

BASE MAP IA

UPDATED 2-15-80 JJF
UPDATED 10-8-79 J.J.P.
1/26/78 D.J.A.

IMAPS # 09555