


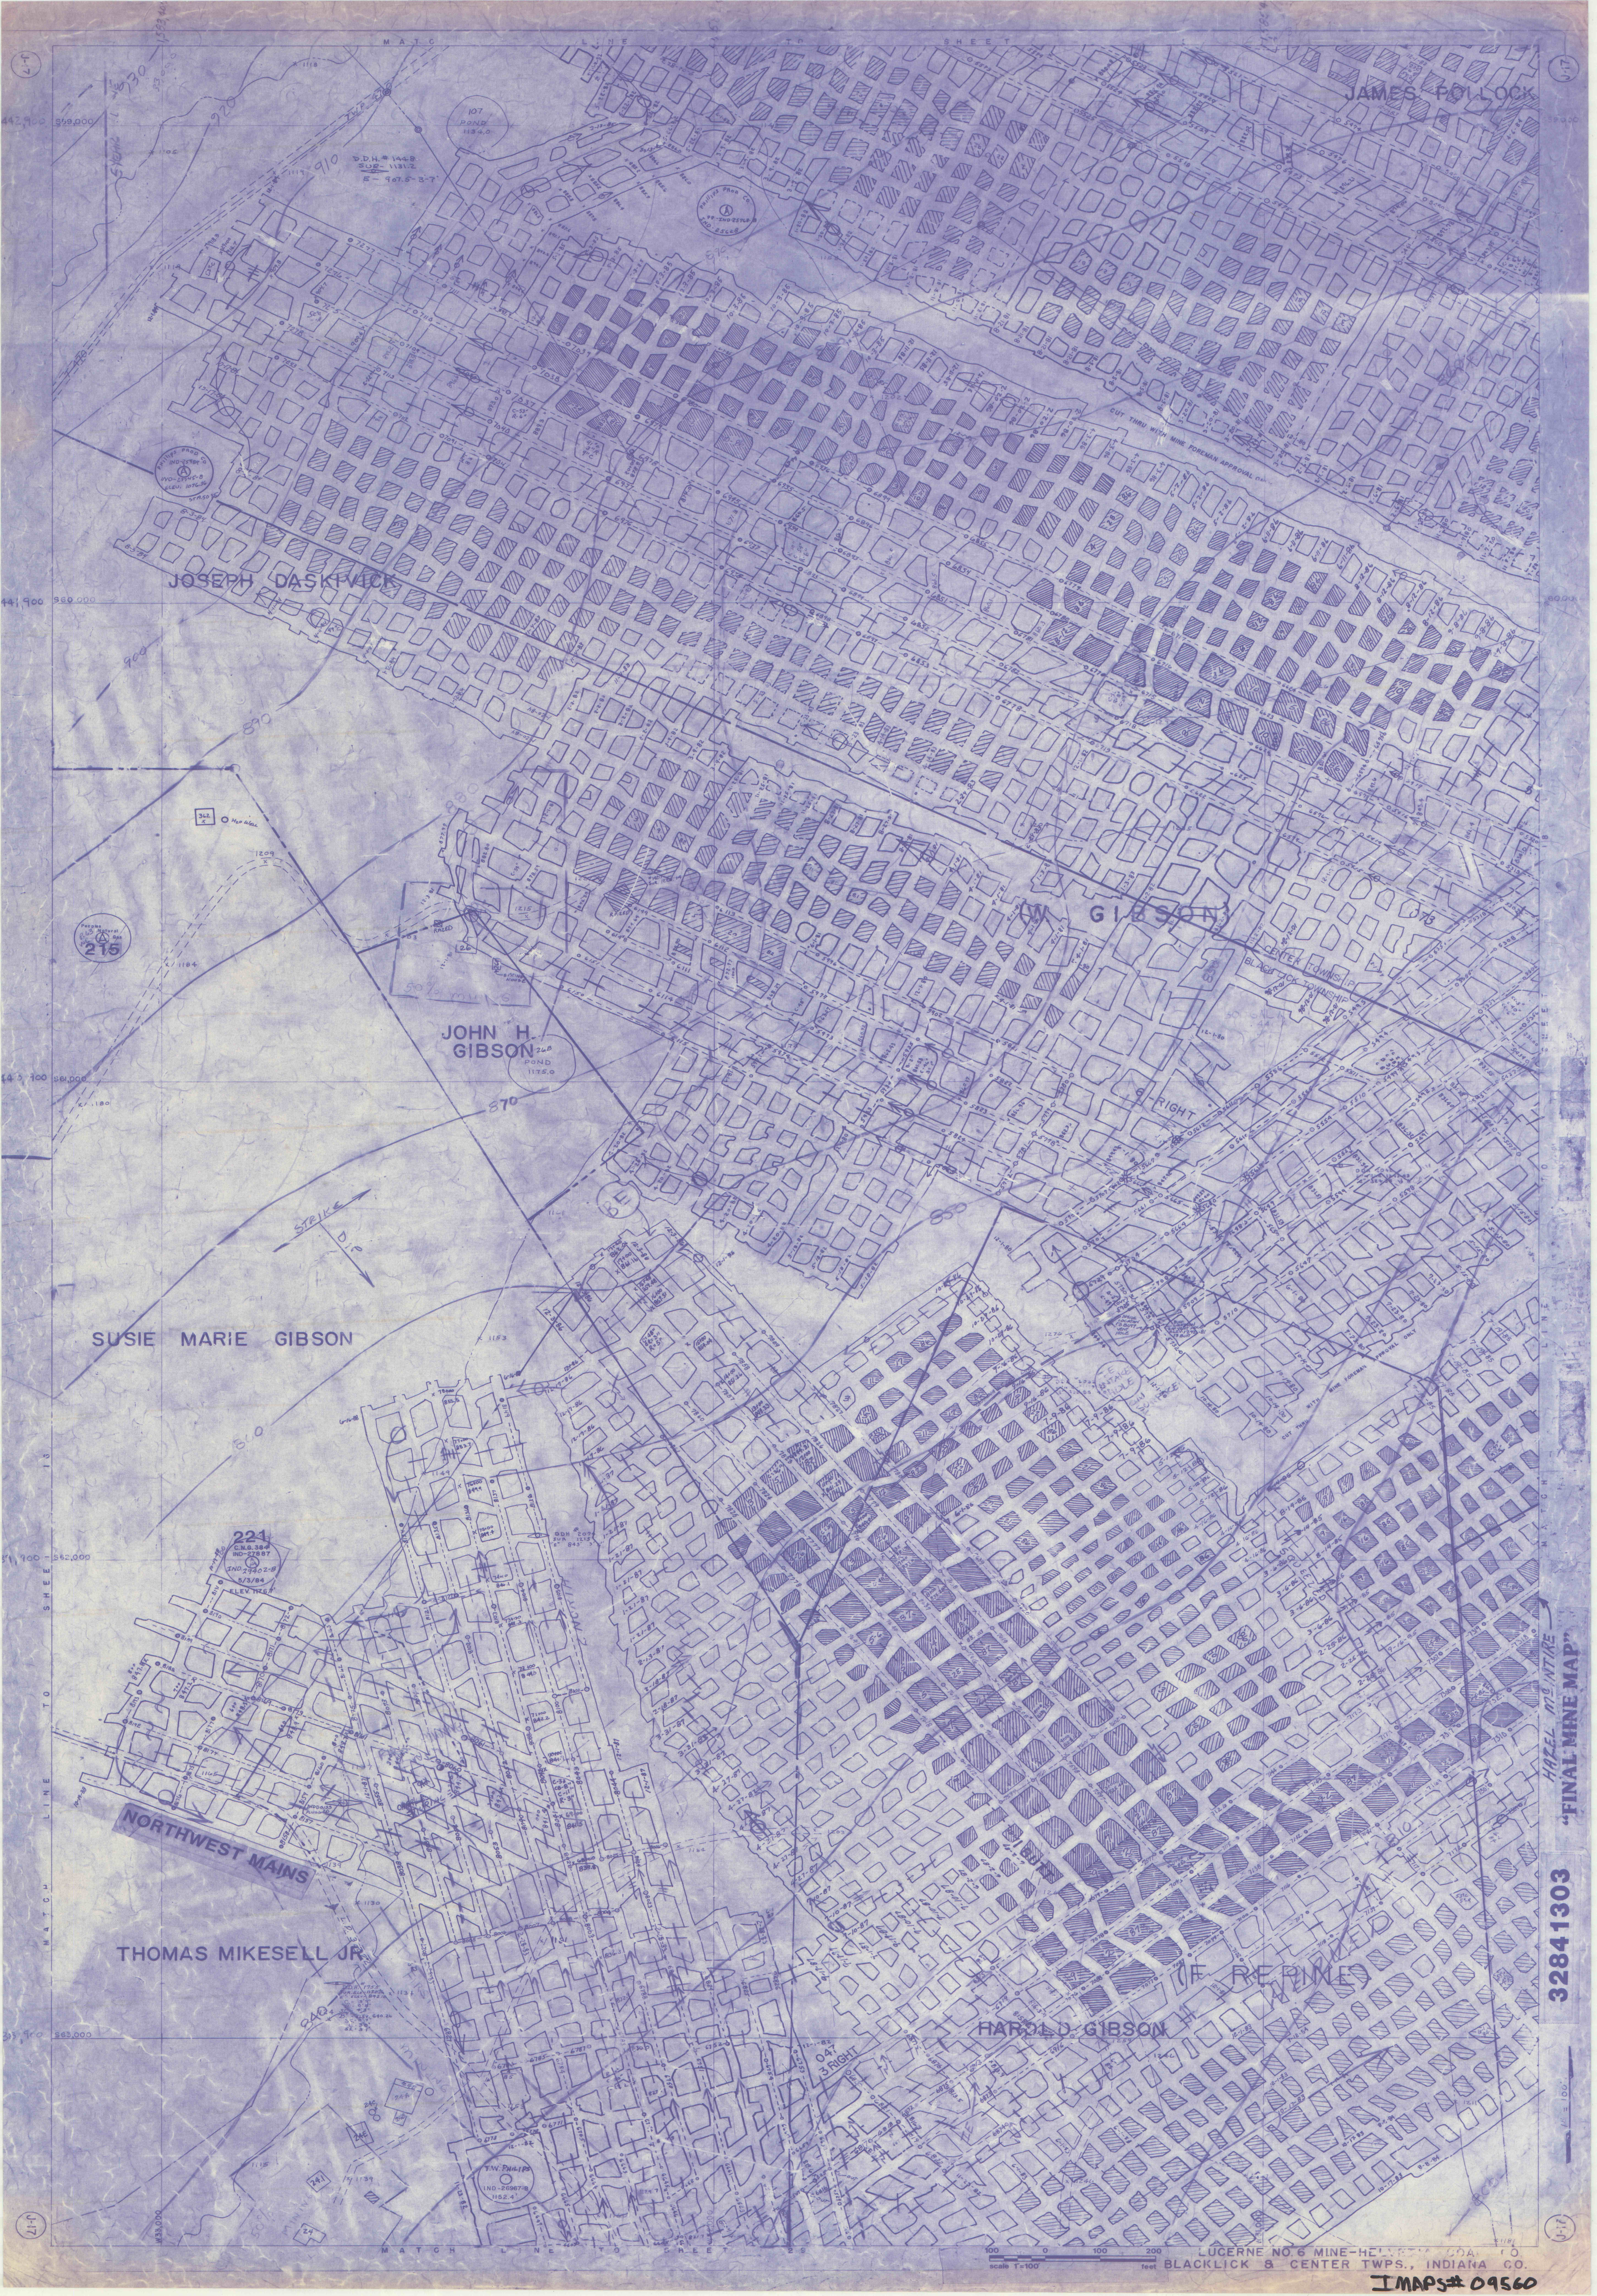

JAMES POLLOCK

JOSEPH DASKWICK

JOHN H. GIBSON
POND

SUSIE MARIE GIBSON

NORTHWEST MAINS

THOMAS MIKESELL JR.

W. GIBSON

HAROLD GIBSON

REFINED

HAZEL MCINTIRE
"FINAL MINE MAP"

32841303

BLACKICK & CENTER TOWNS, INDIANA CO.
IMAPS# 09560