


J-28

J-28

J-28

J-28

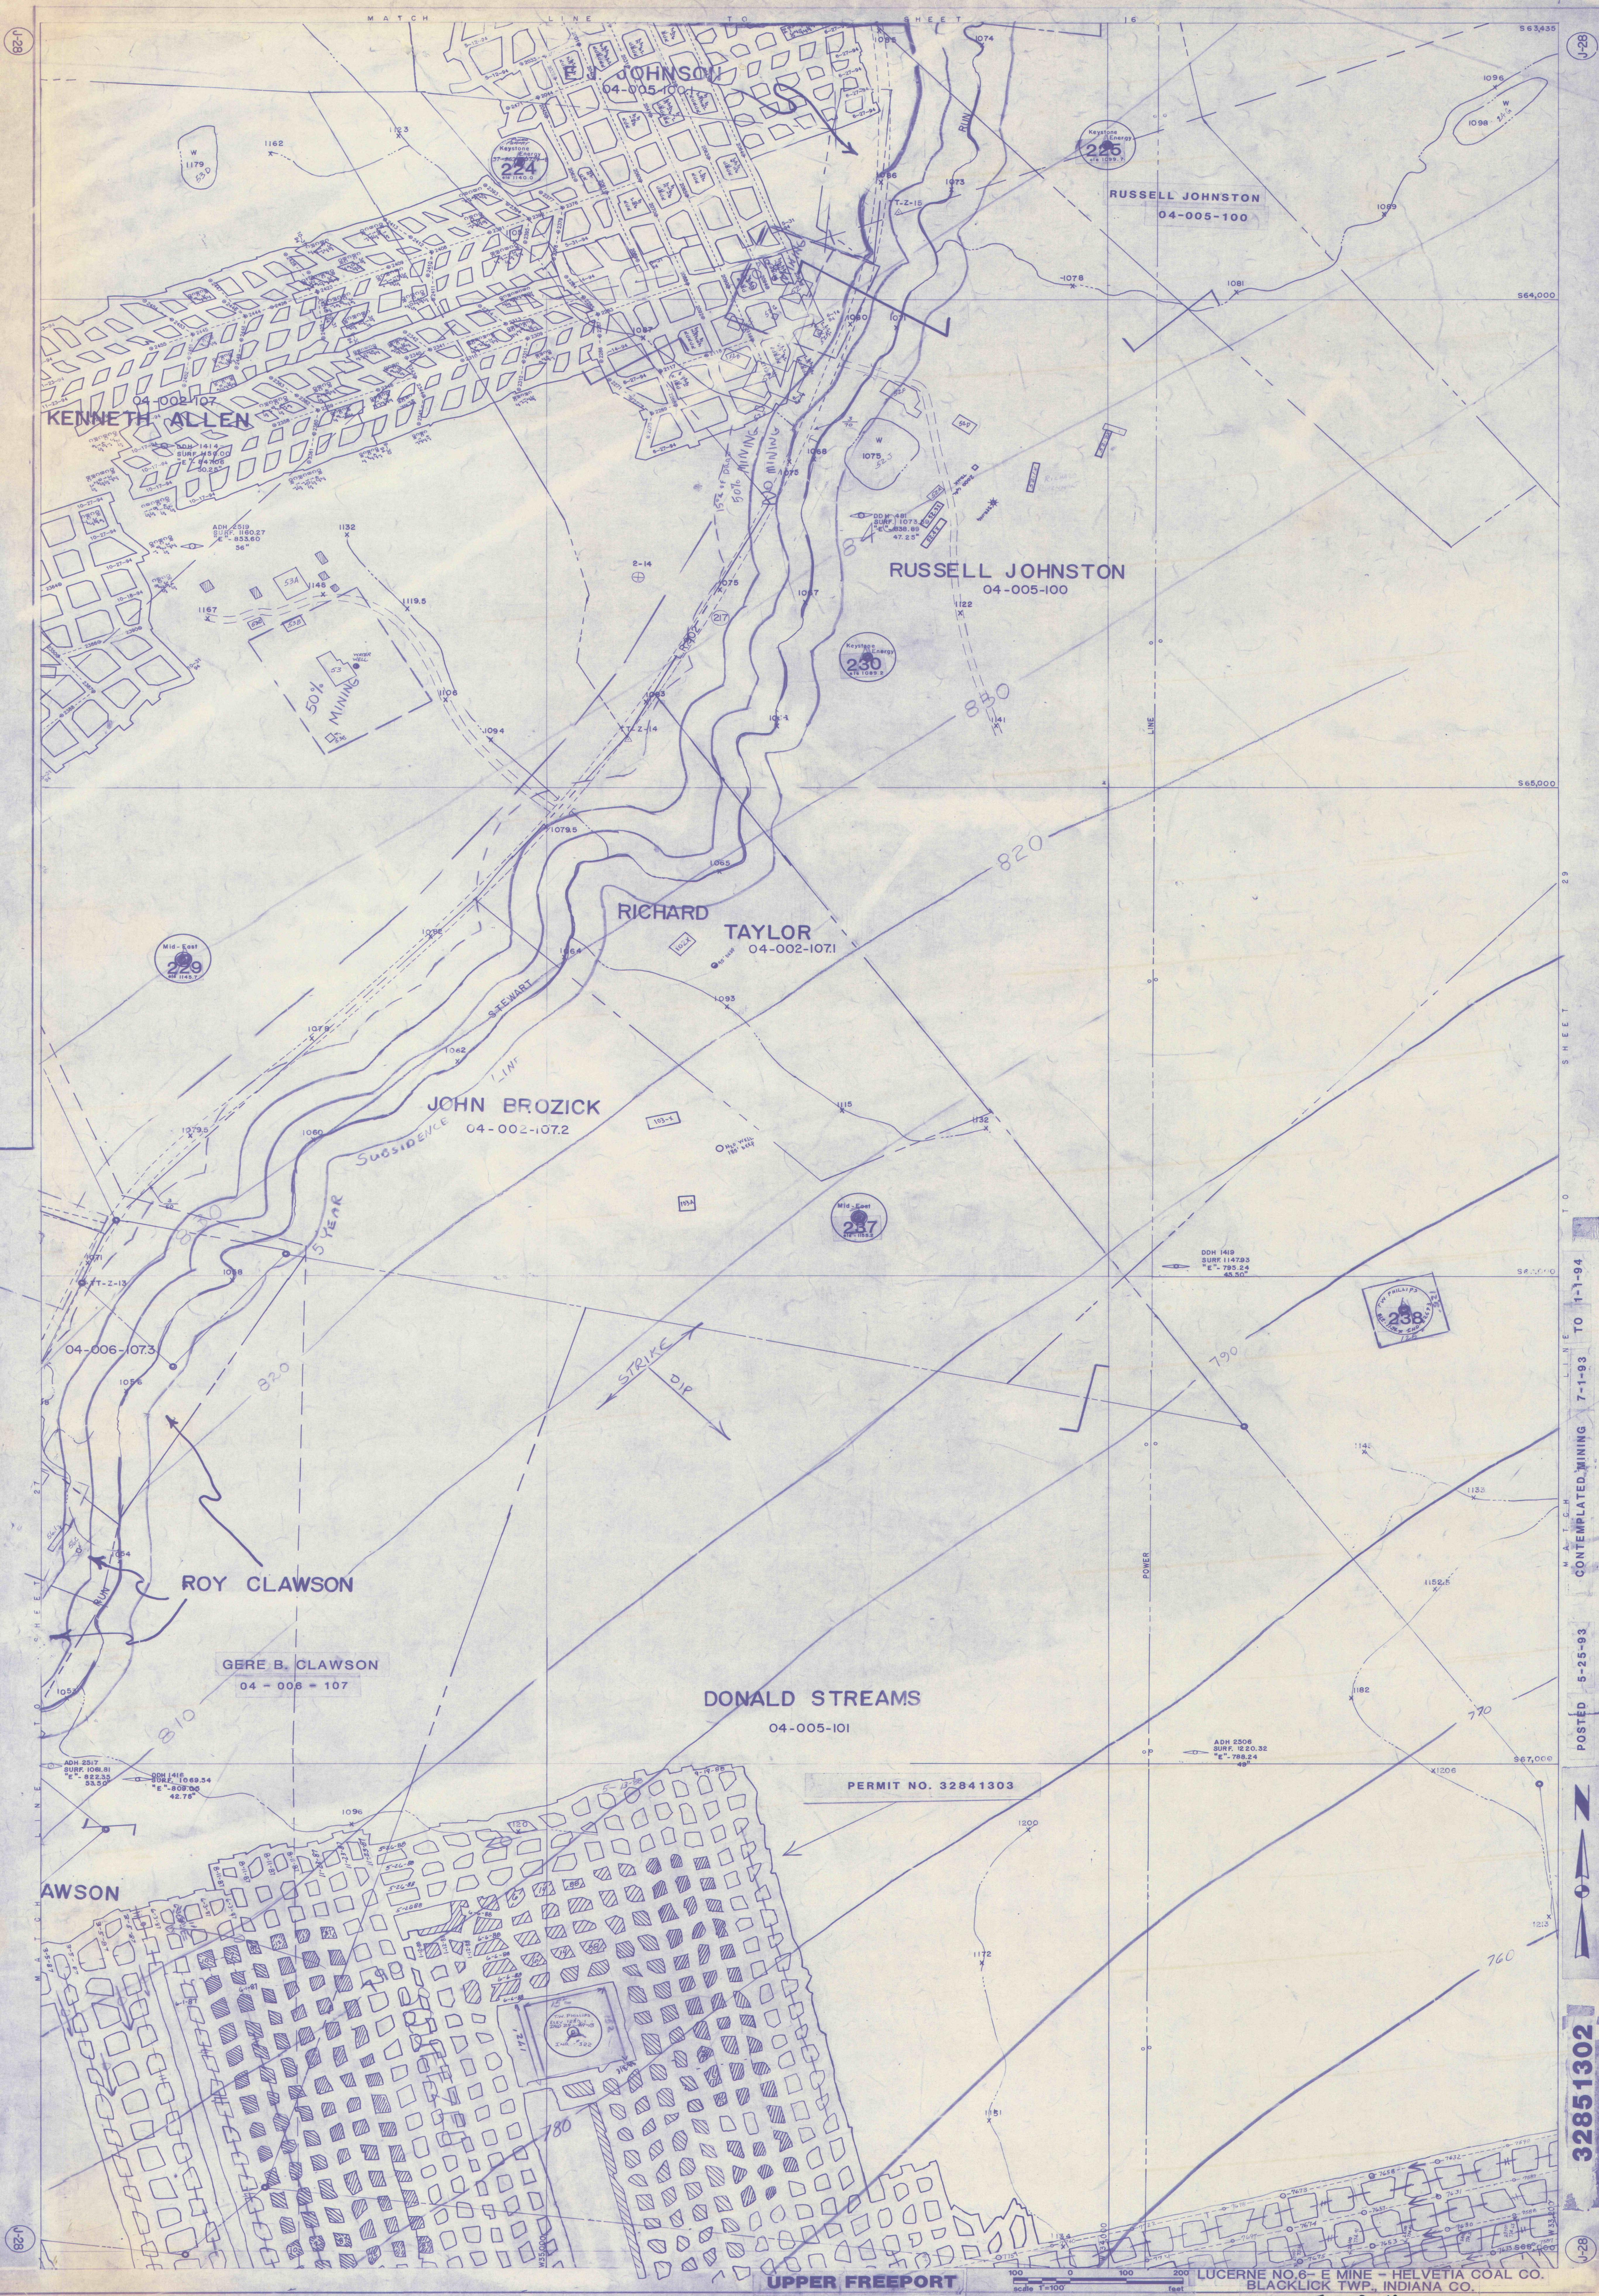

CONTEMPLATED MINING 7-1-93 TO 1-1-94

POSTED 5-25-93

32851302

UPPER FREEPORT

LUCERNE NO. 6 - E MINE - HELVETIA COAL CO. BLACKLICK TWP., INDIANA CO.

I MAPS# 09568