


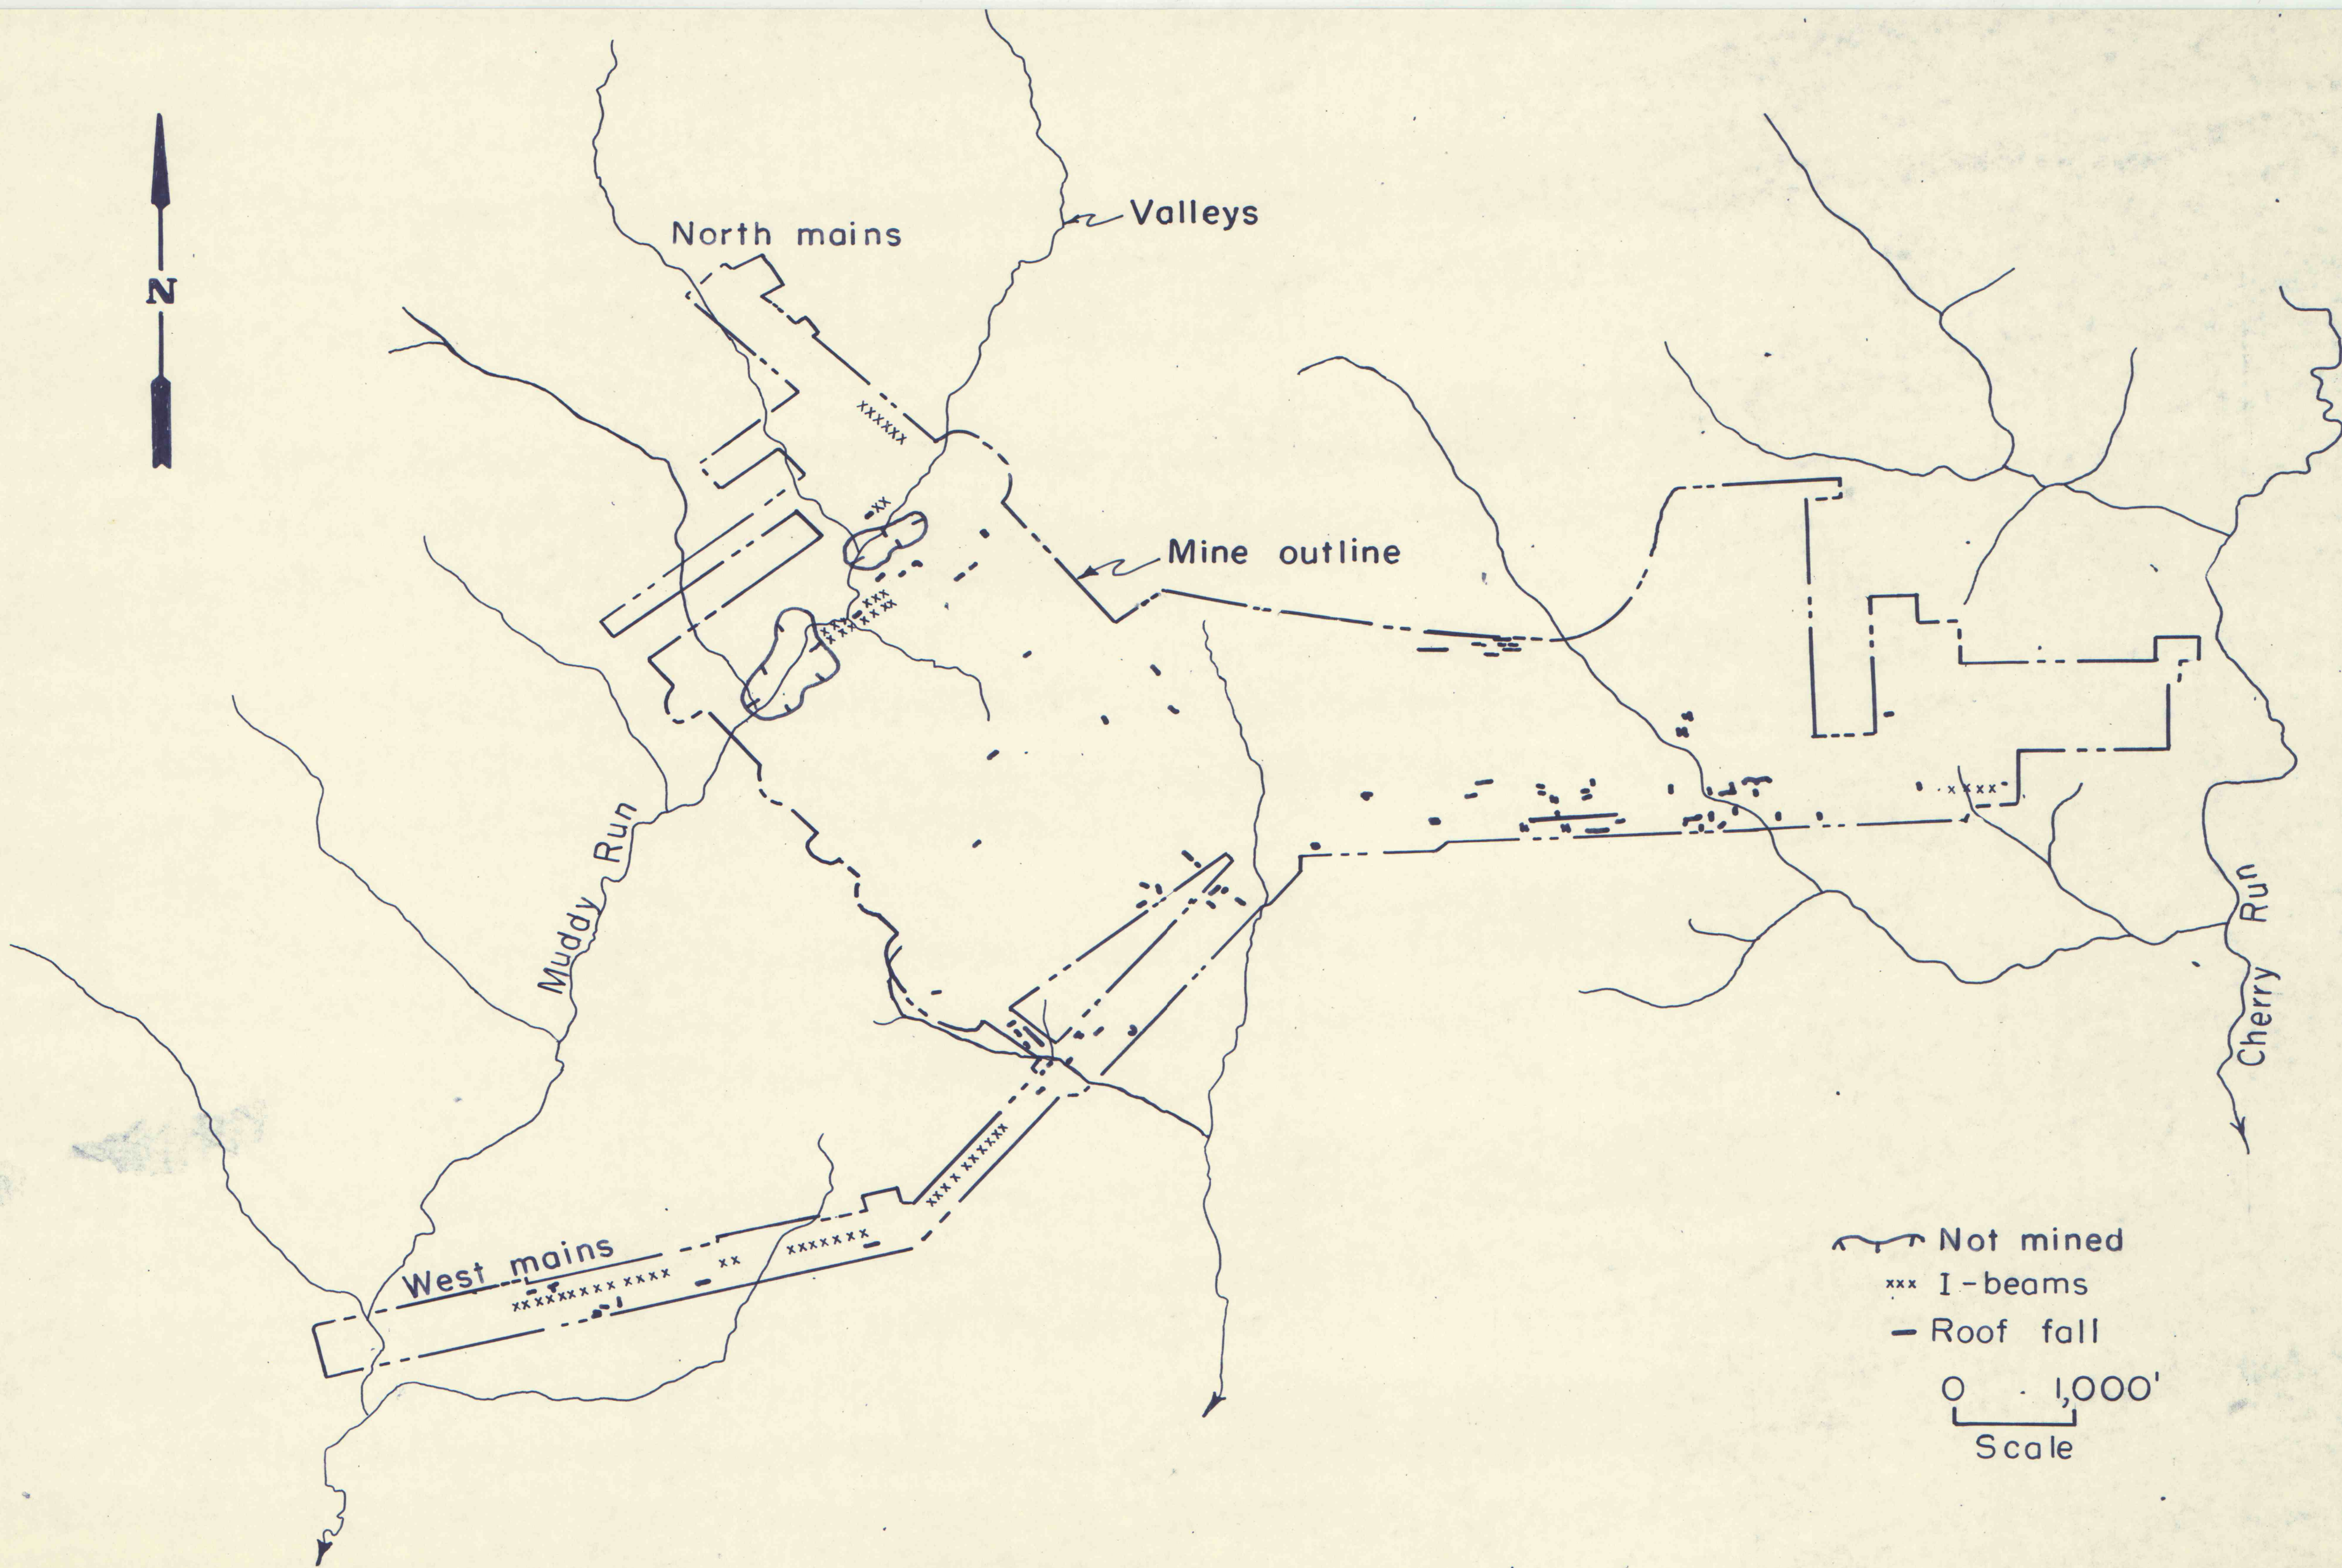

Roof falls R & P Coal Co. - Lucerne # 6 Mine, Indiana County, Pa.

B-5826

IMAPS# 09581