


IN BOOK
NOT ON MAP

194
788
848
1057
1124 Blau
1126
1129 Blau

1650
1655
1872 Claugess
2963 Blau
1875 Blau
2360
2499
2601
2602
2799
2949 (Saltburg)

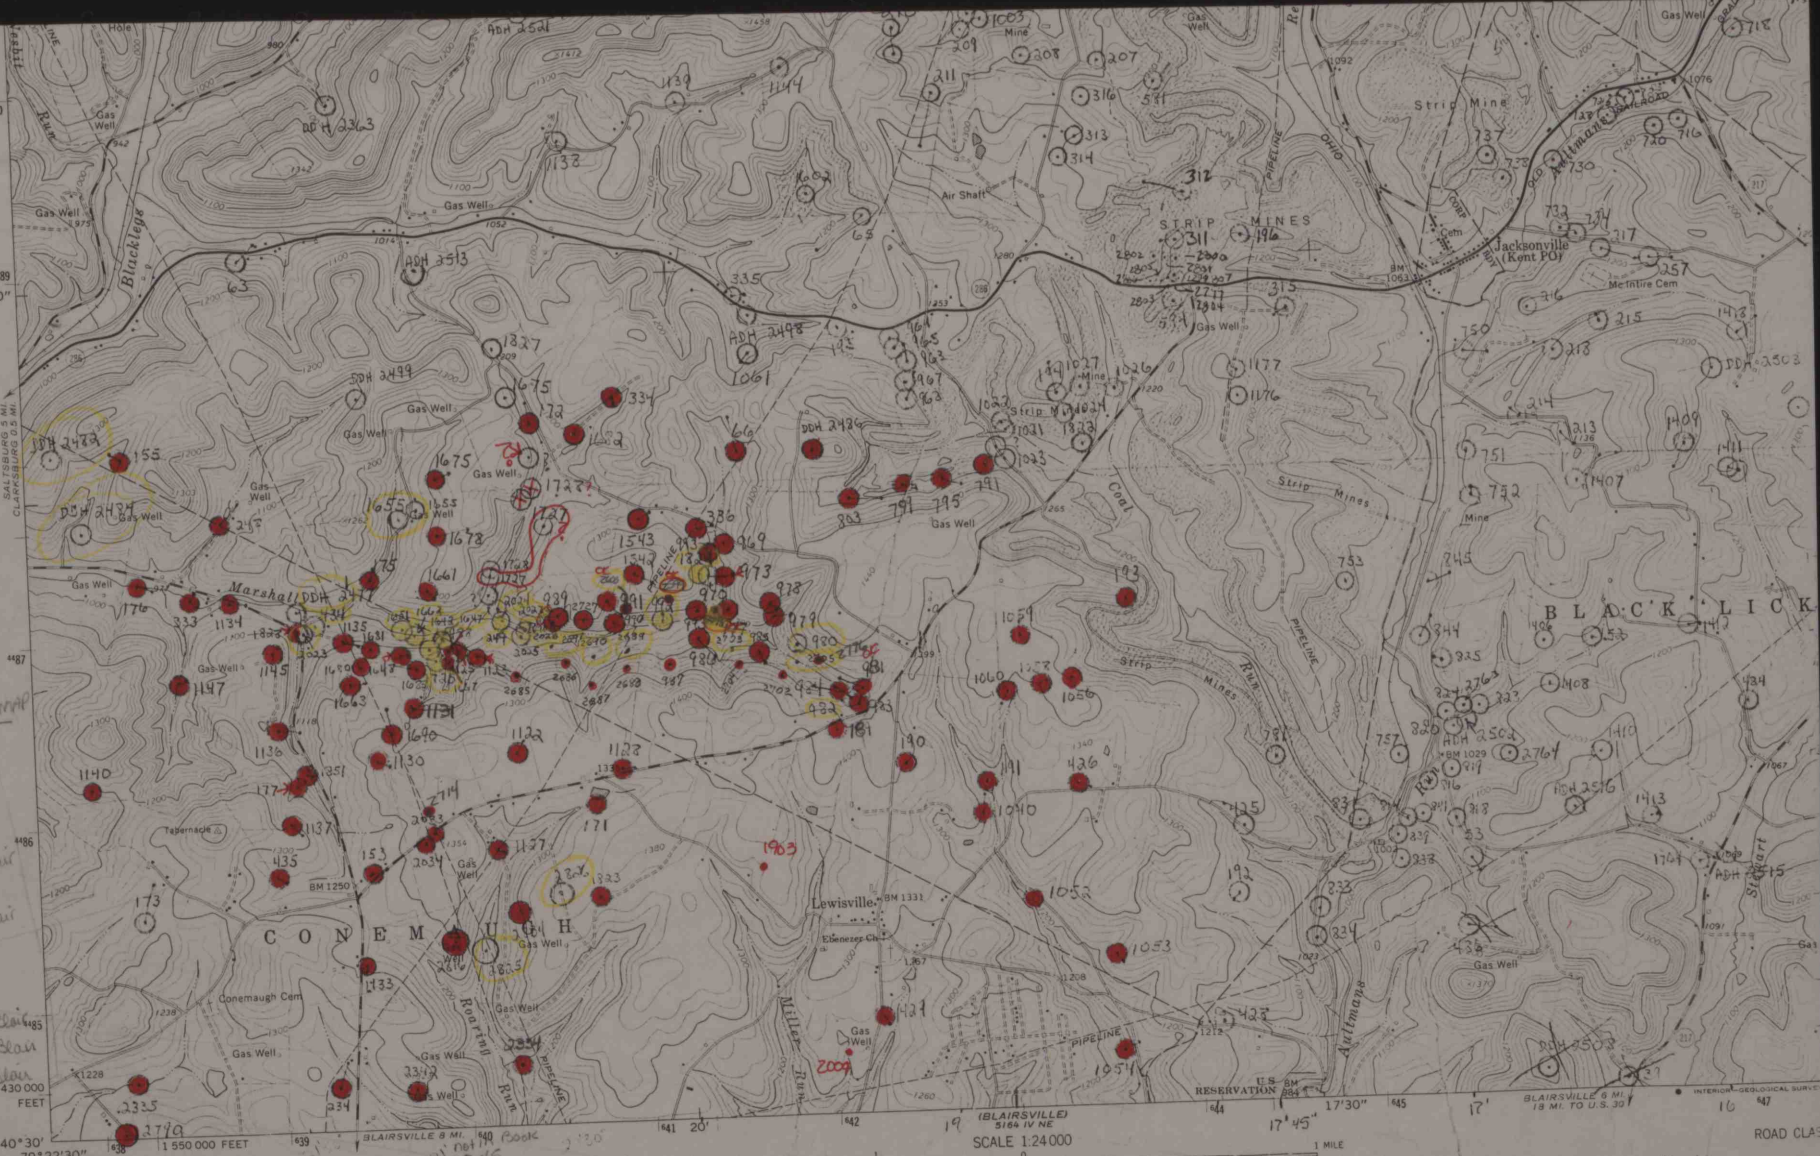

Mapped, edited, and published by the Geological Survey
Control by USGS, USC&GS, and USCE
Topography by photogrammetric methods from aerial
photographs taken 1962 and 1963. Field checked 1964
Geologic projection, 1927 North American datum

SCALE 1:24,000
1 1000 0 1000 2000 3000 4000 5000 6000 7000 FEET
DIAMOND DRILL HOLE MAP

IMAPS # 09606

ROAD CLASS
Heavy-duty
Medium-duty
Star