


UNITED STATES
DEPARTMENT OF THE INTERIOR
GEOLOGICAL SURVEY

STATE OF PENNSYLVANIA
DEPARTMENT OF INTERNAL AFFAIRS
TOPOGRAPHIC AND GEOLOGIC SURVEY

MCINTYRE QUADRANGLE
PENNSYLVANIA
7.5 MINUTE SERIES (TOPOGRAPHIC)
SE 1/4 ELDERS RIDGE 19 QUADRANGLE

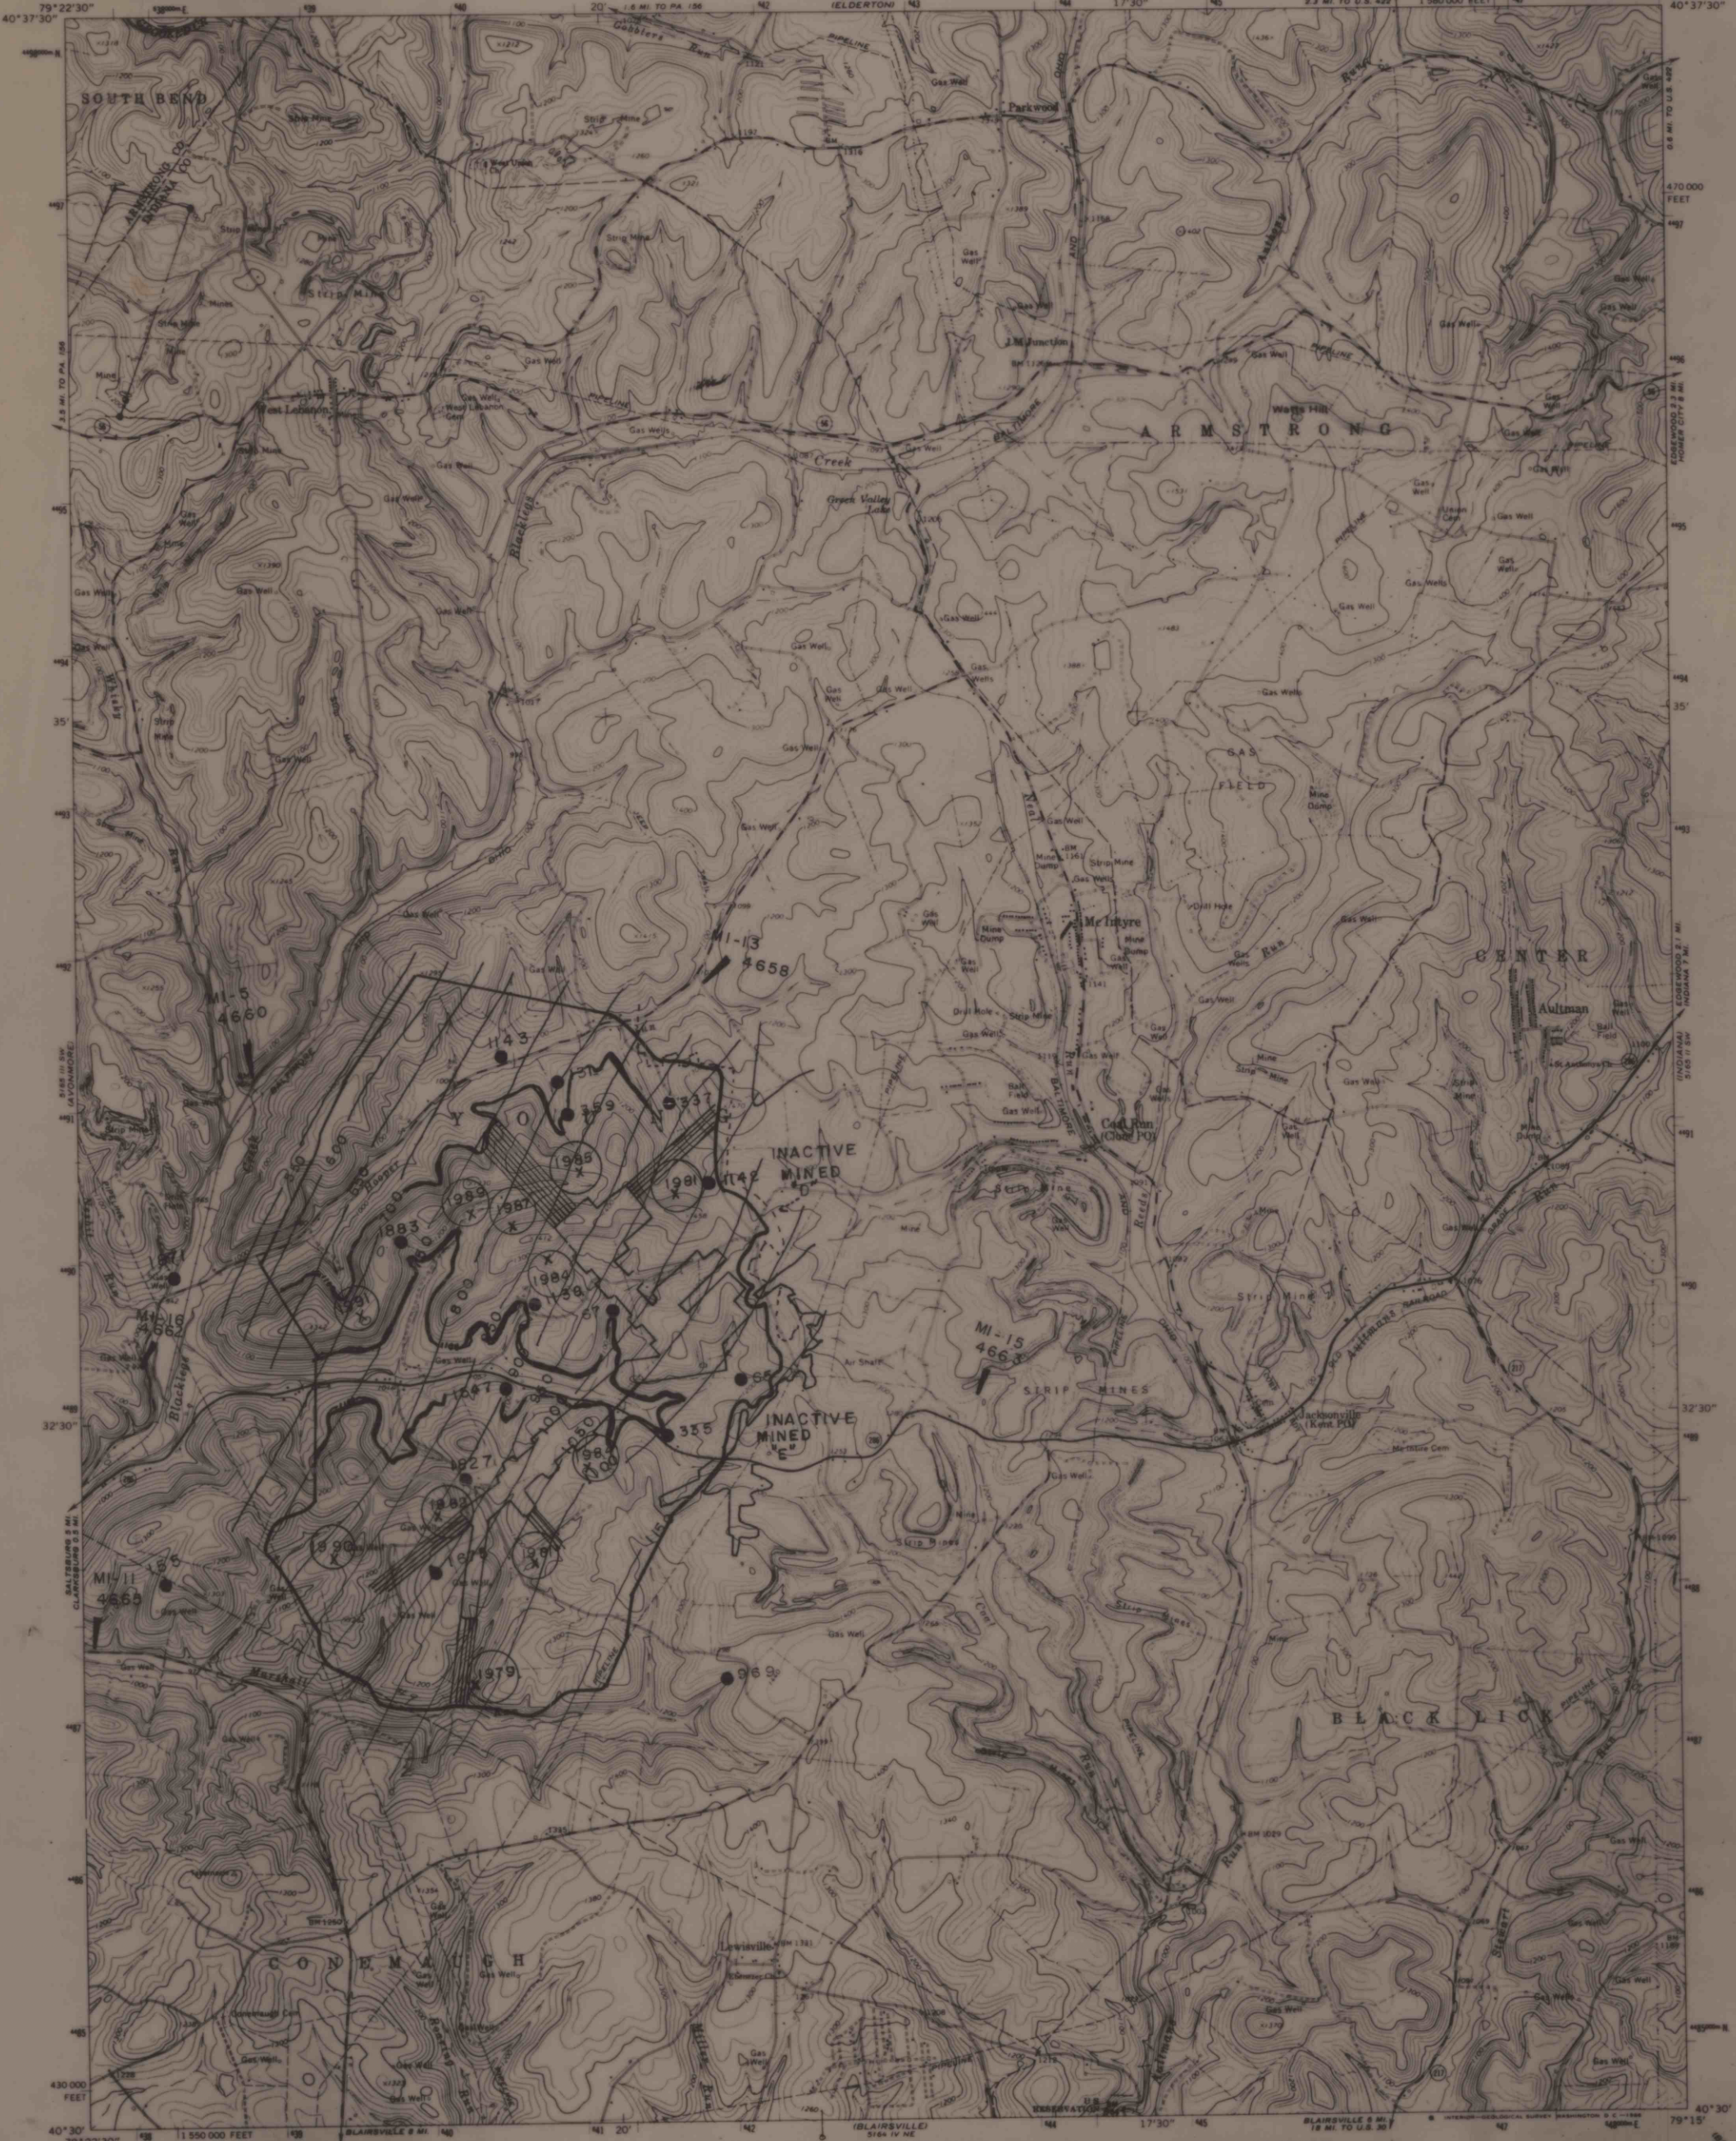


Mapped, edited, and published by the Geological Survey
Control by USGS, USACGS, and USCE

Topography by photogrammetric methods from aerial
photographs taken 1962 and 1963. Field checked 1964

Polyconic projection. 1927 North American datum
10,000-foot grid based on Pennsylvania coordinate system, south zone
1000-meter Universal Transverse Mercator grid ticks,
zone 17, shown in blue

Fine red dashed lines indicate selected force and field lines where
generally visible on aerial photographs. This information is unchecked
U.S. Reservation boundary from maps by U.S. Corps of Engineers
Area covered by dashed light-blue pattern is subject to controlled
inundation 975 feet by Conemaugh Dam

UTM GRID AND 1984 MAGNETIC NORTH
DECLINATION AT CENTER OF SHEET

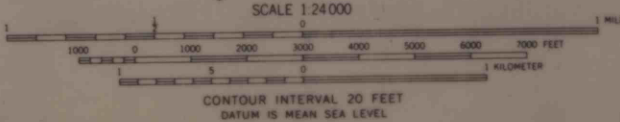

THIS MAP COMPLIES WITH NATIONAL MAP ACCURACY STANDARDS
FOR SALE BY U.S. GEOLOGICAL SURVEY, WASHINGTON, D.C. 20242
A FOLDER DESCRIBING TOPOGRAPHIC MAPS AND SYMBOLS IS AVAILABLE ON REQUEST

STERILIZATION
LUCERNE #8 MINE


ROAD CLASSIFICATION

Heavy-duty

Medium-duty

Unimproved dirt

State Route

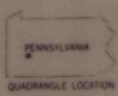

MCINTYRE, PA.
SE 1/4 ELDERS RIDGE 19 QUADRANGLE
N4030-W7915/7.5

1964

AMS 5165 III SE-SERIES, XXXI

IMAPS # 09612