


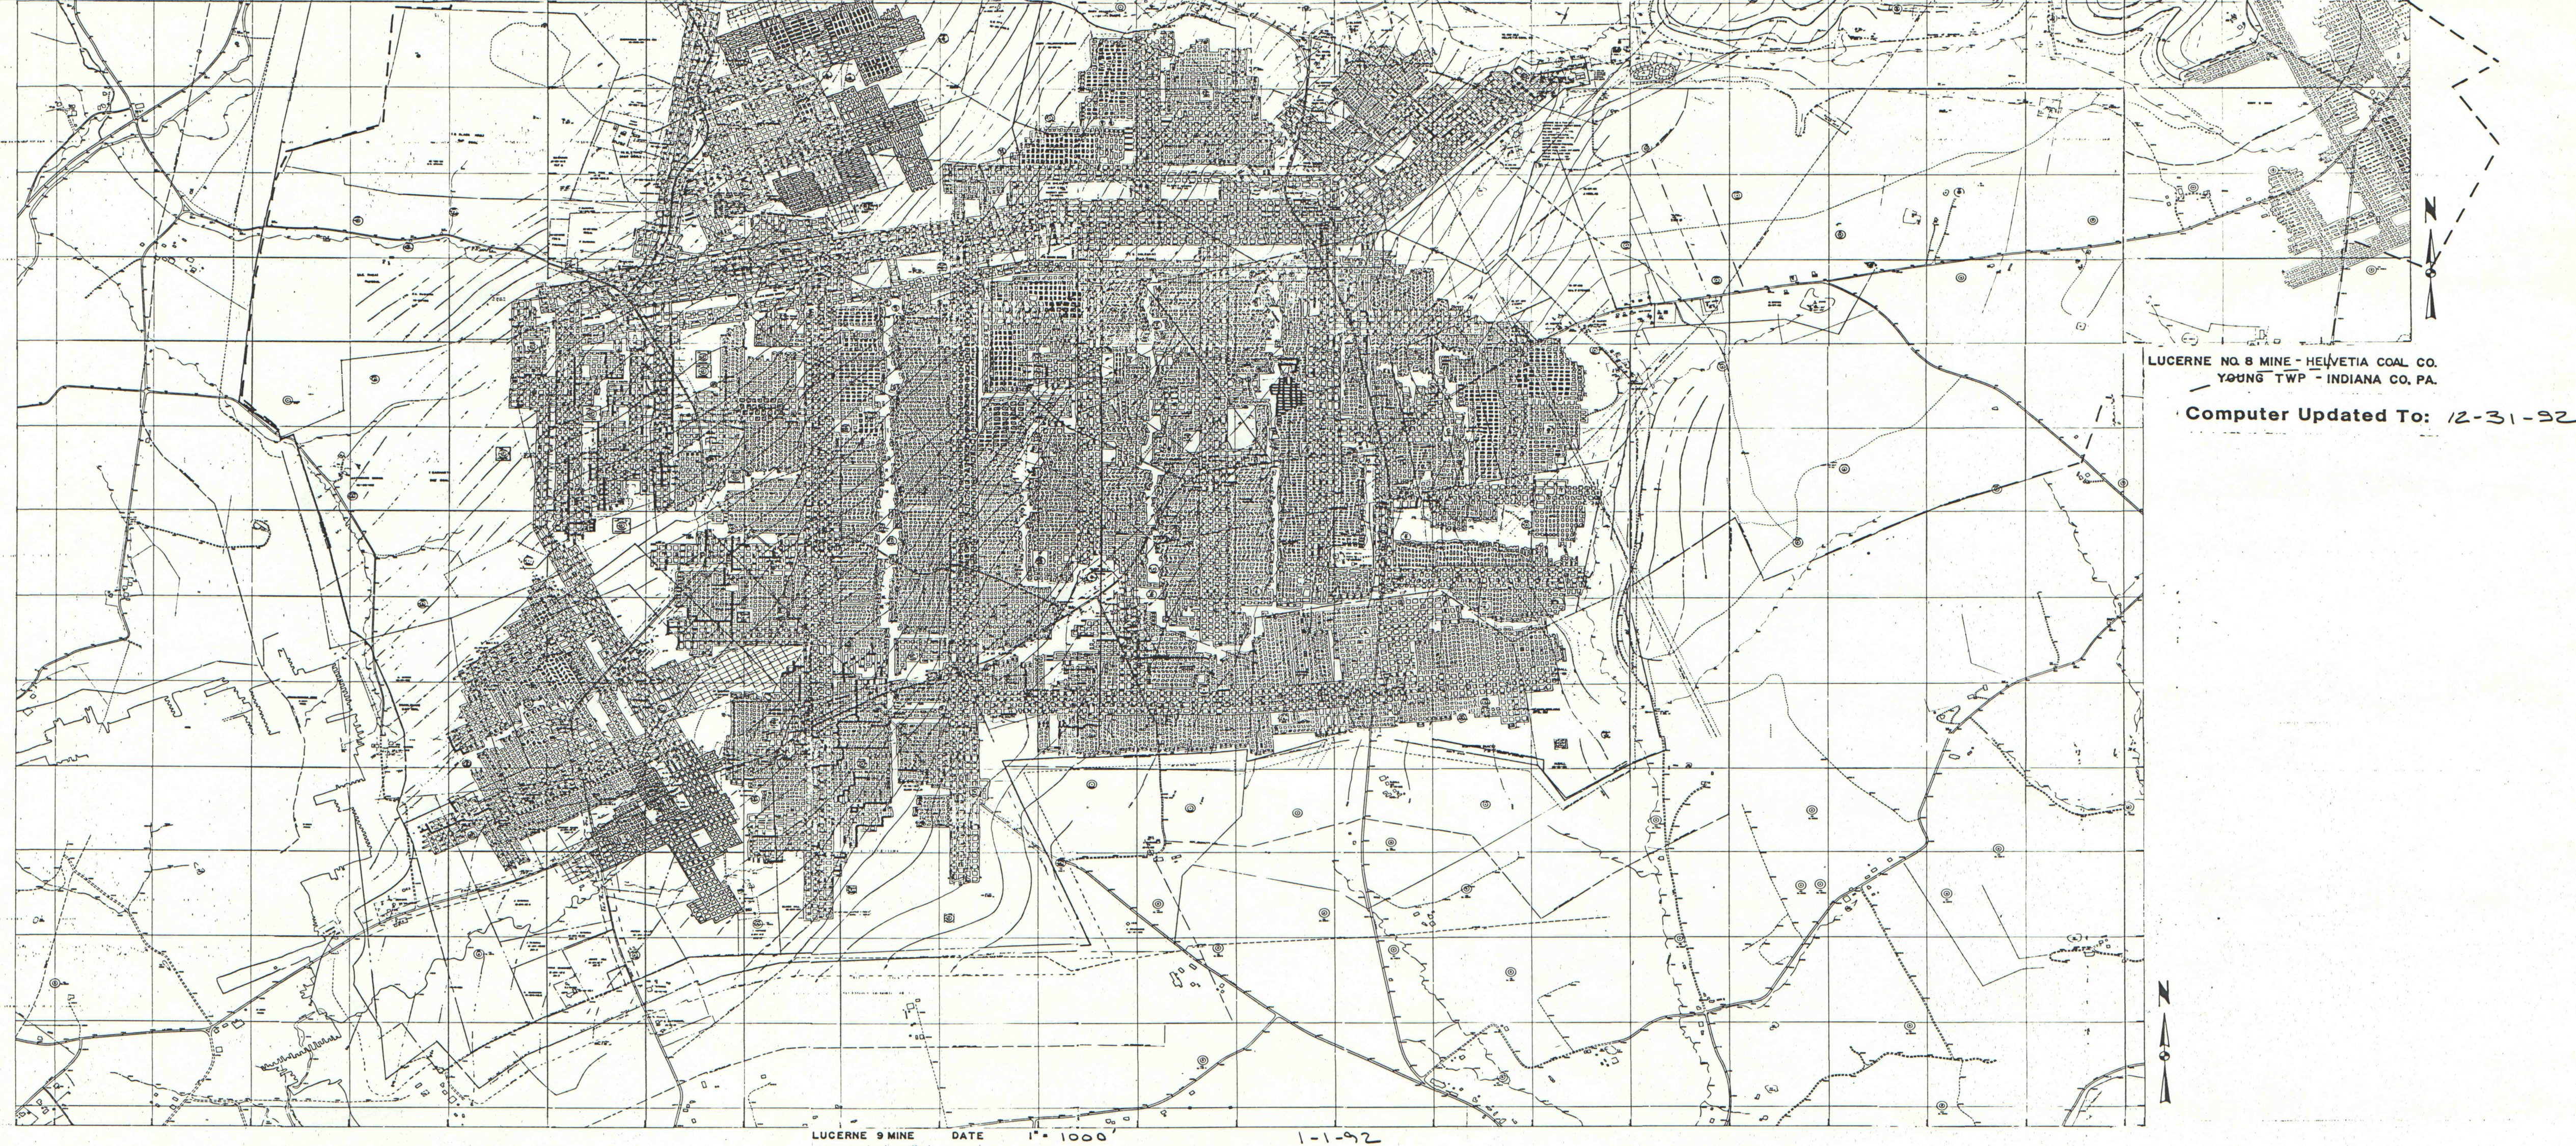

Computer Updated To: 12-31-92

IMAPS # 09639