



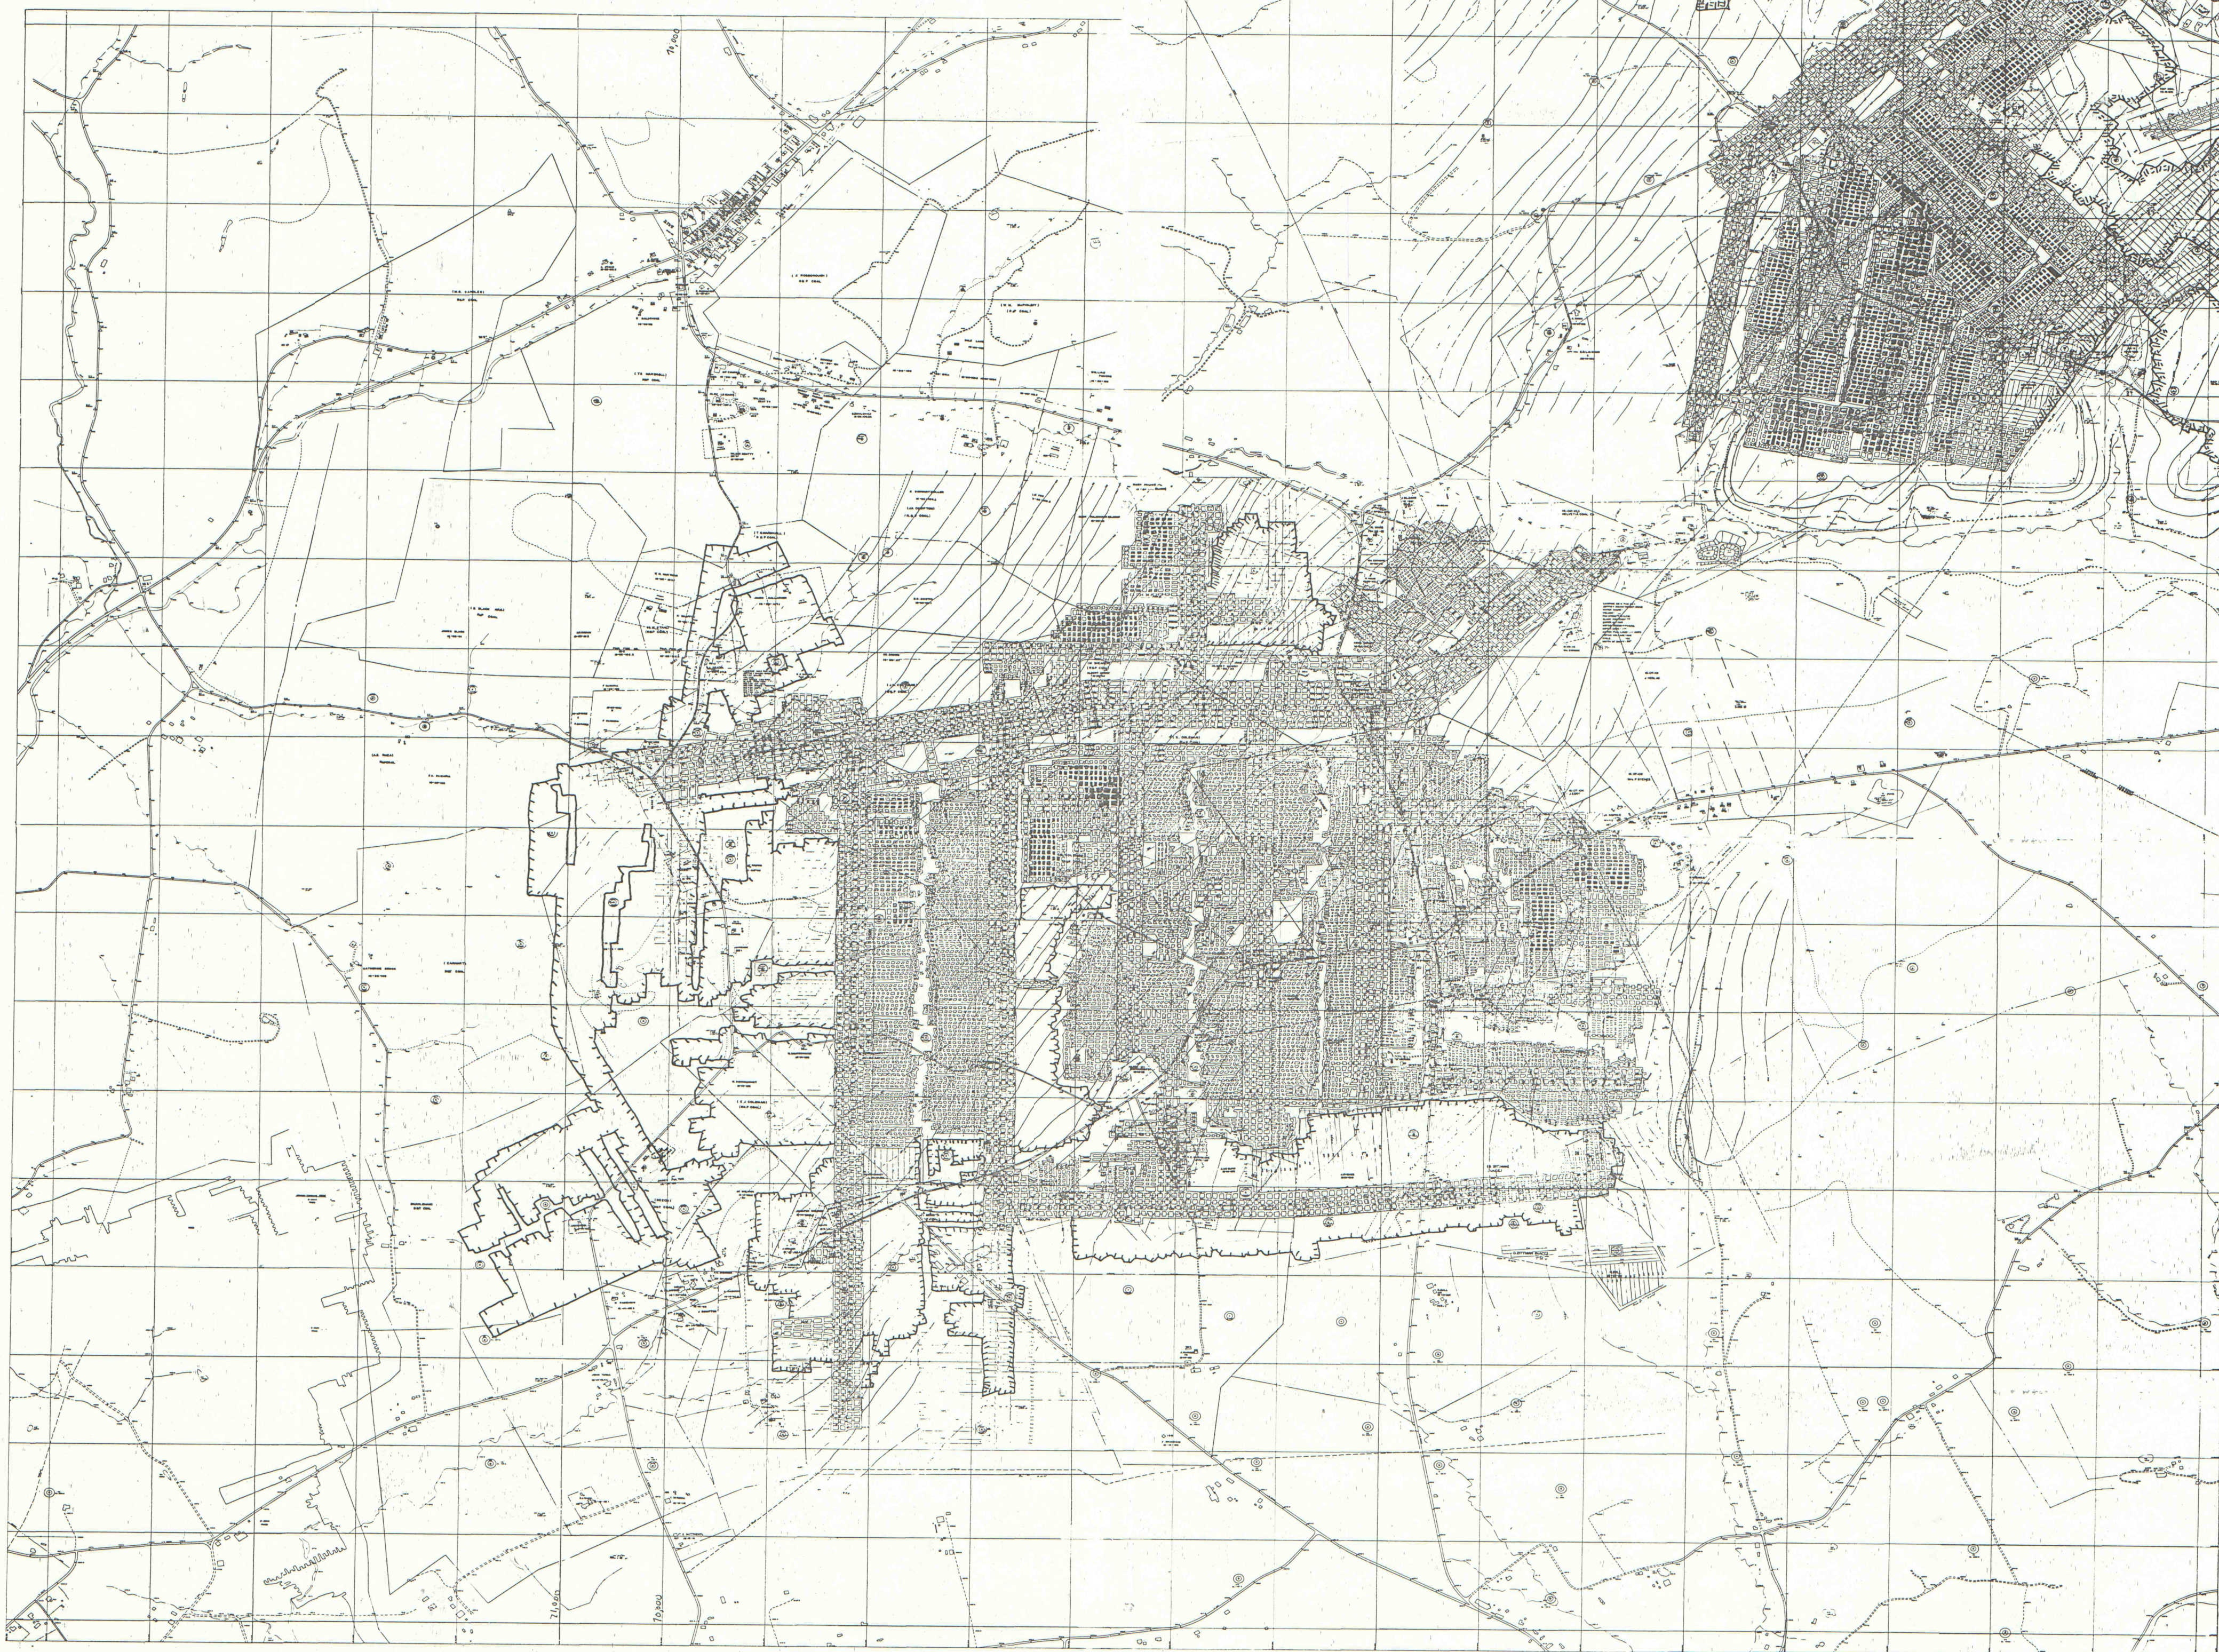

LUCERNE 9 MINE DATE 1"

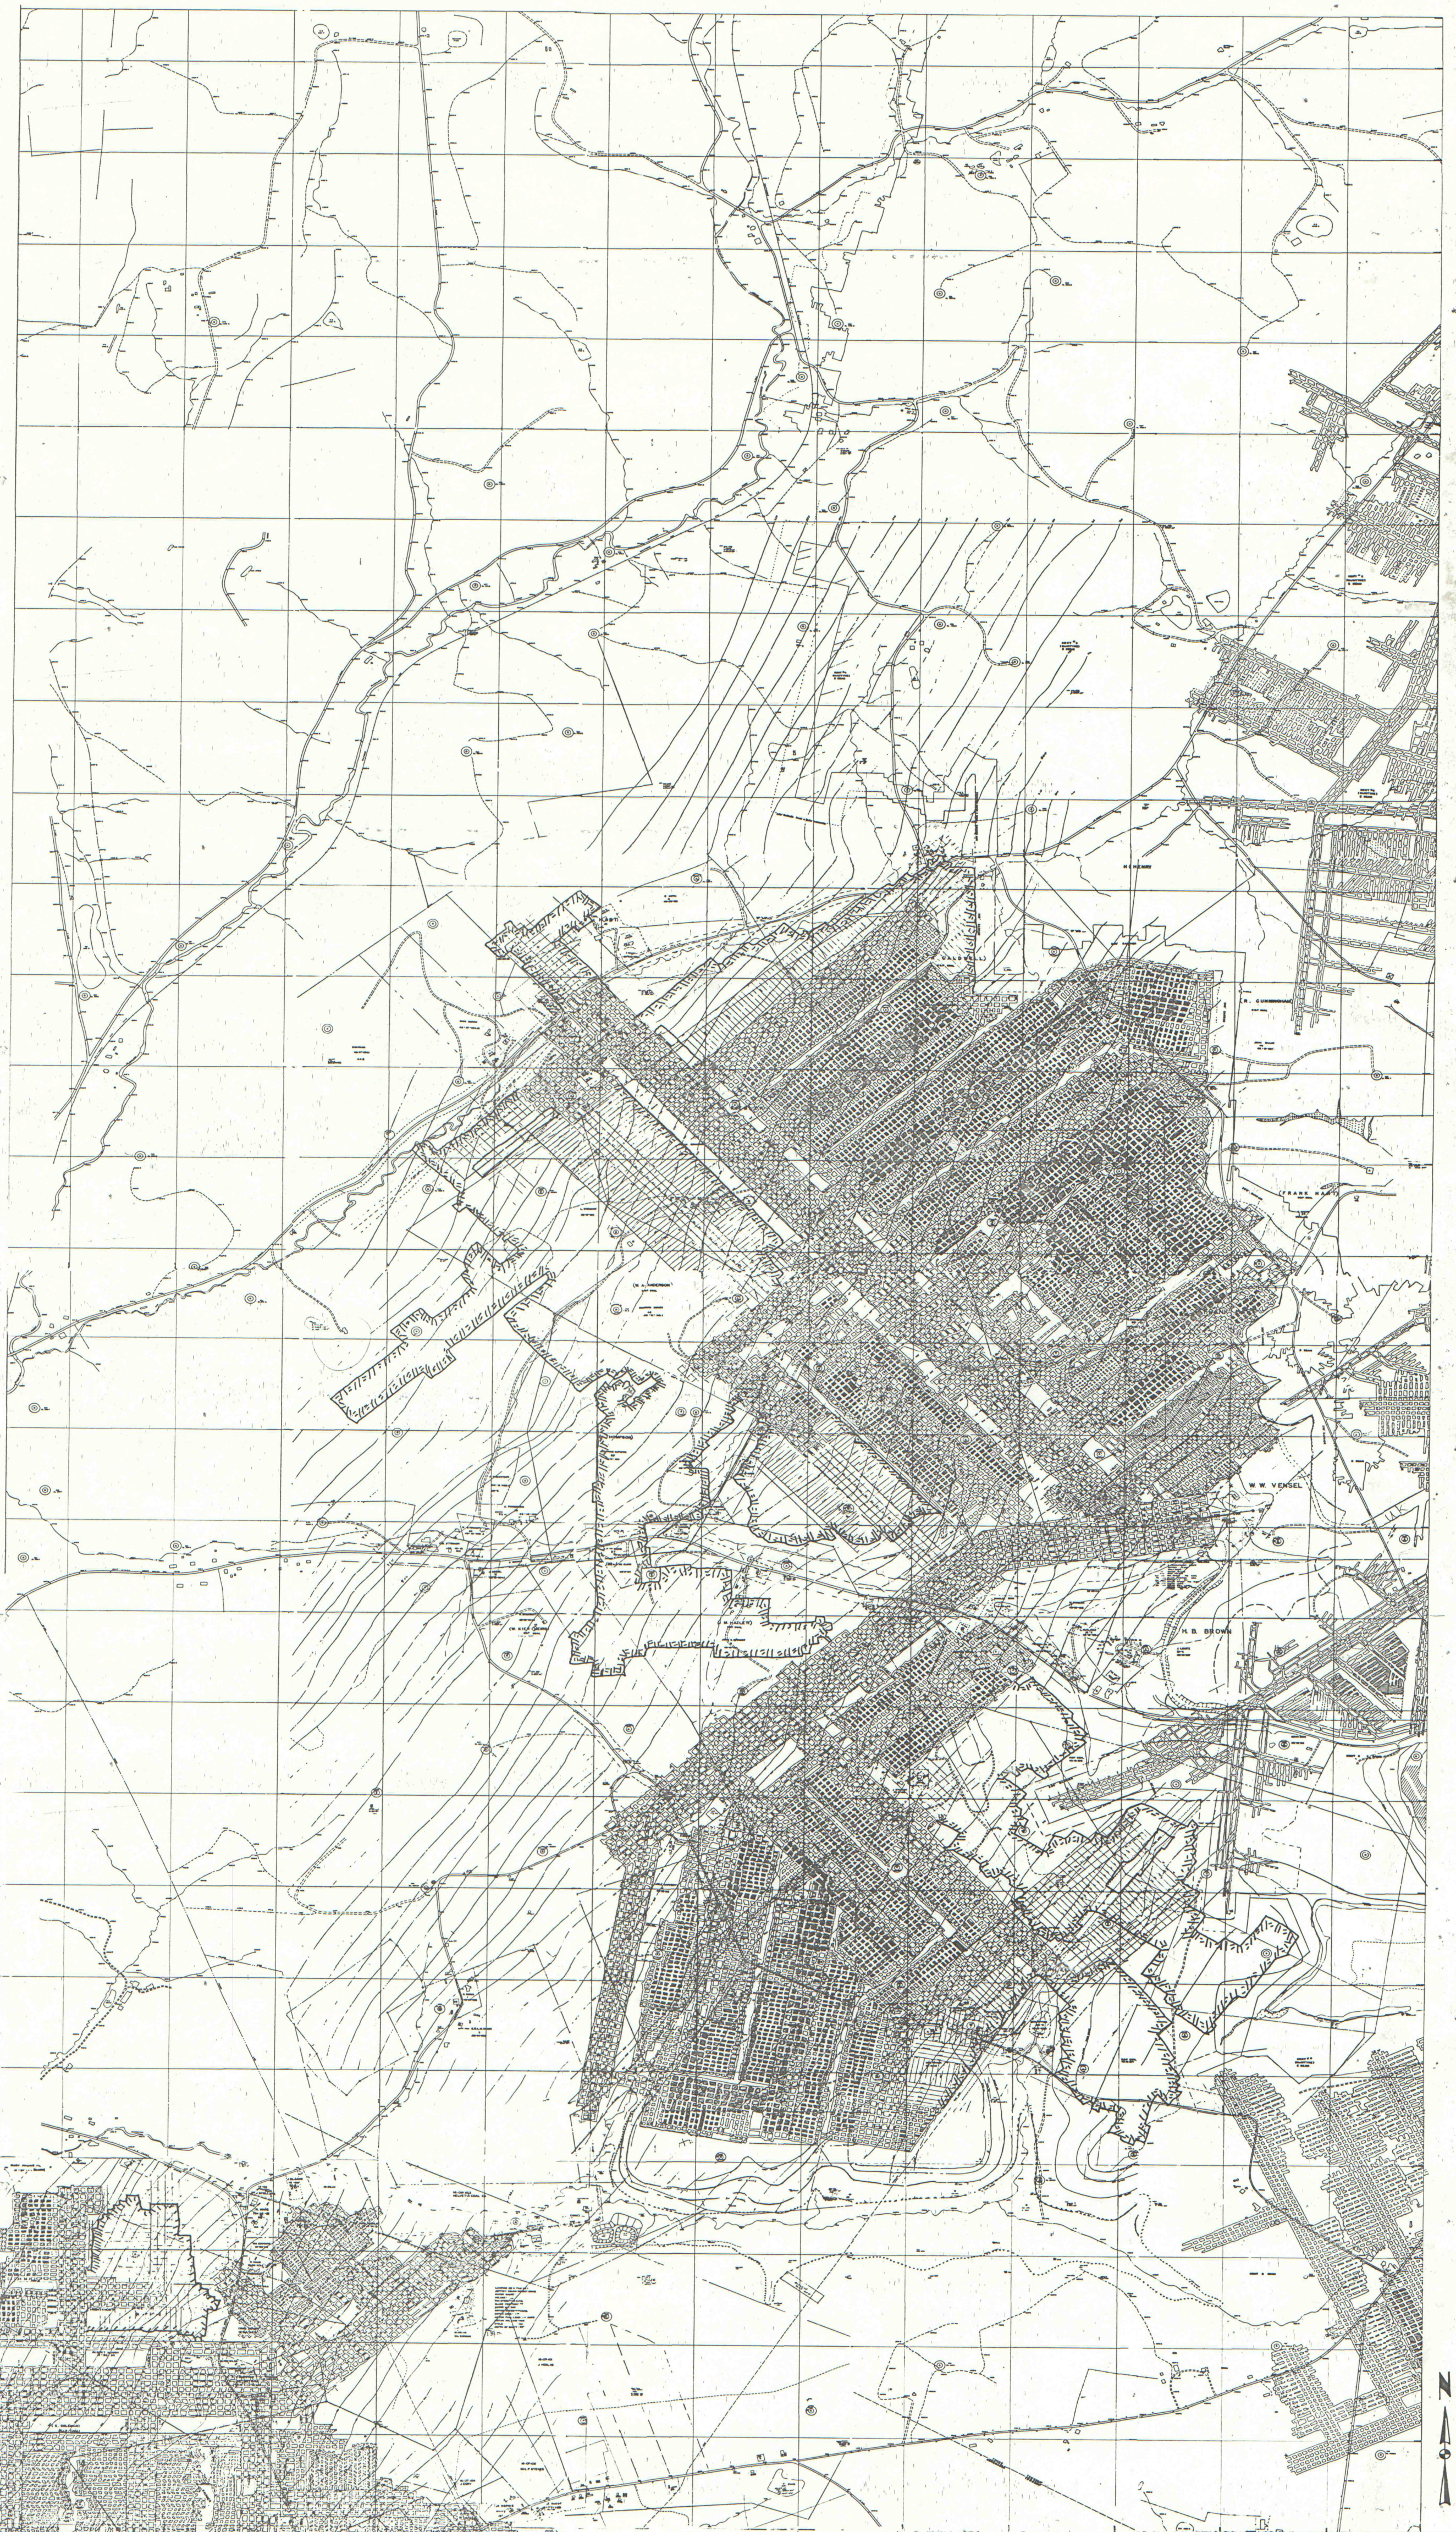

LUCERNE NO. 8 MINE - HELVETIA COAL CO.
DATE: YOUNG TWP - INDIANA CO., PA.

LUCERNE 9 MINE DATE 1"