



ROCHESTER & PITTSBURGH COAL CO
DRILL HOLE #IND-D-1680-
SCALE: 1"= 10' LOG TYPE: D
COORDINATE TYPE: R & P
N/S= -85774
E/W= -81878
7 1/2' QUAD: MCINTYRE
TWP: CONEWAUGH
SURF OWNER:
LOGGED BY: DR 10
SURF ELEV: 1275.00 TO: 307.00
STRAT INT: 17 PINE CREEK
TO: 21 LARSEN FREEPORT



ROCHESTER & PITTSBURGH COAL CO
DRILL HOLE #IND-D-1053-
SCALE: 1"= 10' LOG TYPE: D
COORDINATE TYPE: R & P
N/S= -78845.82
E/W= -48339.32 SUR.
7 1/2' QUAD:
TWP: YOUNG
SURF OWNER: J W BARCLAY
LOGGED BY: DR
SURF ELEV: 1284.30 SUR. TO: 262.58
STRAT INT: 18 BRUSH CREEK
TO: 20 UPPER FREEPORT

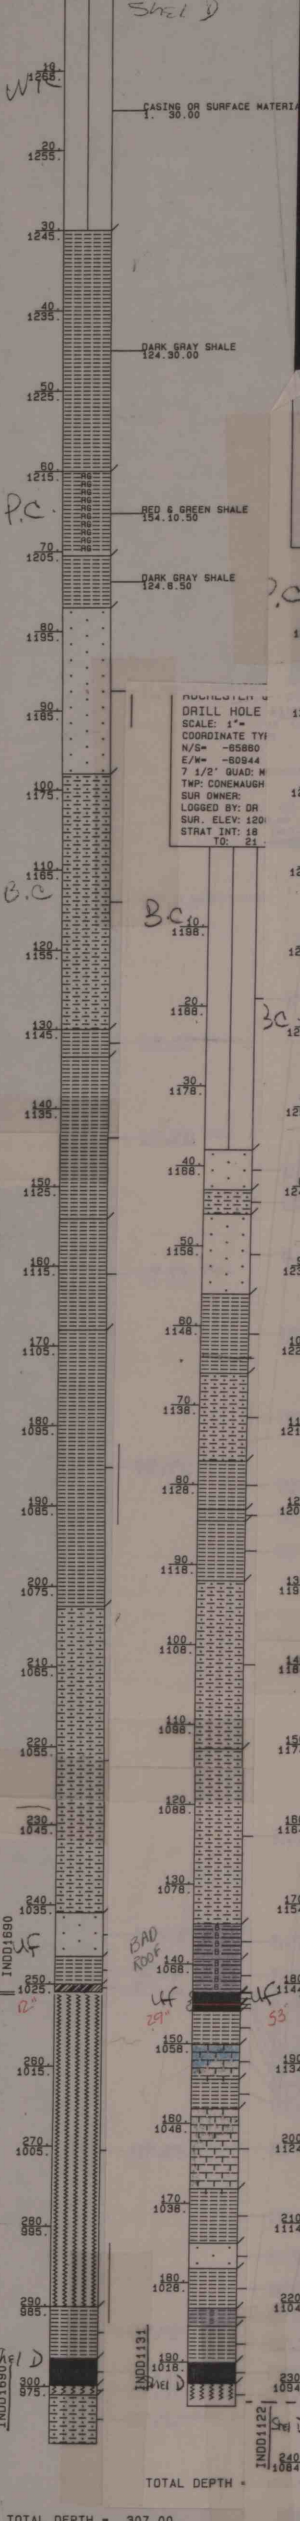

ROCHESTER & PITTSBURGH COAL CO
DRILL HOLE #IND-D-1122-
SCALE: 1"= 10' LOG TYPE: D
COORDINATE TYPE: R & P
N/S= -85551
E/W= -58547
7 1/2' QUAD: MCINTYRE
TWP: CONEWAUGH
SURF OWNER:
LOGGED BY: DR 17
SURF ELEV: 1324.00 TO: 241.00
STRAT INT: 18 PINE CREEK
TO: 21 LARSEN FREEPORT

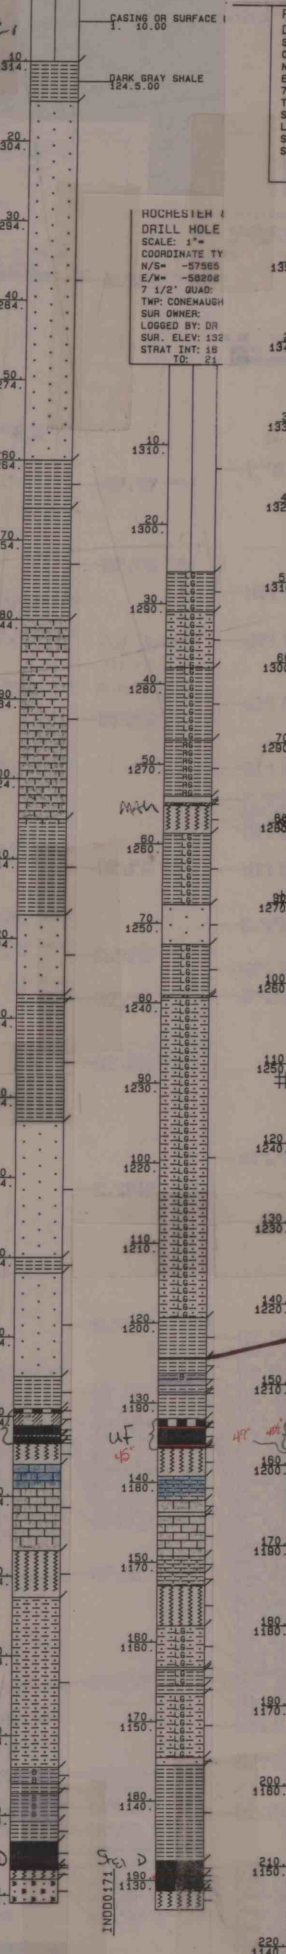

ROCHESTER & PITTSBURGH COAL CO
DRILL HOLE #IND-D-1903-
SCALE: 1"= 10' LOG TYPE: S
COORDINATE TYPE: PENNA.
N/S= 433370.88
E/W= 1581083.12 EST.
7 1/2' QUAD: MCINTYRE
TWP: CONEWAUGH
SURF OWNER:
LOGGED BY: EH
SURF ELEV: 1380.00 EST. TO: 982.00
STRAT INT: 17 PINE CREEK
TO: 25 VANPORT LIMESTONE

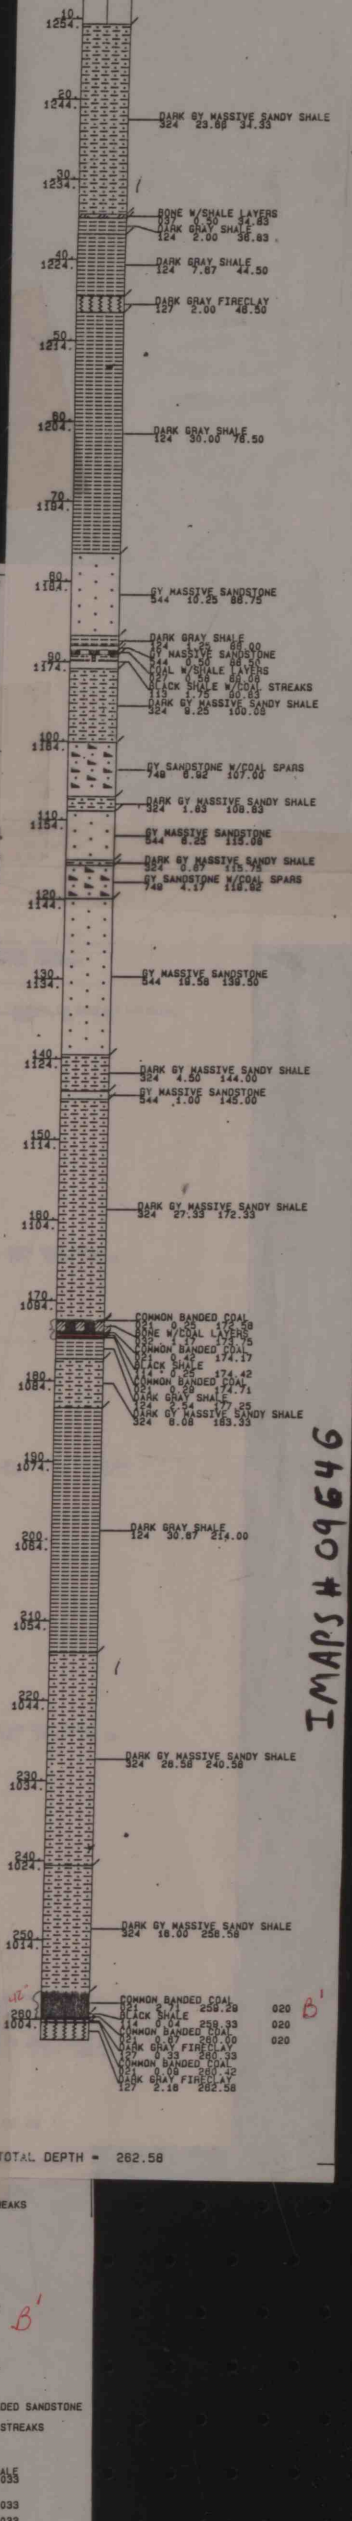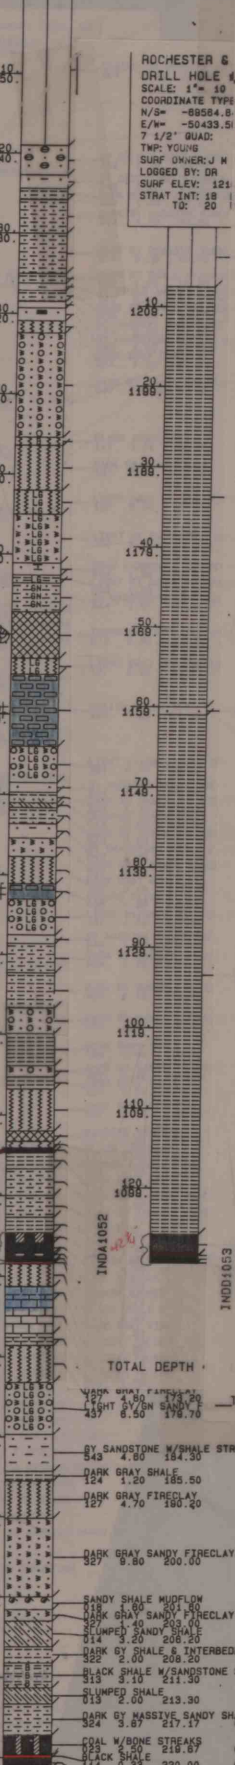

IMAPS # 09646

