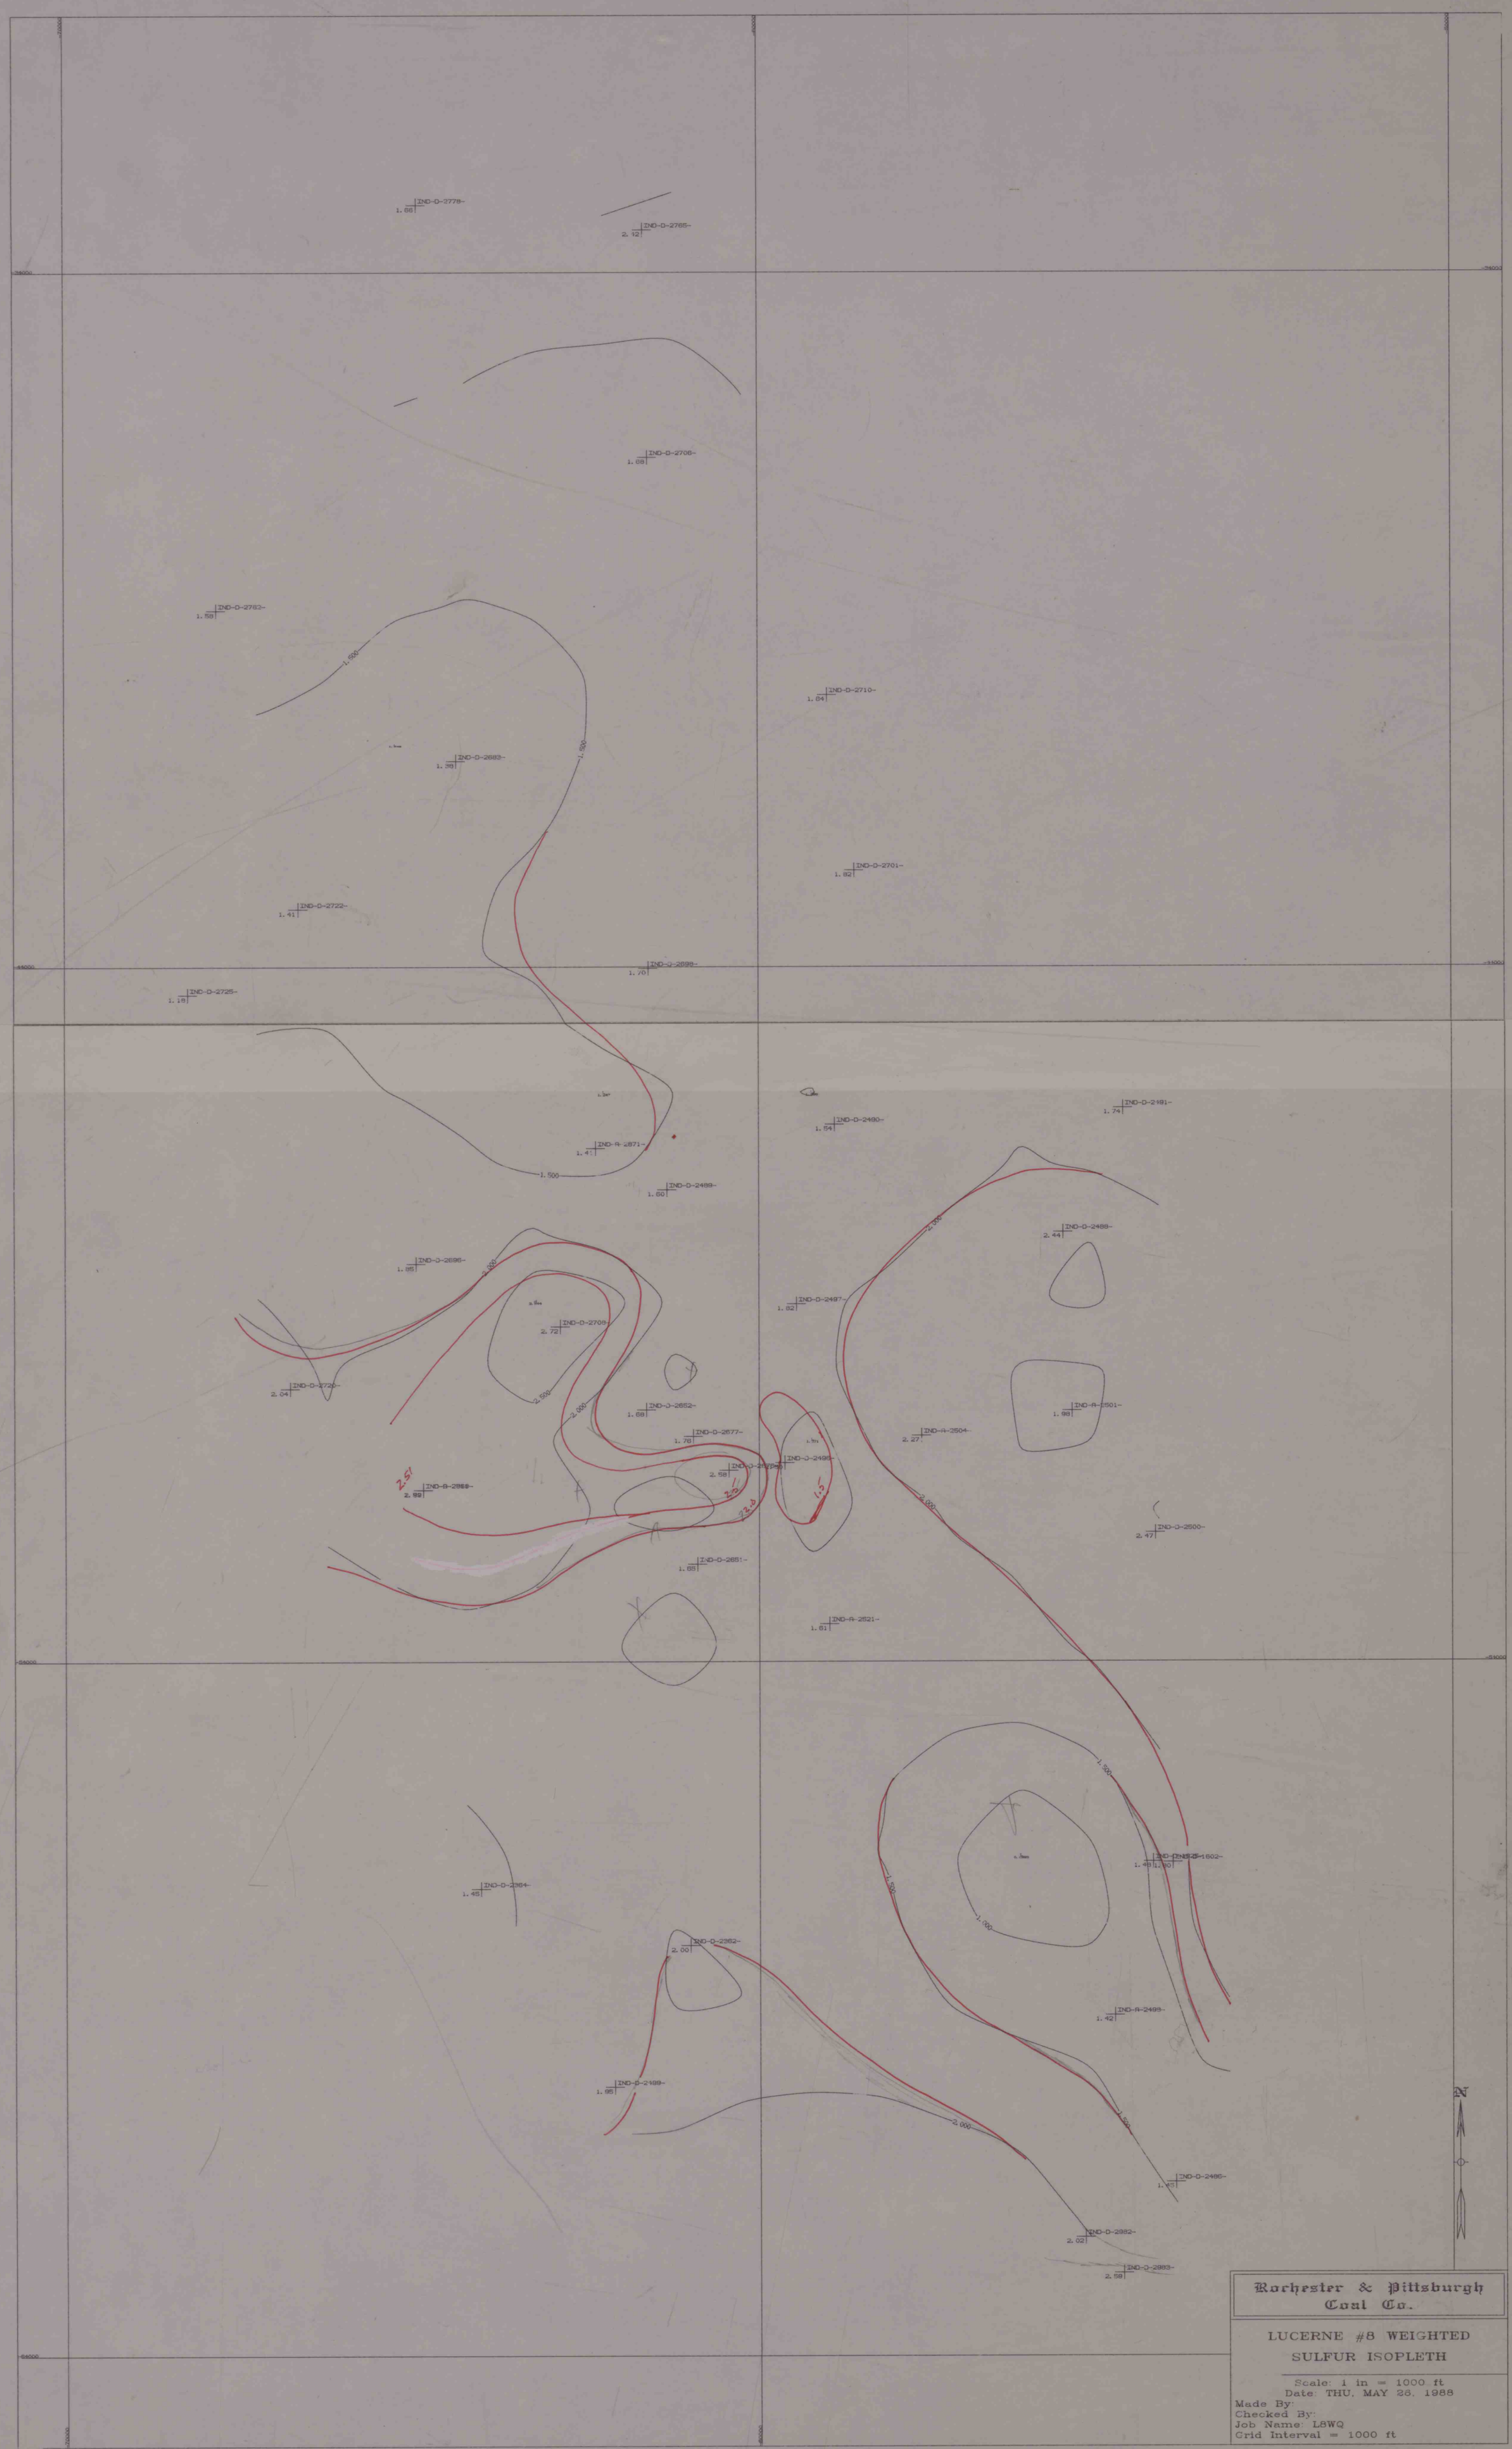

Rochester & Pittsburgh Coal Co.

LUCERNE #8 WEIGHTED SULFUR ISOPLETH

Scale: 1 in = 1000 ft
Date: THU, MAY 26, 1988
Made By:
Checked By:
Job Name: L8WQ
Grid Interval = 1000 ft