


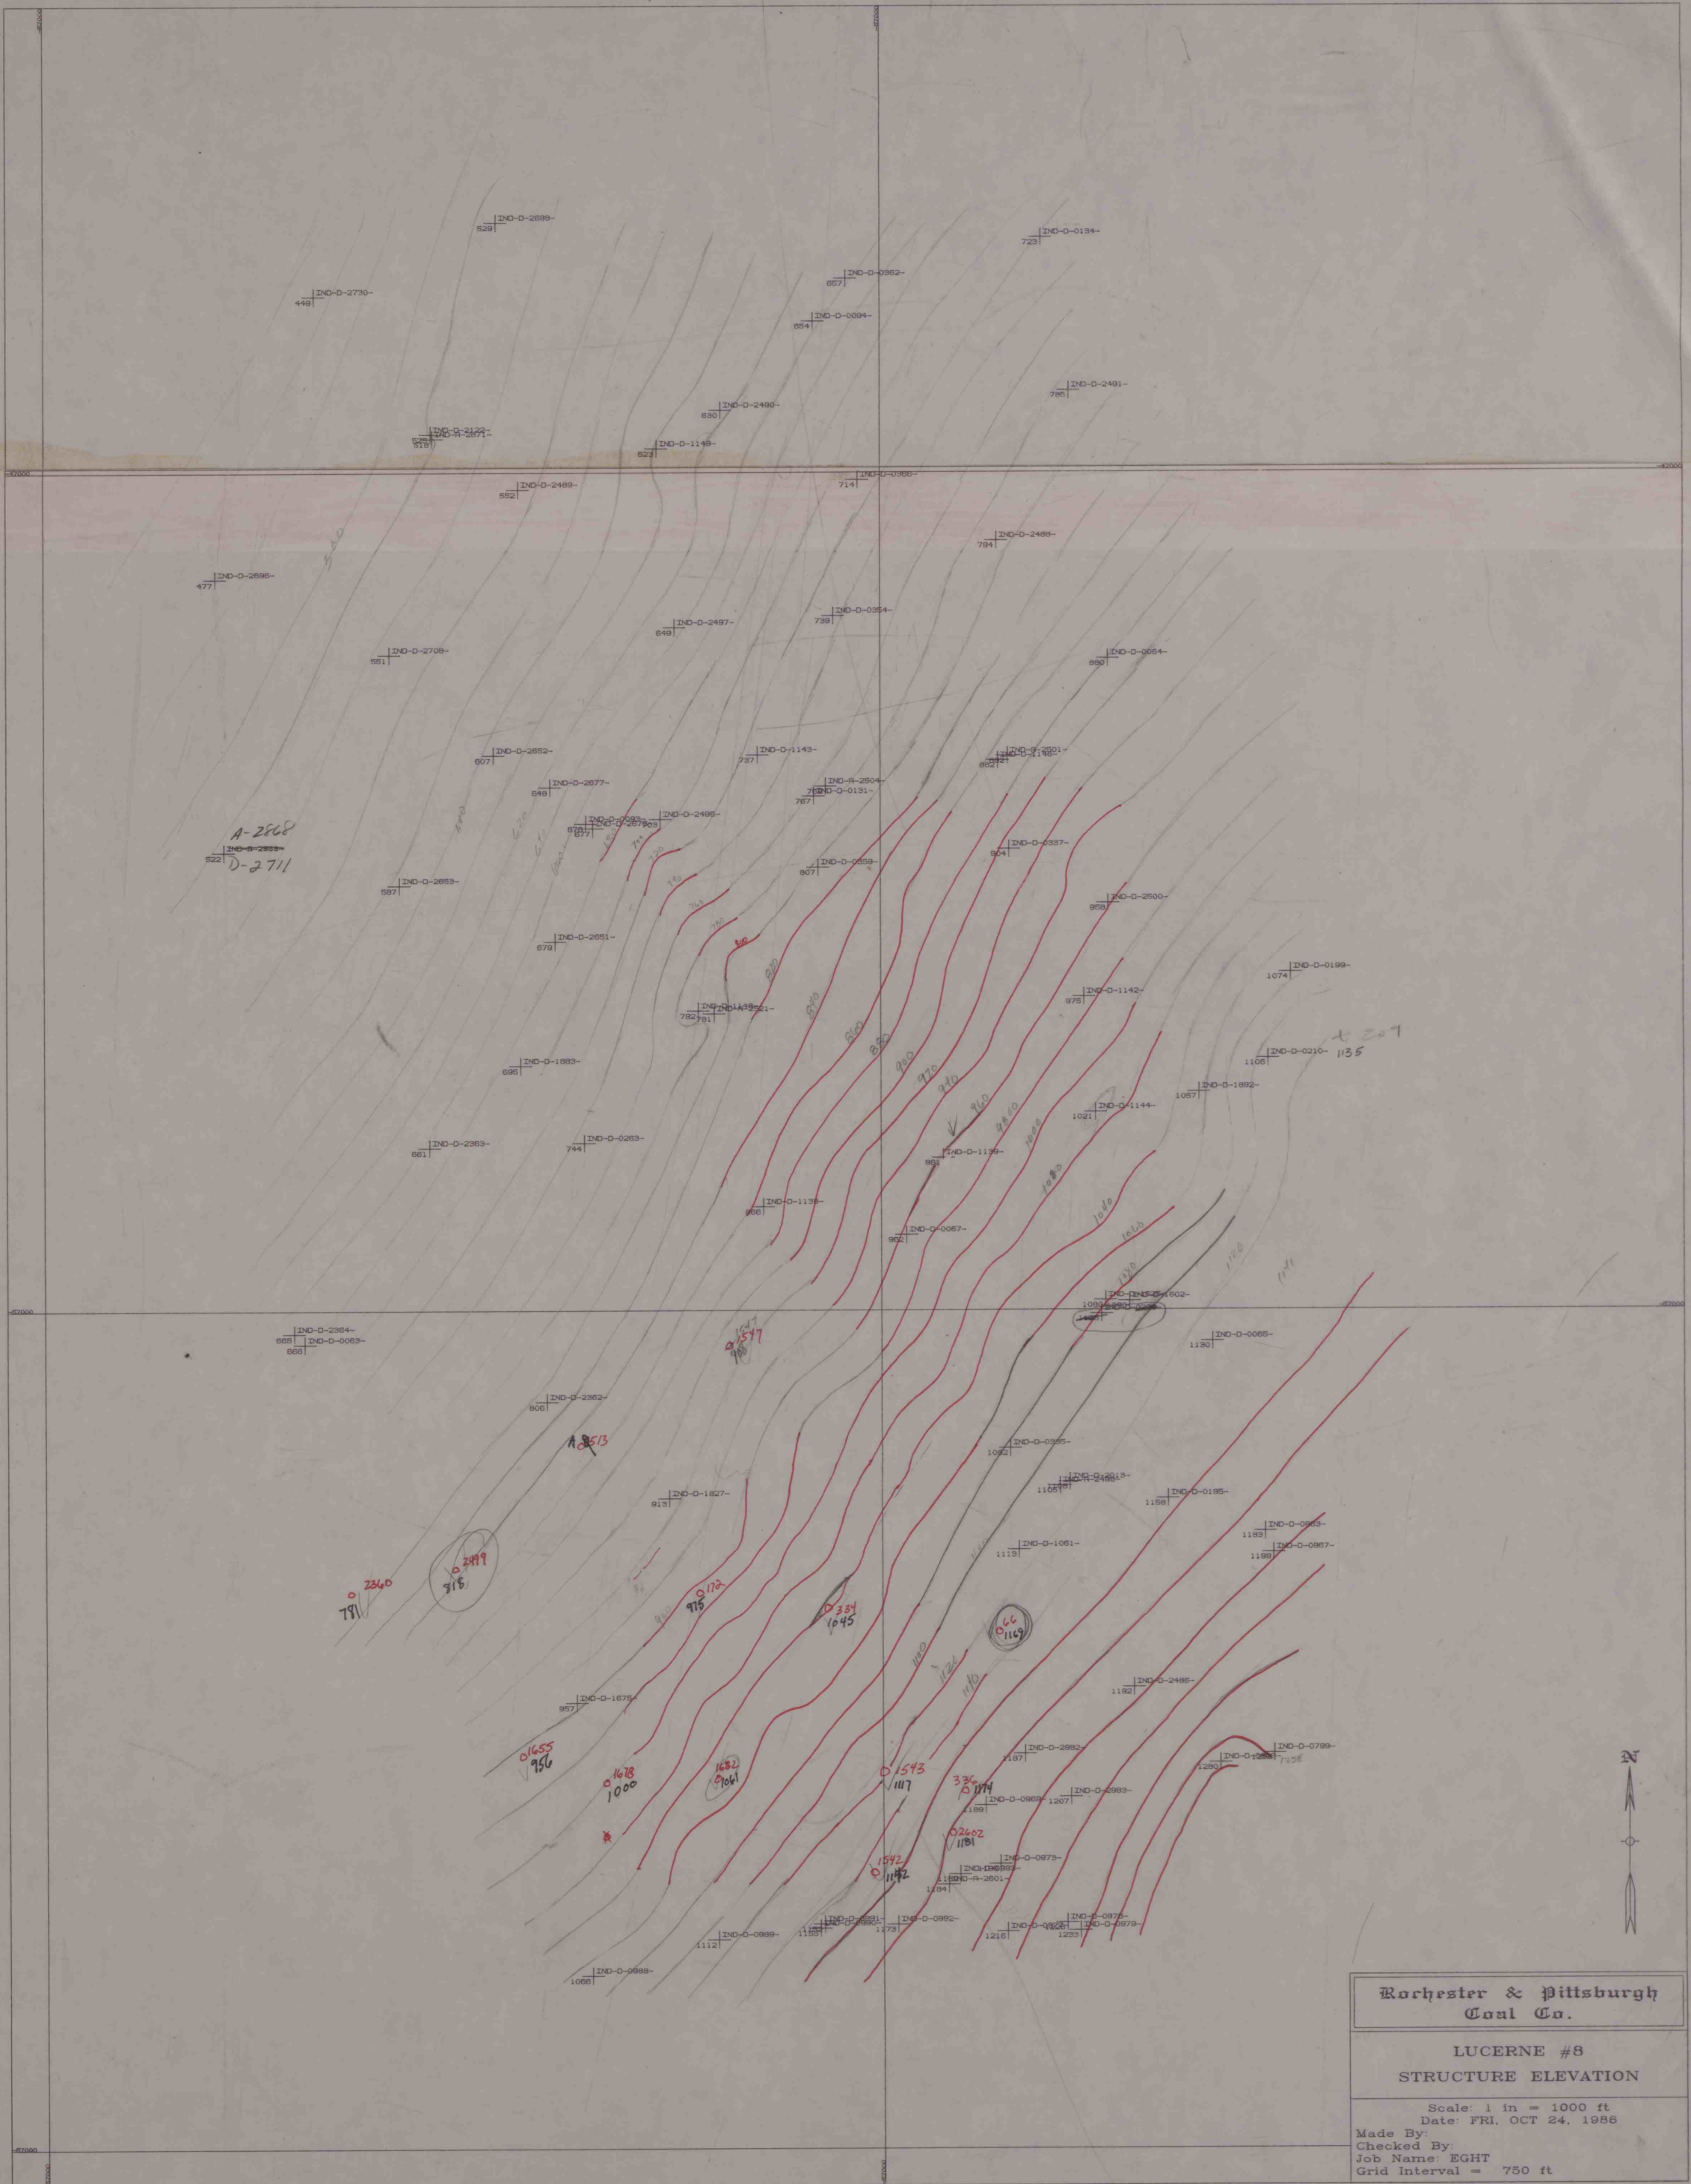

Rochester & Pittsburgh Coal Co.
LUCERNE #8 STRUCTURE ELEVATION
Scale: 1 in = 1000 ft Date: FRI, OCT 24, 1986
Made By: Checked By: Job Name: EGHT Grid Interval = 750 ft

INAPS #09663