


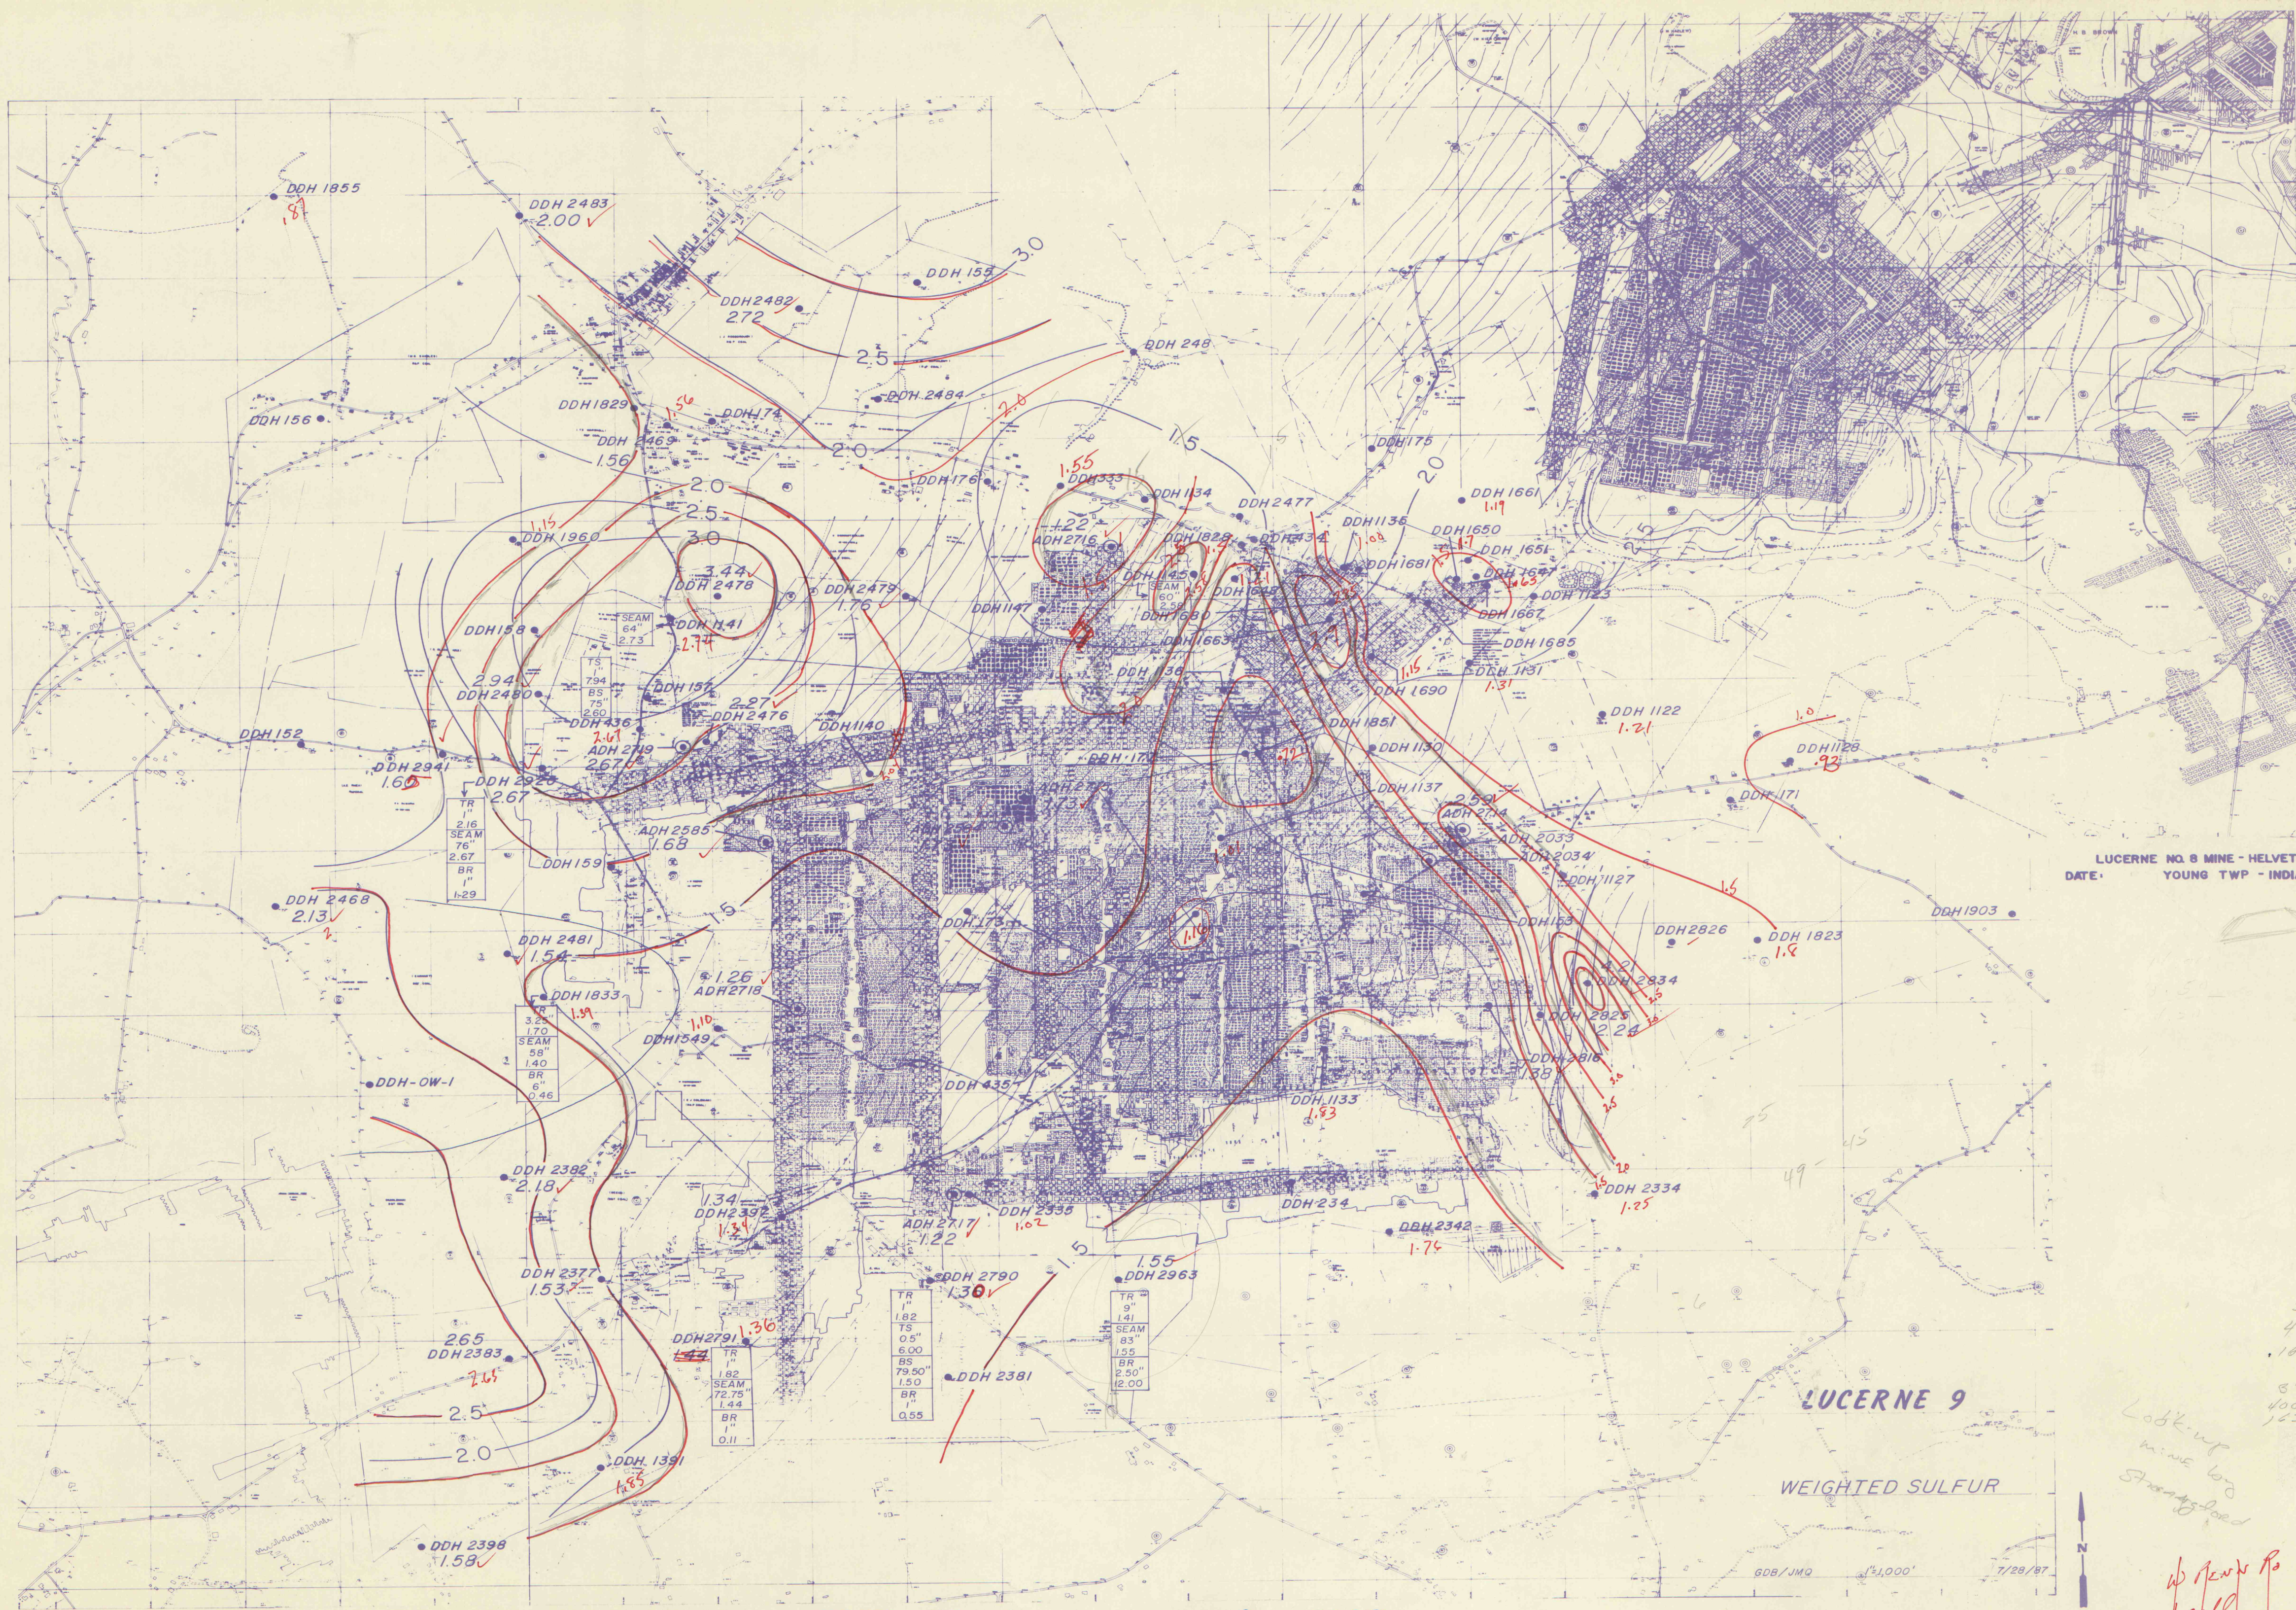

LUCERNE NO. 8 MINE - HELVETIA COAL CO.
DATE: YOUNG TWP - INDIANA CO., PA.

LUCERNE 9
WEIGHTED SULFUR

LUCERNE 9 MINE DATE 1"

IMAPS 09669

LUCERNE 9 MINE DATE 1"

951

LEWS
→ June
840
1040
1200
1000
200
320
420
520
6
3285
400350
1630700
8256
400800
1630850

Look-up
mine log
Stratigraphic

W. New R.
call
Paul Rowley