


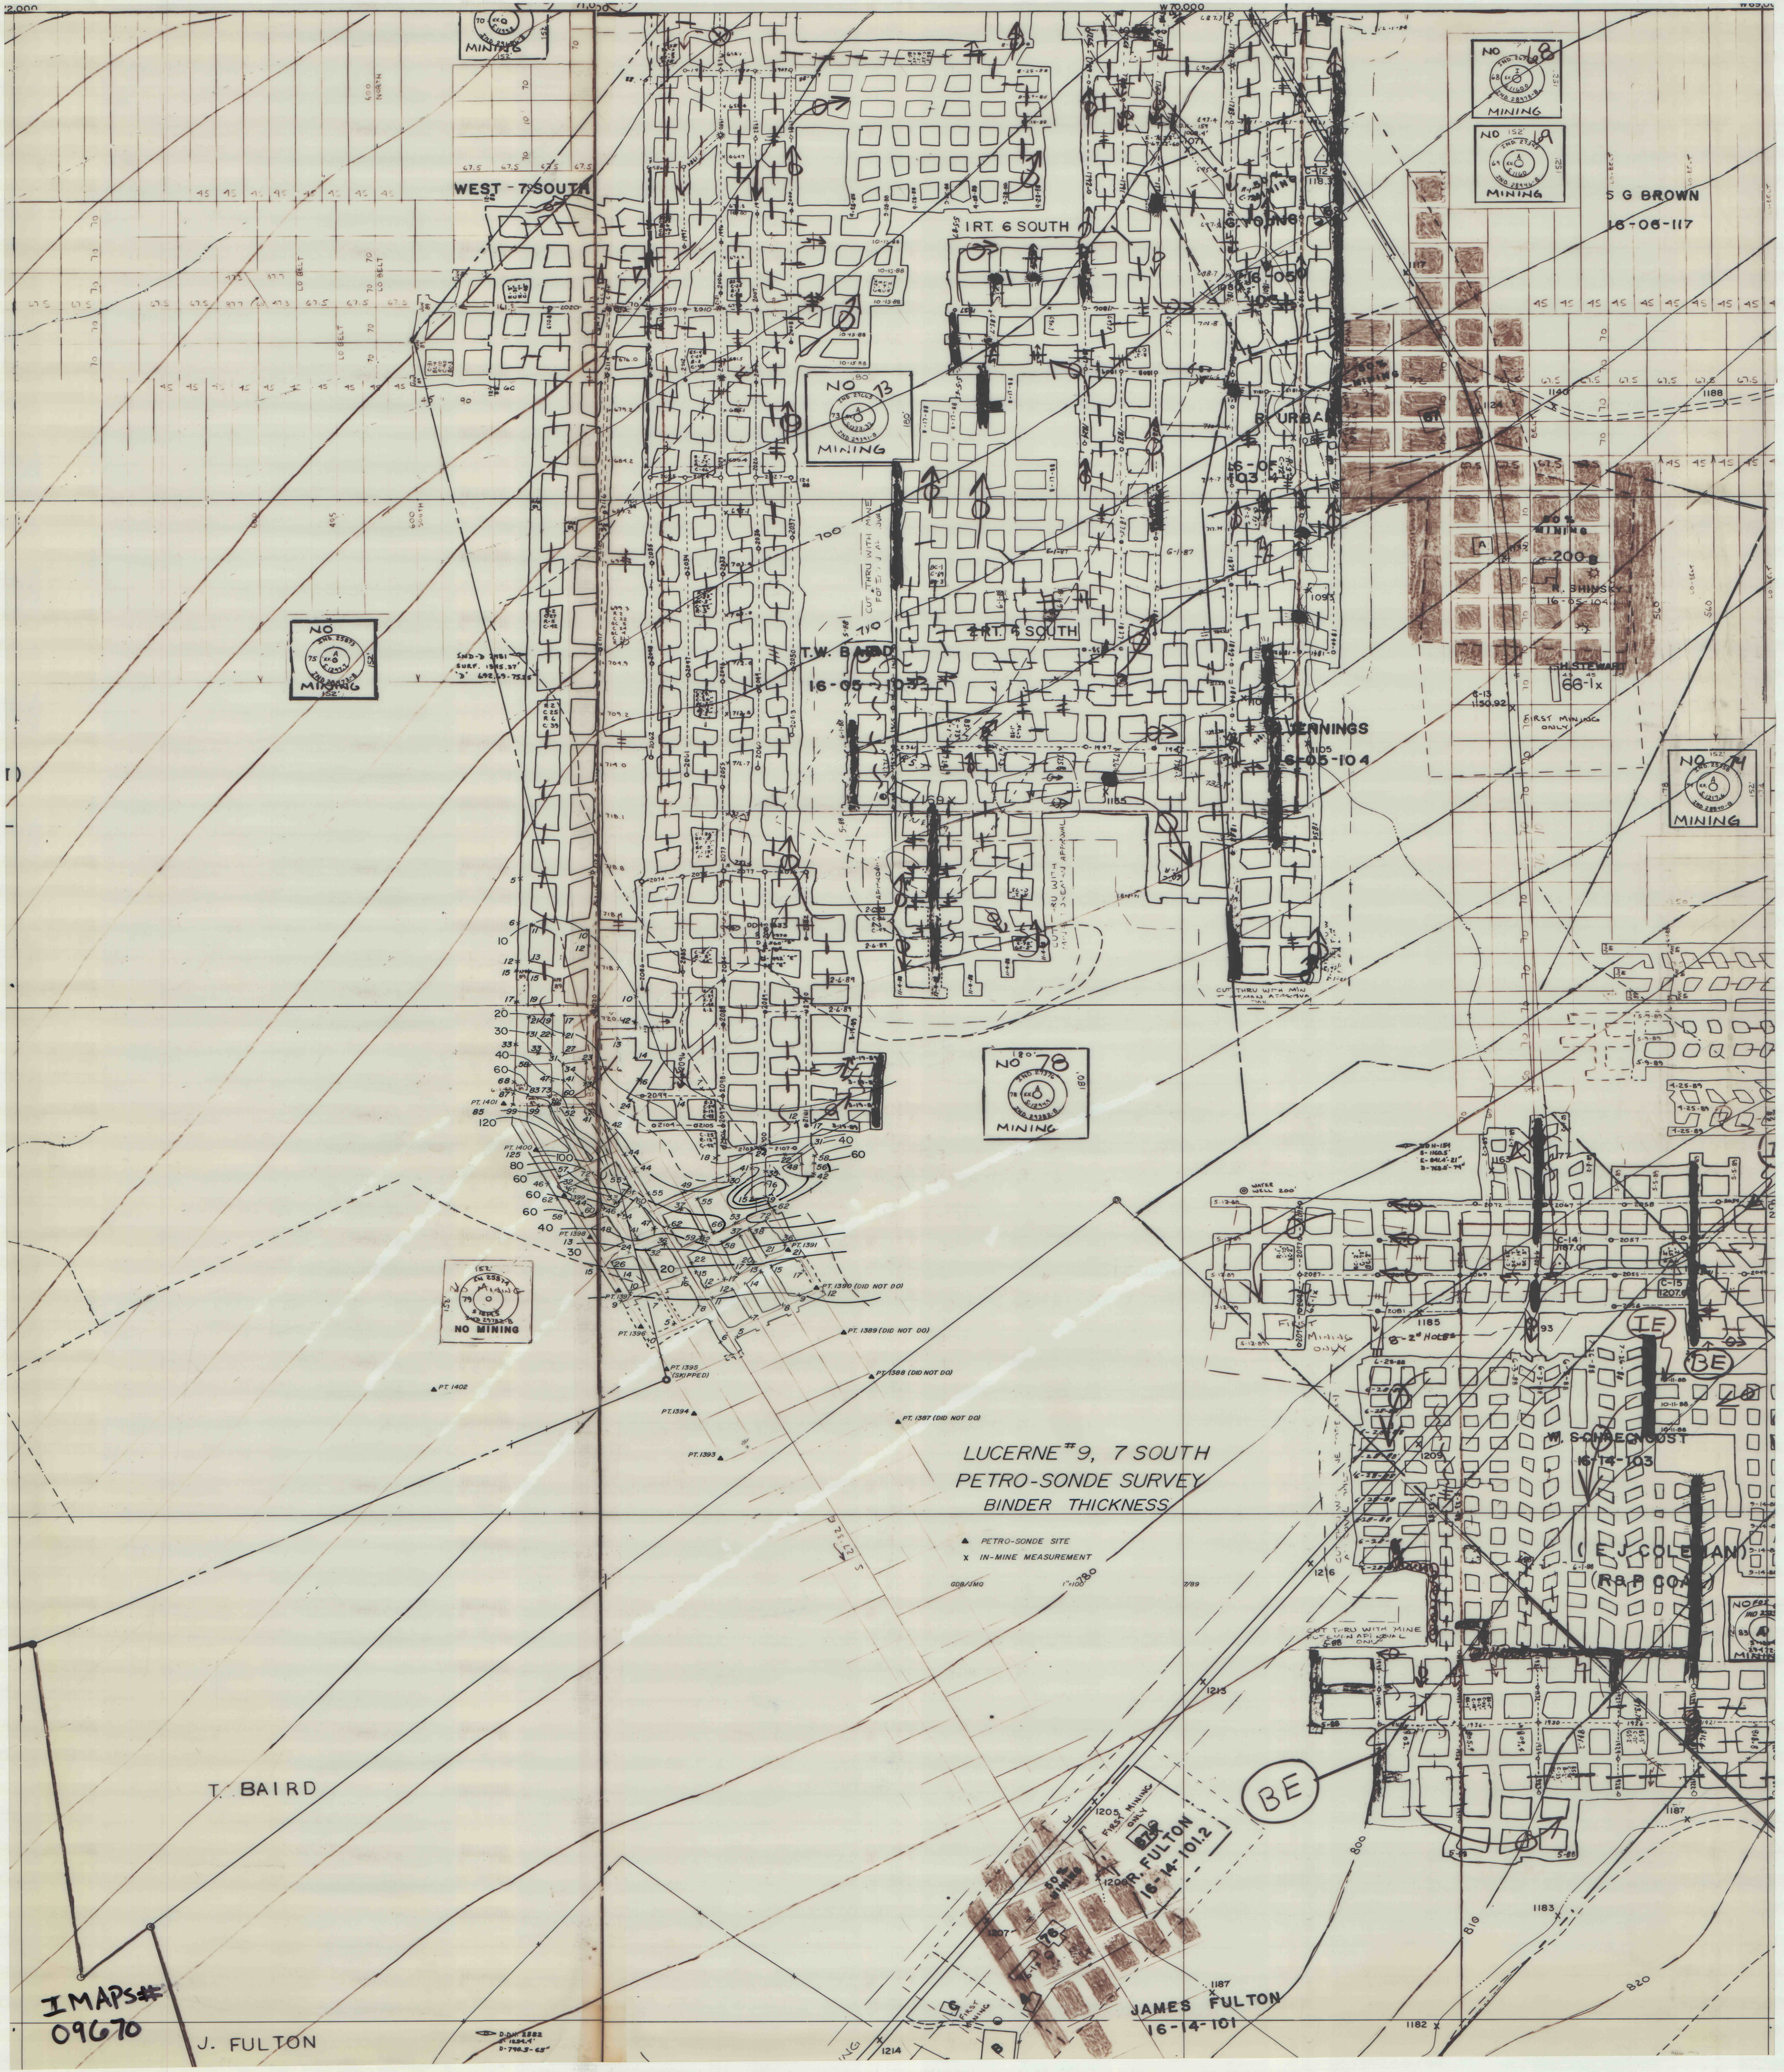

WEST - 7 SOUTH

IRT. 6 SOUTH

NO 13
MINING

NO 18
MINING
NO 19
MINING

5 G BROWN
16-06-117

NO 15
MINING

T.W. BAIRD
16-05-103

IRT. 4 SOUTH

VERNINGS
16-05-104

NO 20
MINING

200-8
R. SHIMSKY
16-05-104

SH STEWART
66-1x

NO 14
MINING

NO 78
MINING

NO 79
MINING

LUCERNE #9, 7 SOUTH
PETRO-SONDE SURVEY
BINDER THICKNESS

▲ PETRO-SONDE SITE
X IN-MINE MEASUREMENT

T. BAIRD

BE

IMAPS#
09670

J. FULTON

JAMES FULTON
16-14-101