


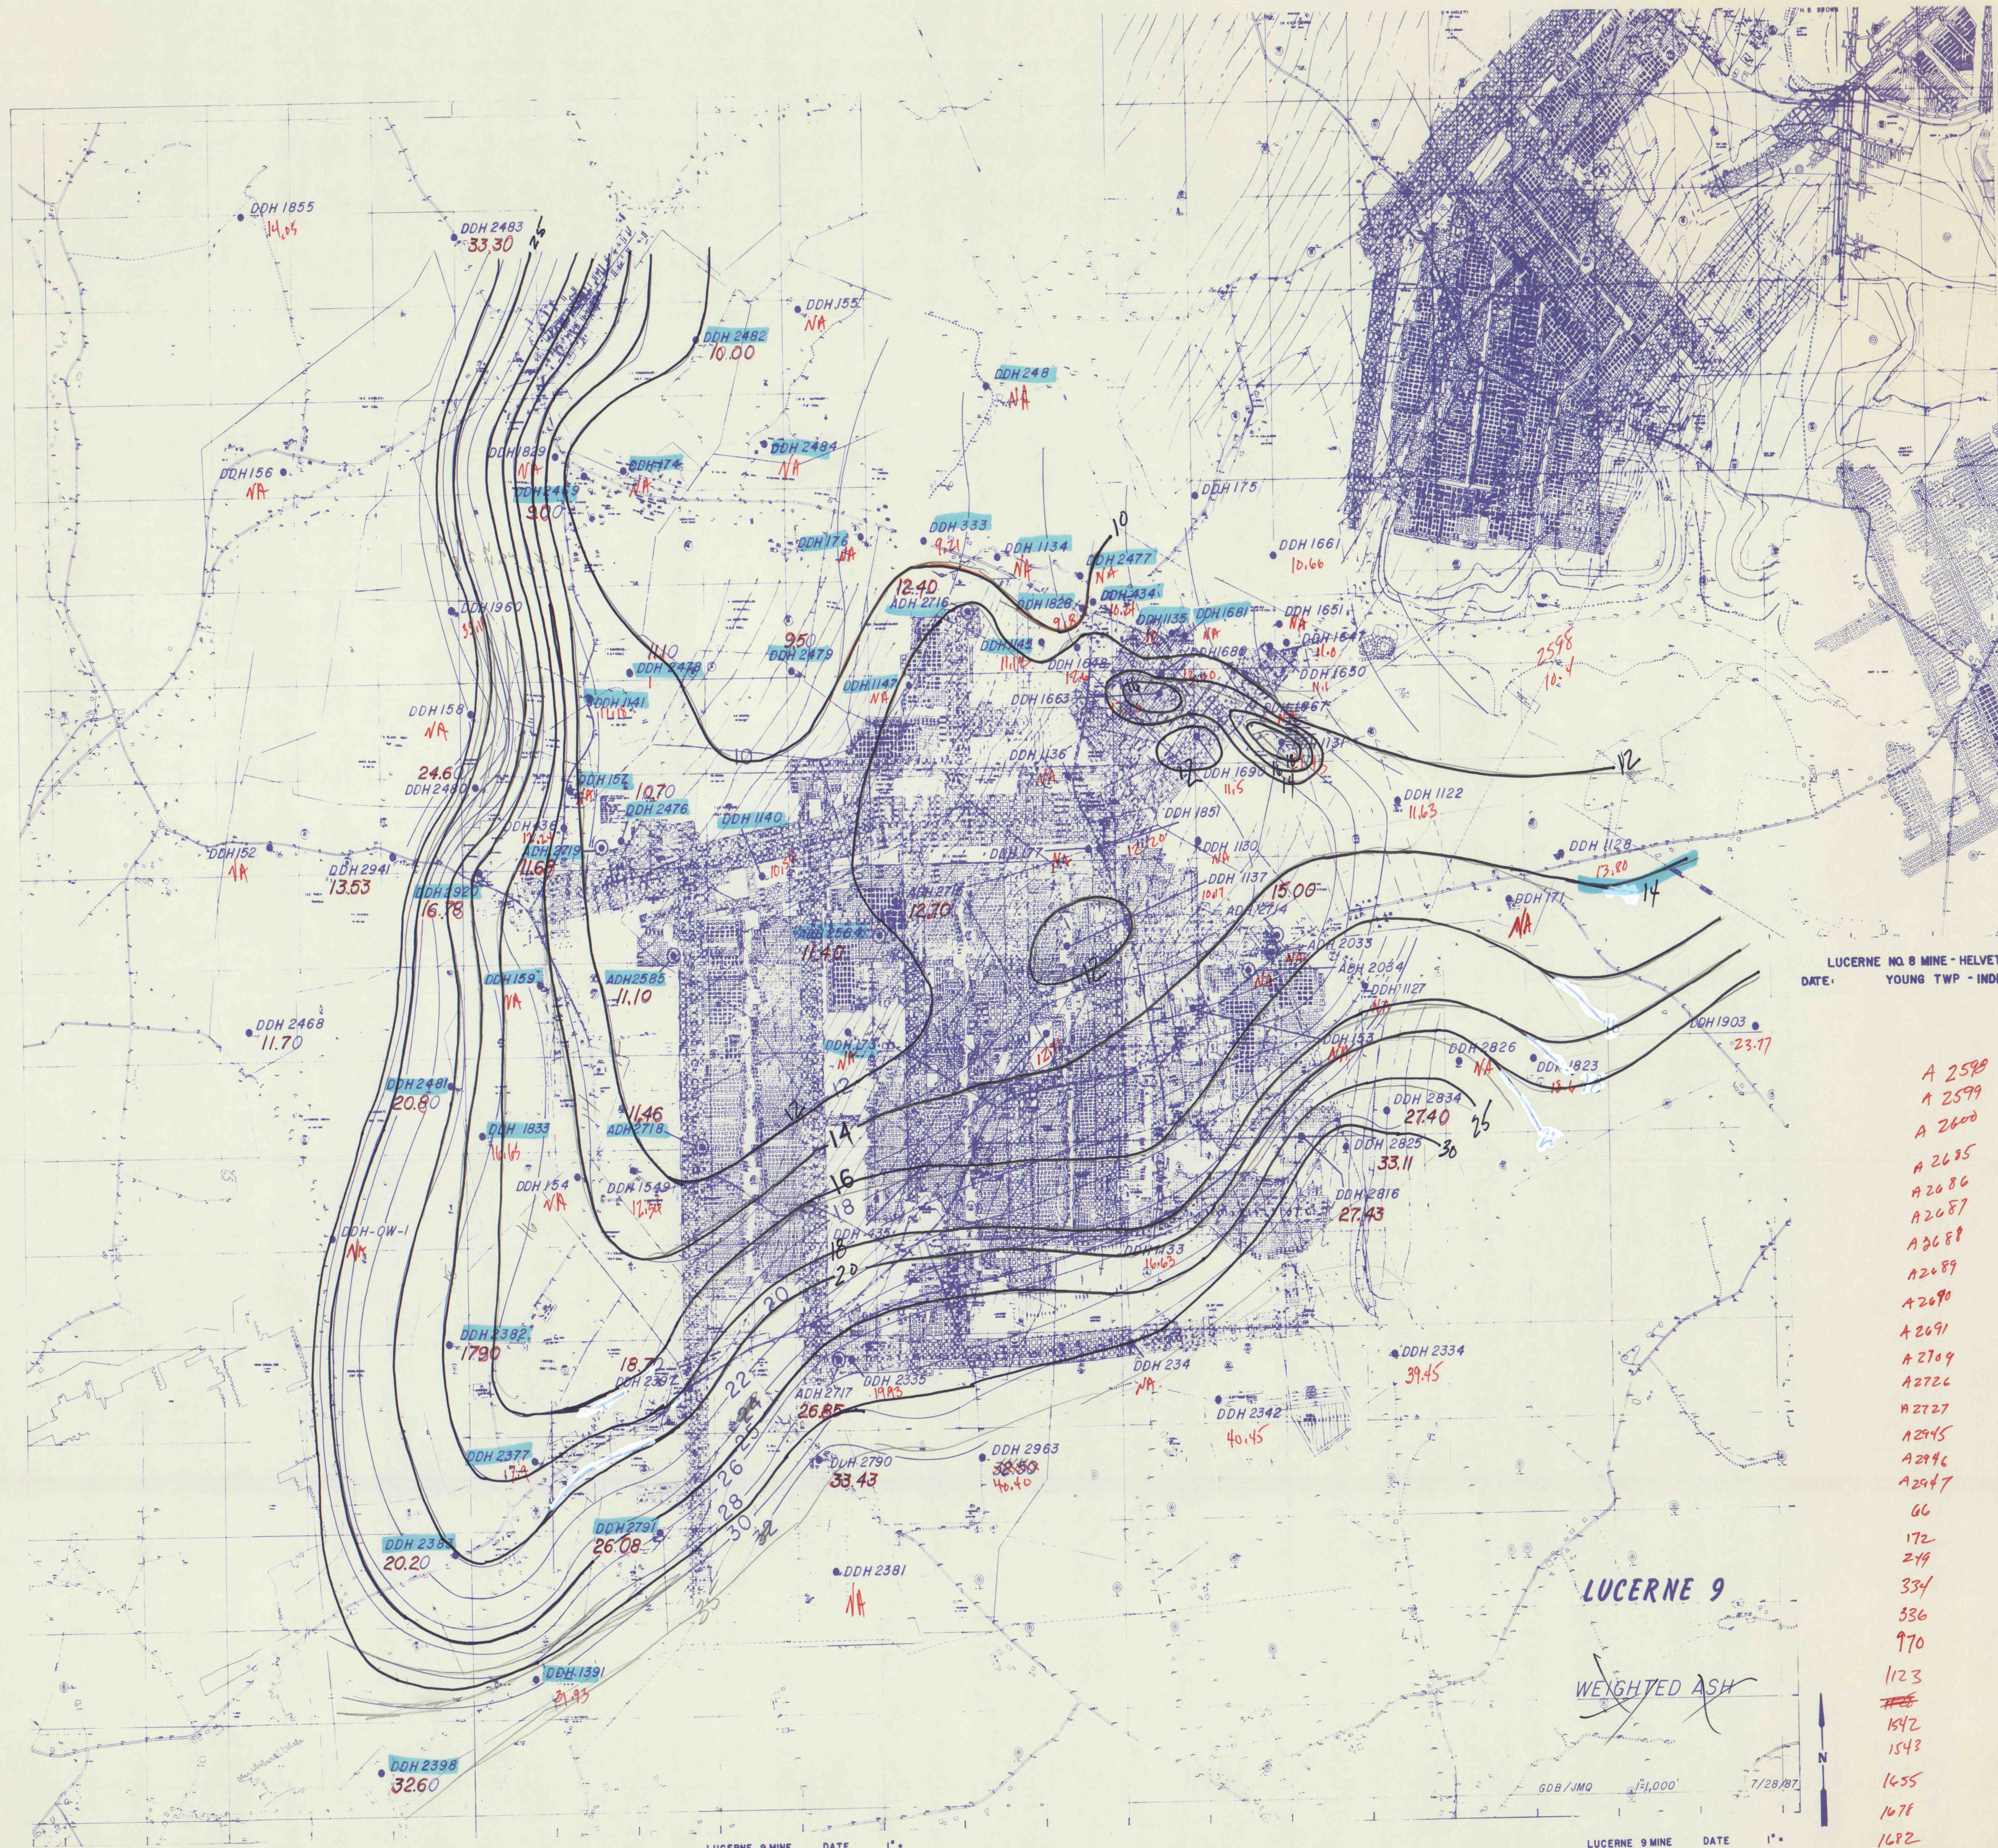

LUCERNE NO. 8 MINE - HELVETIA COAL CO.
DATE: YOUNG TWP - INDIANA CO. PA.

- A 2588
- A 2599
- A 2600
- A 2635
- A 2686
- A 2687
- A 2688
- A 2689
- A 2690
- A 2691
- A 2709
- A 2726
- A 2727
- A 2945
- A 2946
- A 2947
- 66
- 172
- 219
- 334
- 336
- 970
- 1123
- 1512
- 1543
- 1635
- 1678
- 1682
- 1685
- 1727
- 1872