


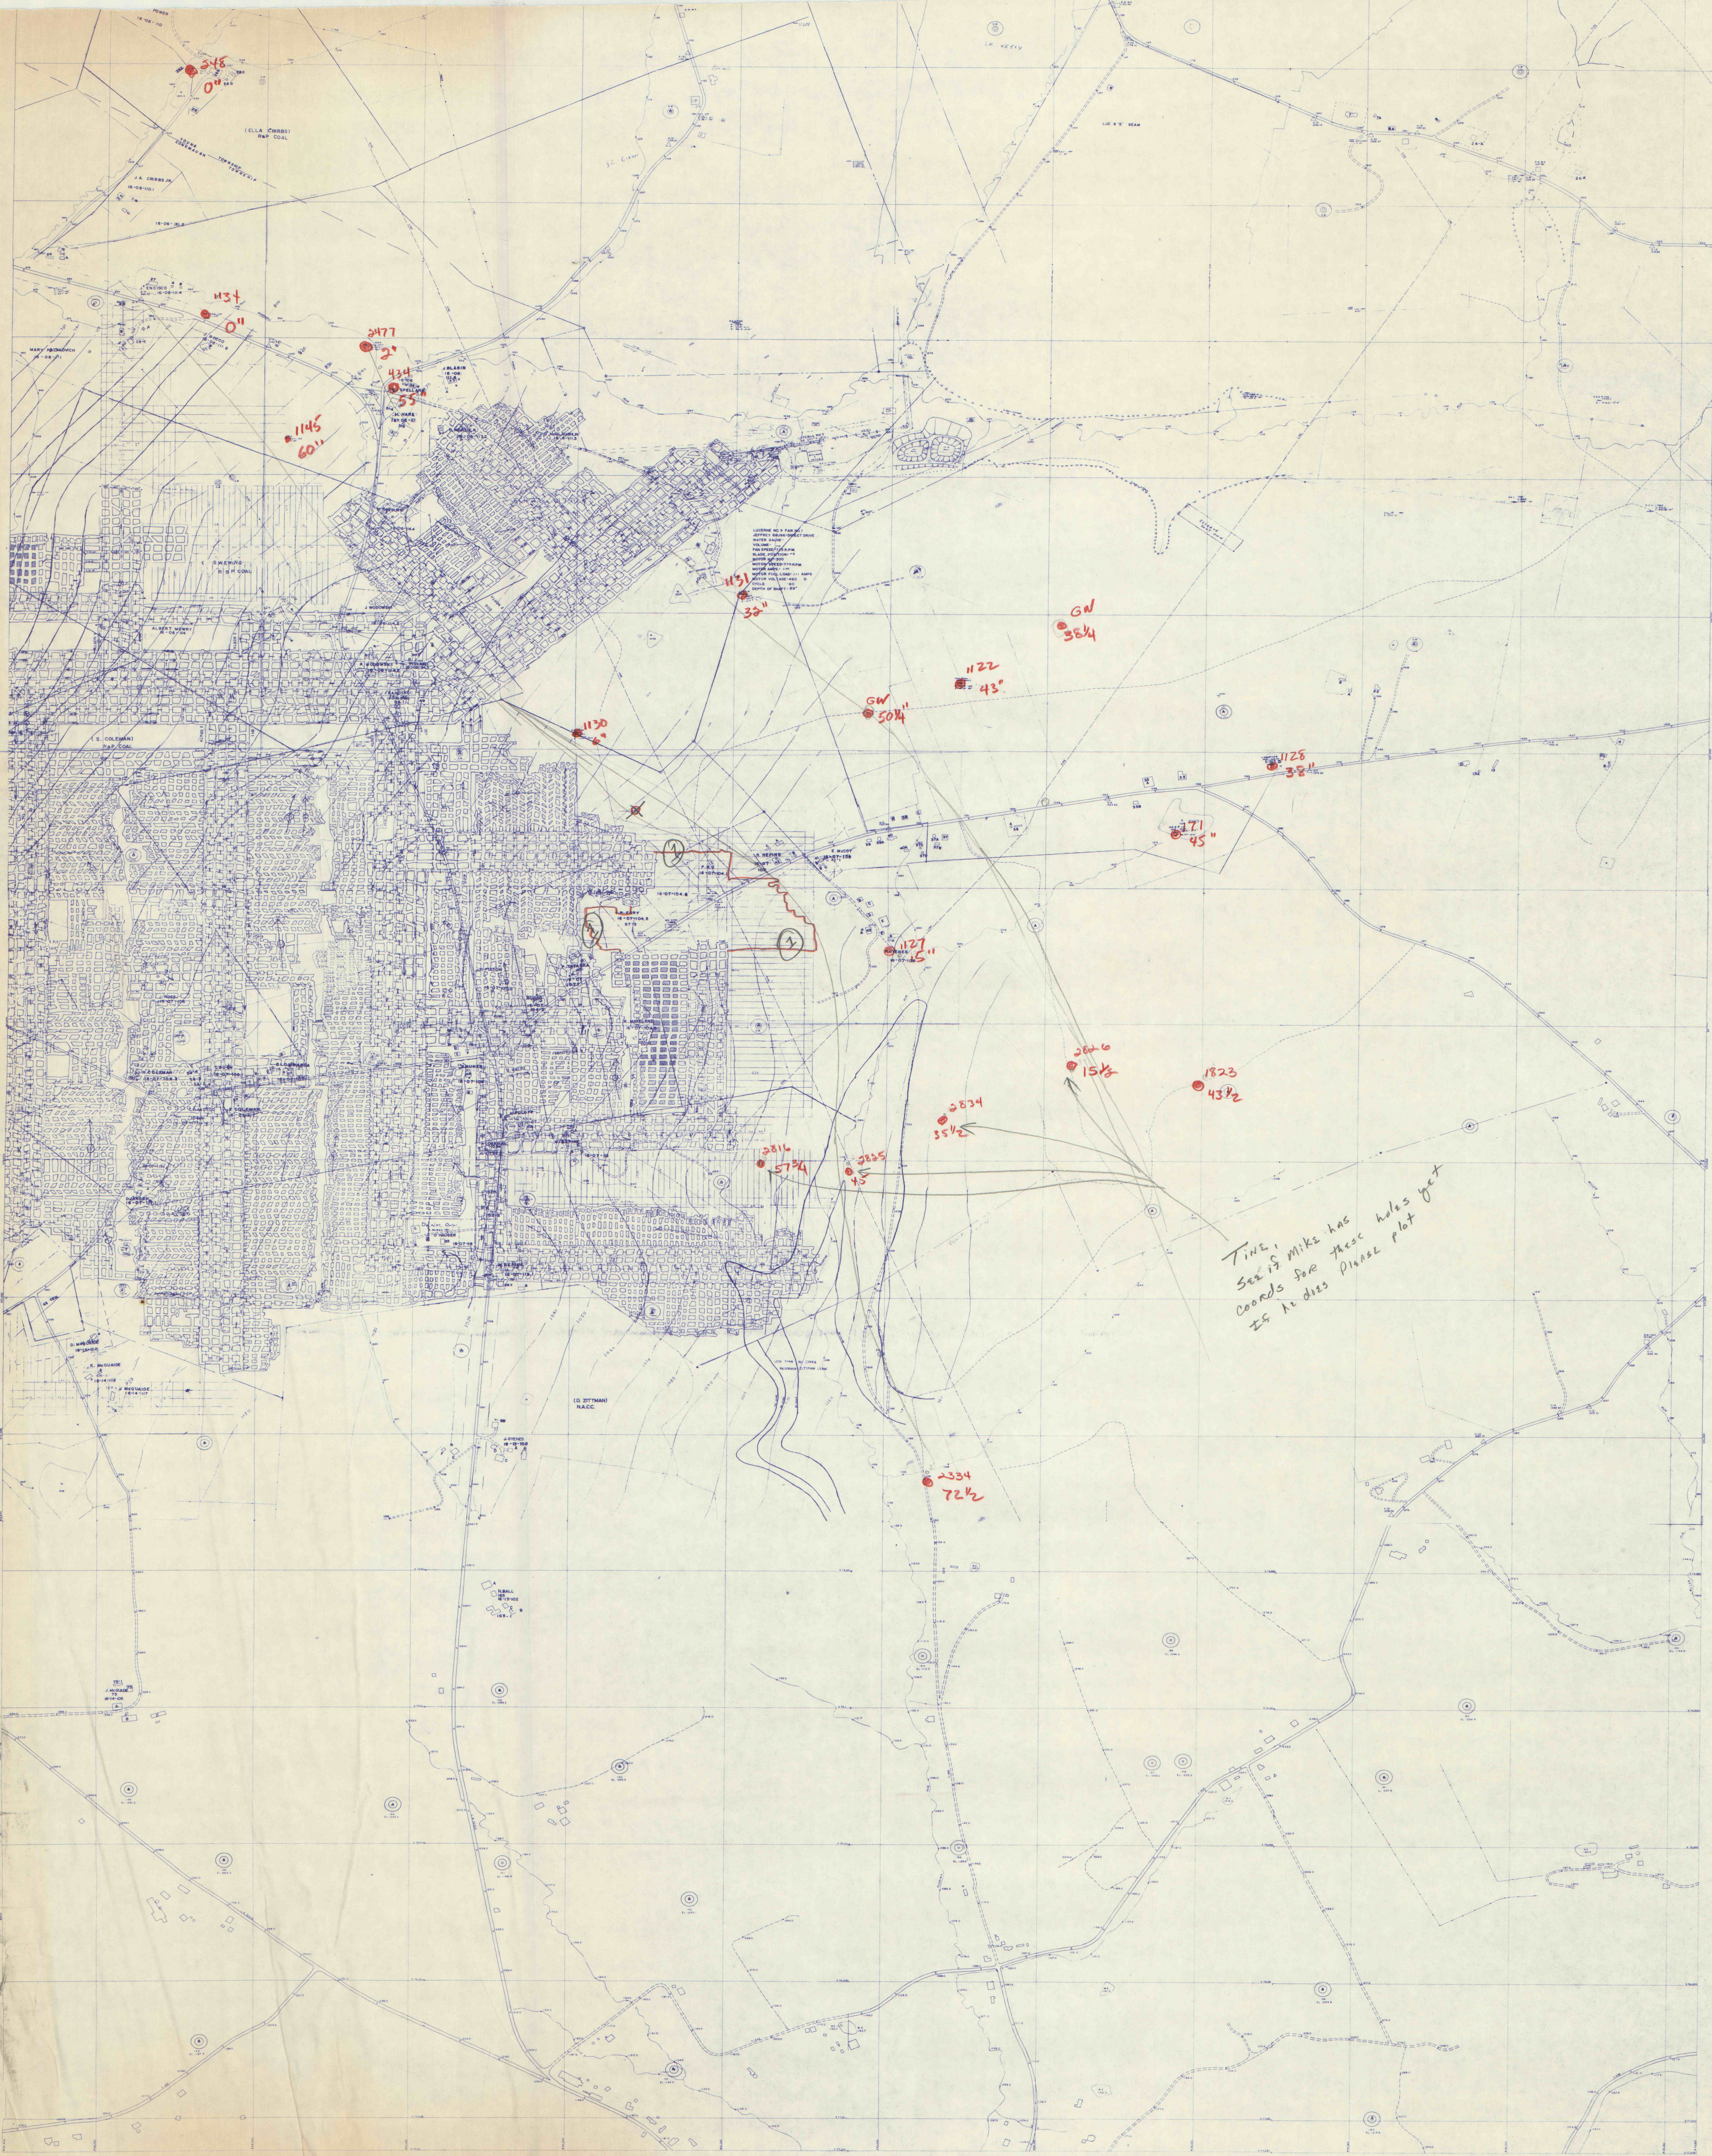

IMAPS# 09681

LUCERNE 9 MINE

DATE

1" =