


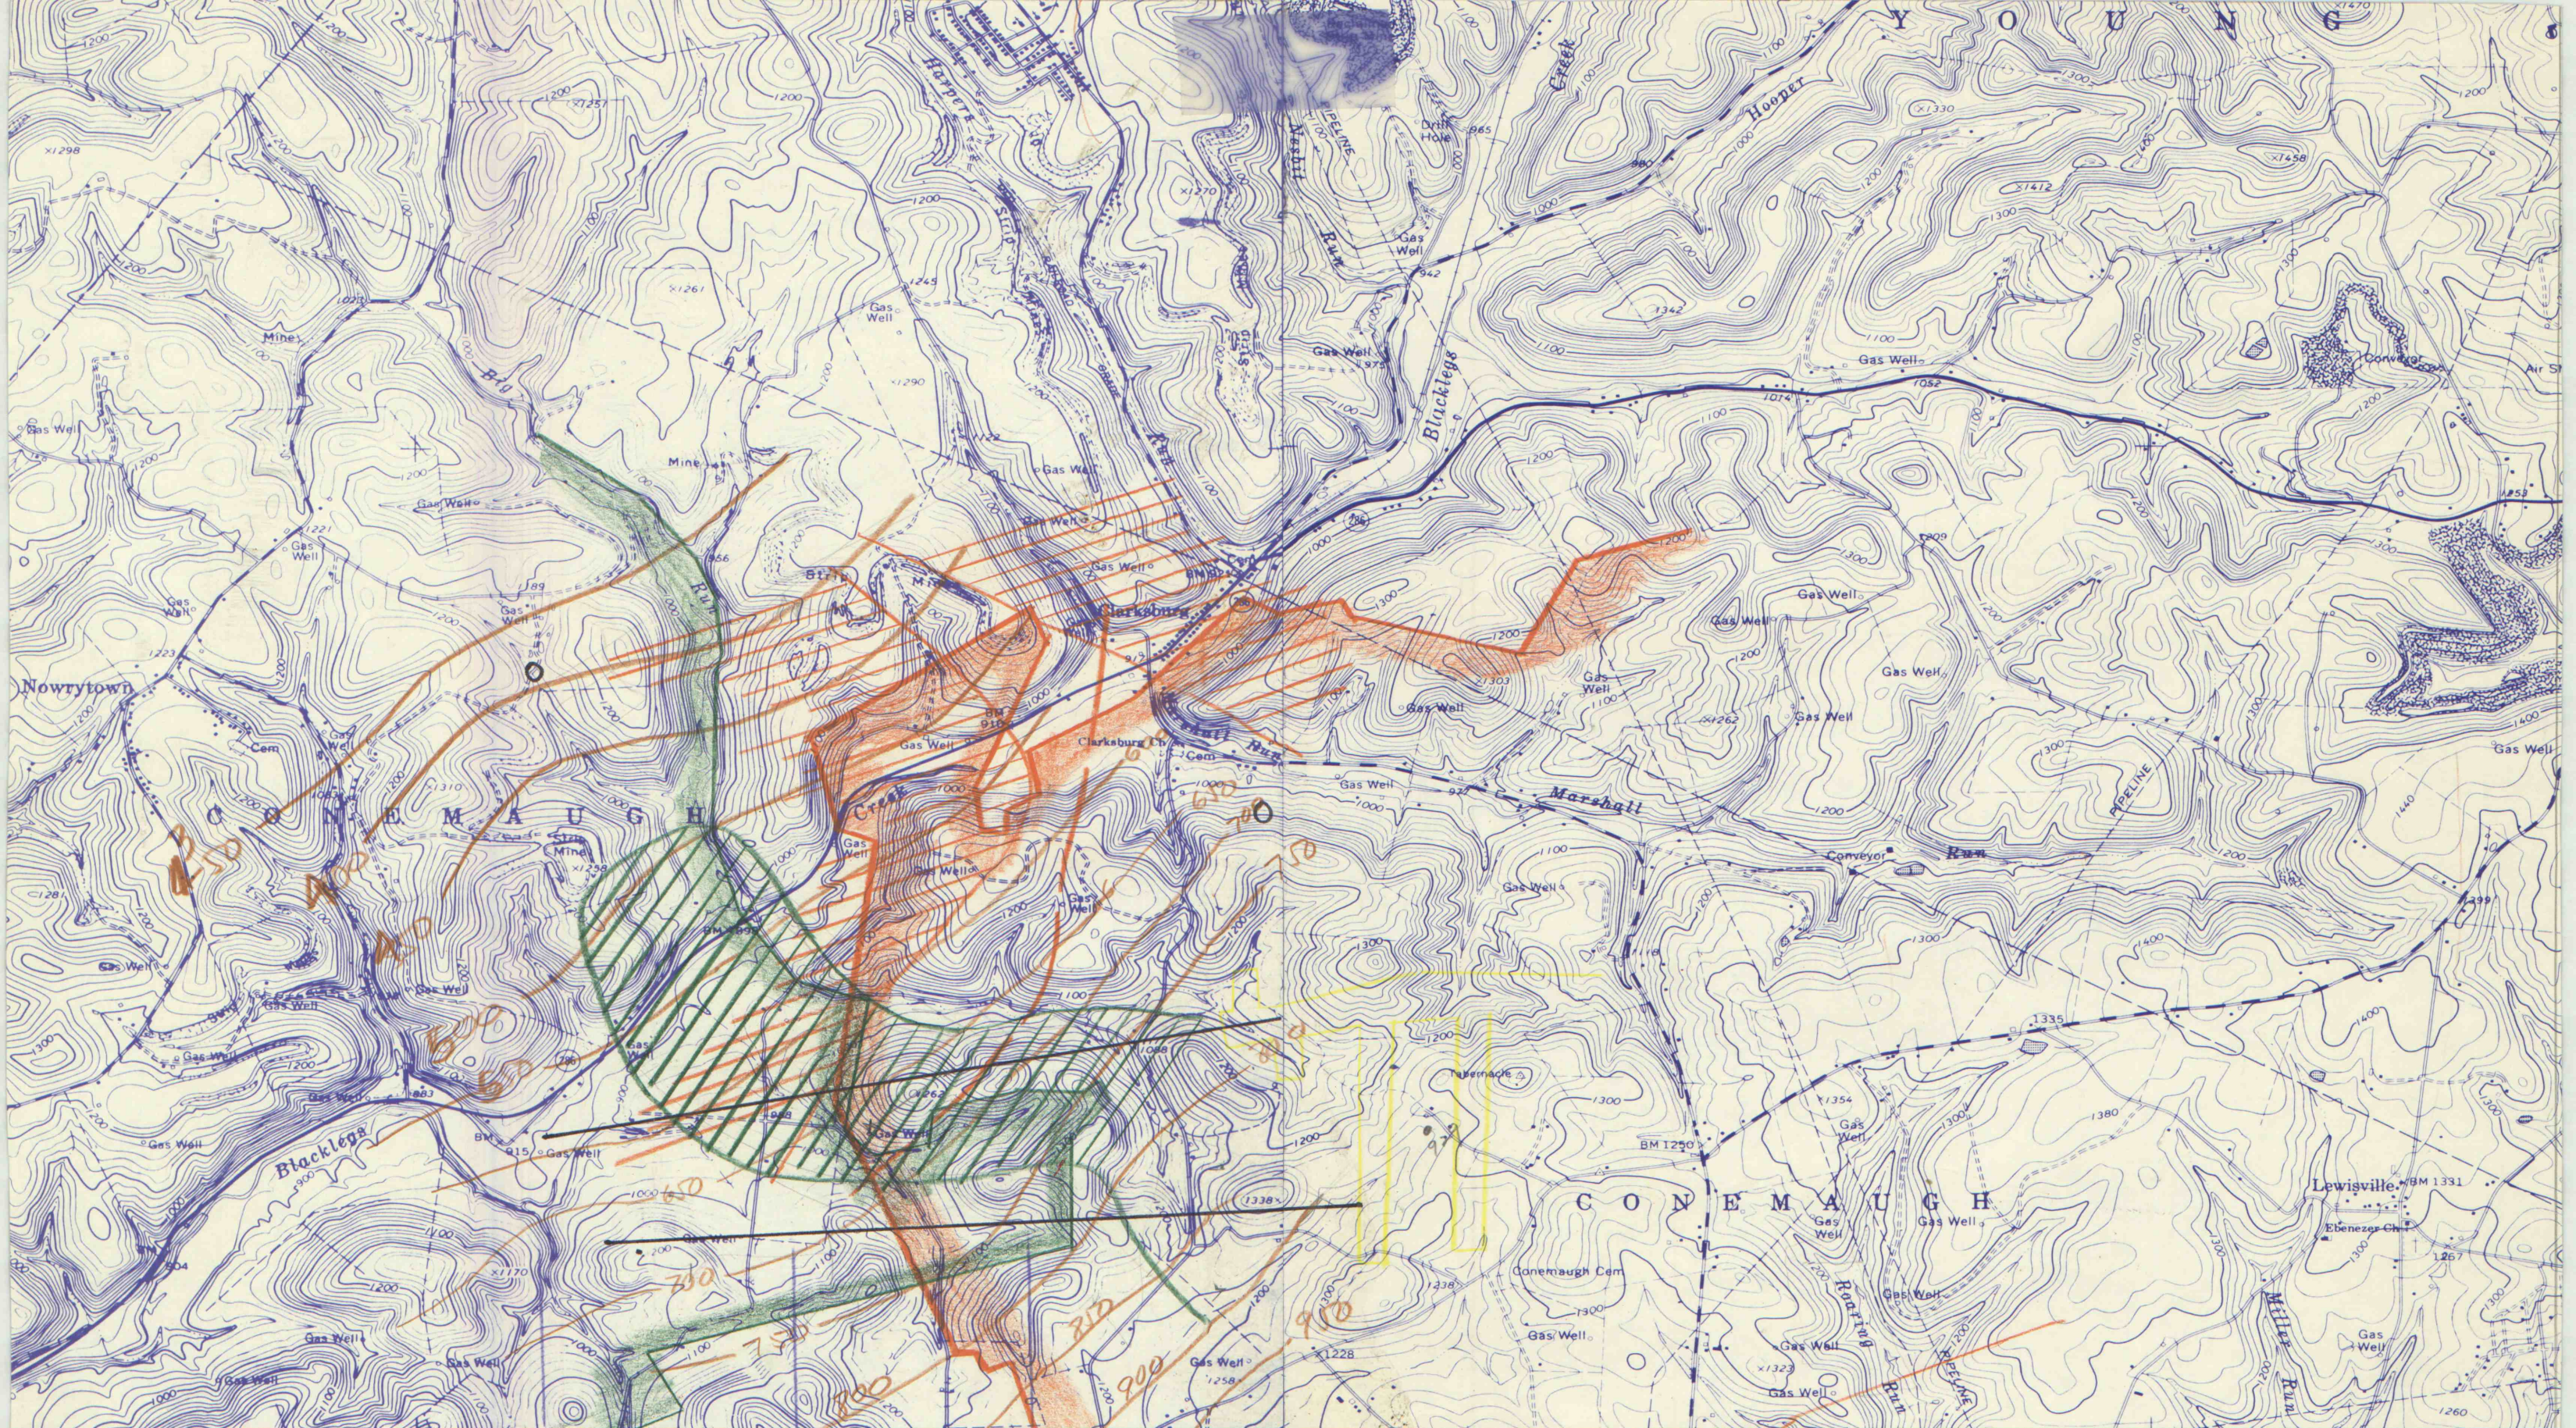

URG

AVONMORE
SCALE 1" = 2000'

Mapped, edited, and published by the Geological Survey
Control by USGS, NOS/NOAA, and USCE

Topography by photogrammetric methods from aerial
photographs taken 1962 and 1963. Field checked 1964
Polyconic projection. 10,000-foot grid ticks based on Pennsylvania

IMAPS#09689

