


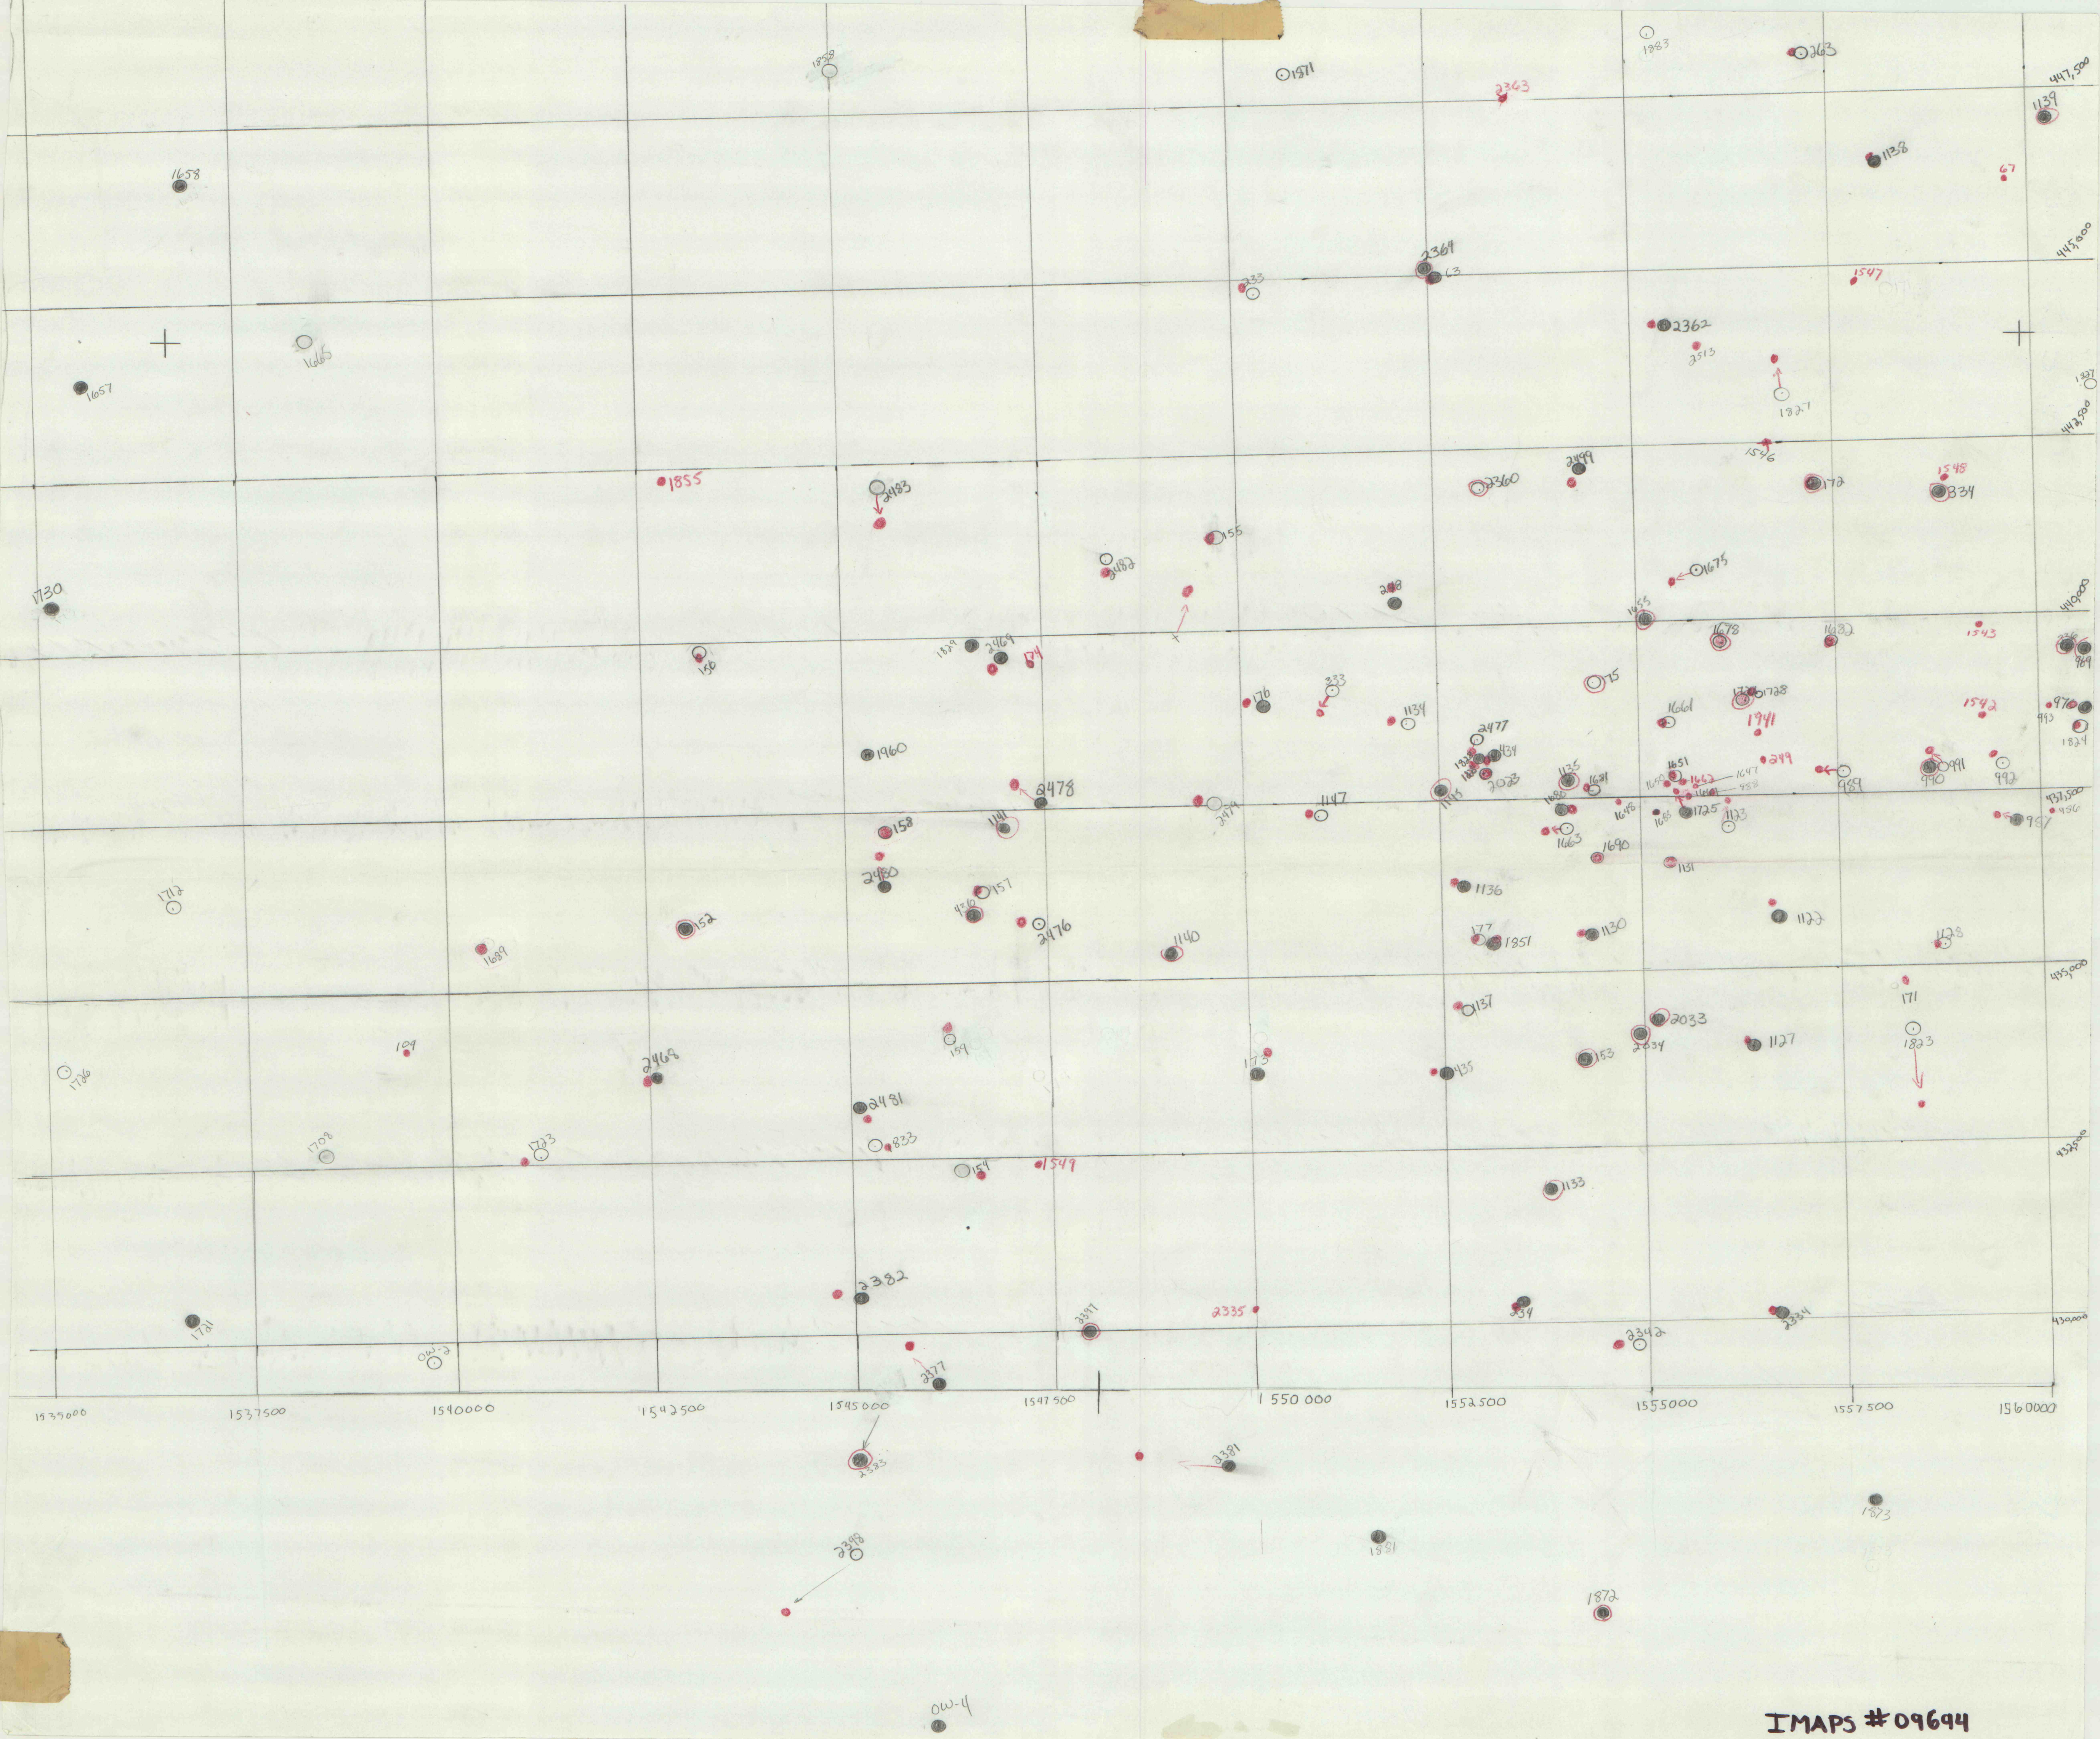

IMAPS # 09694