


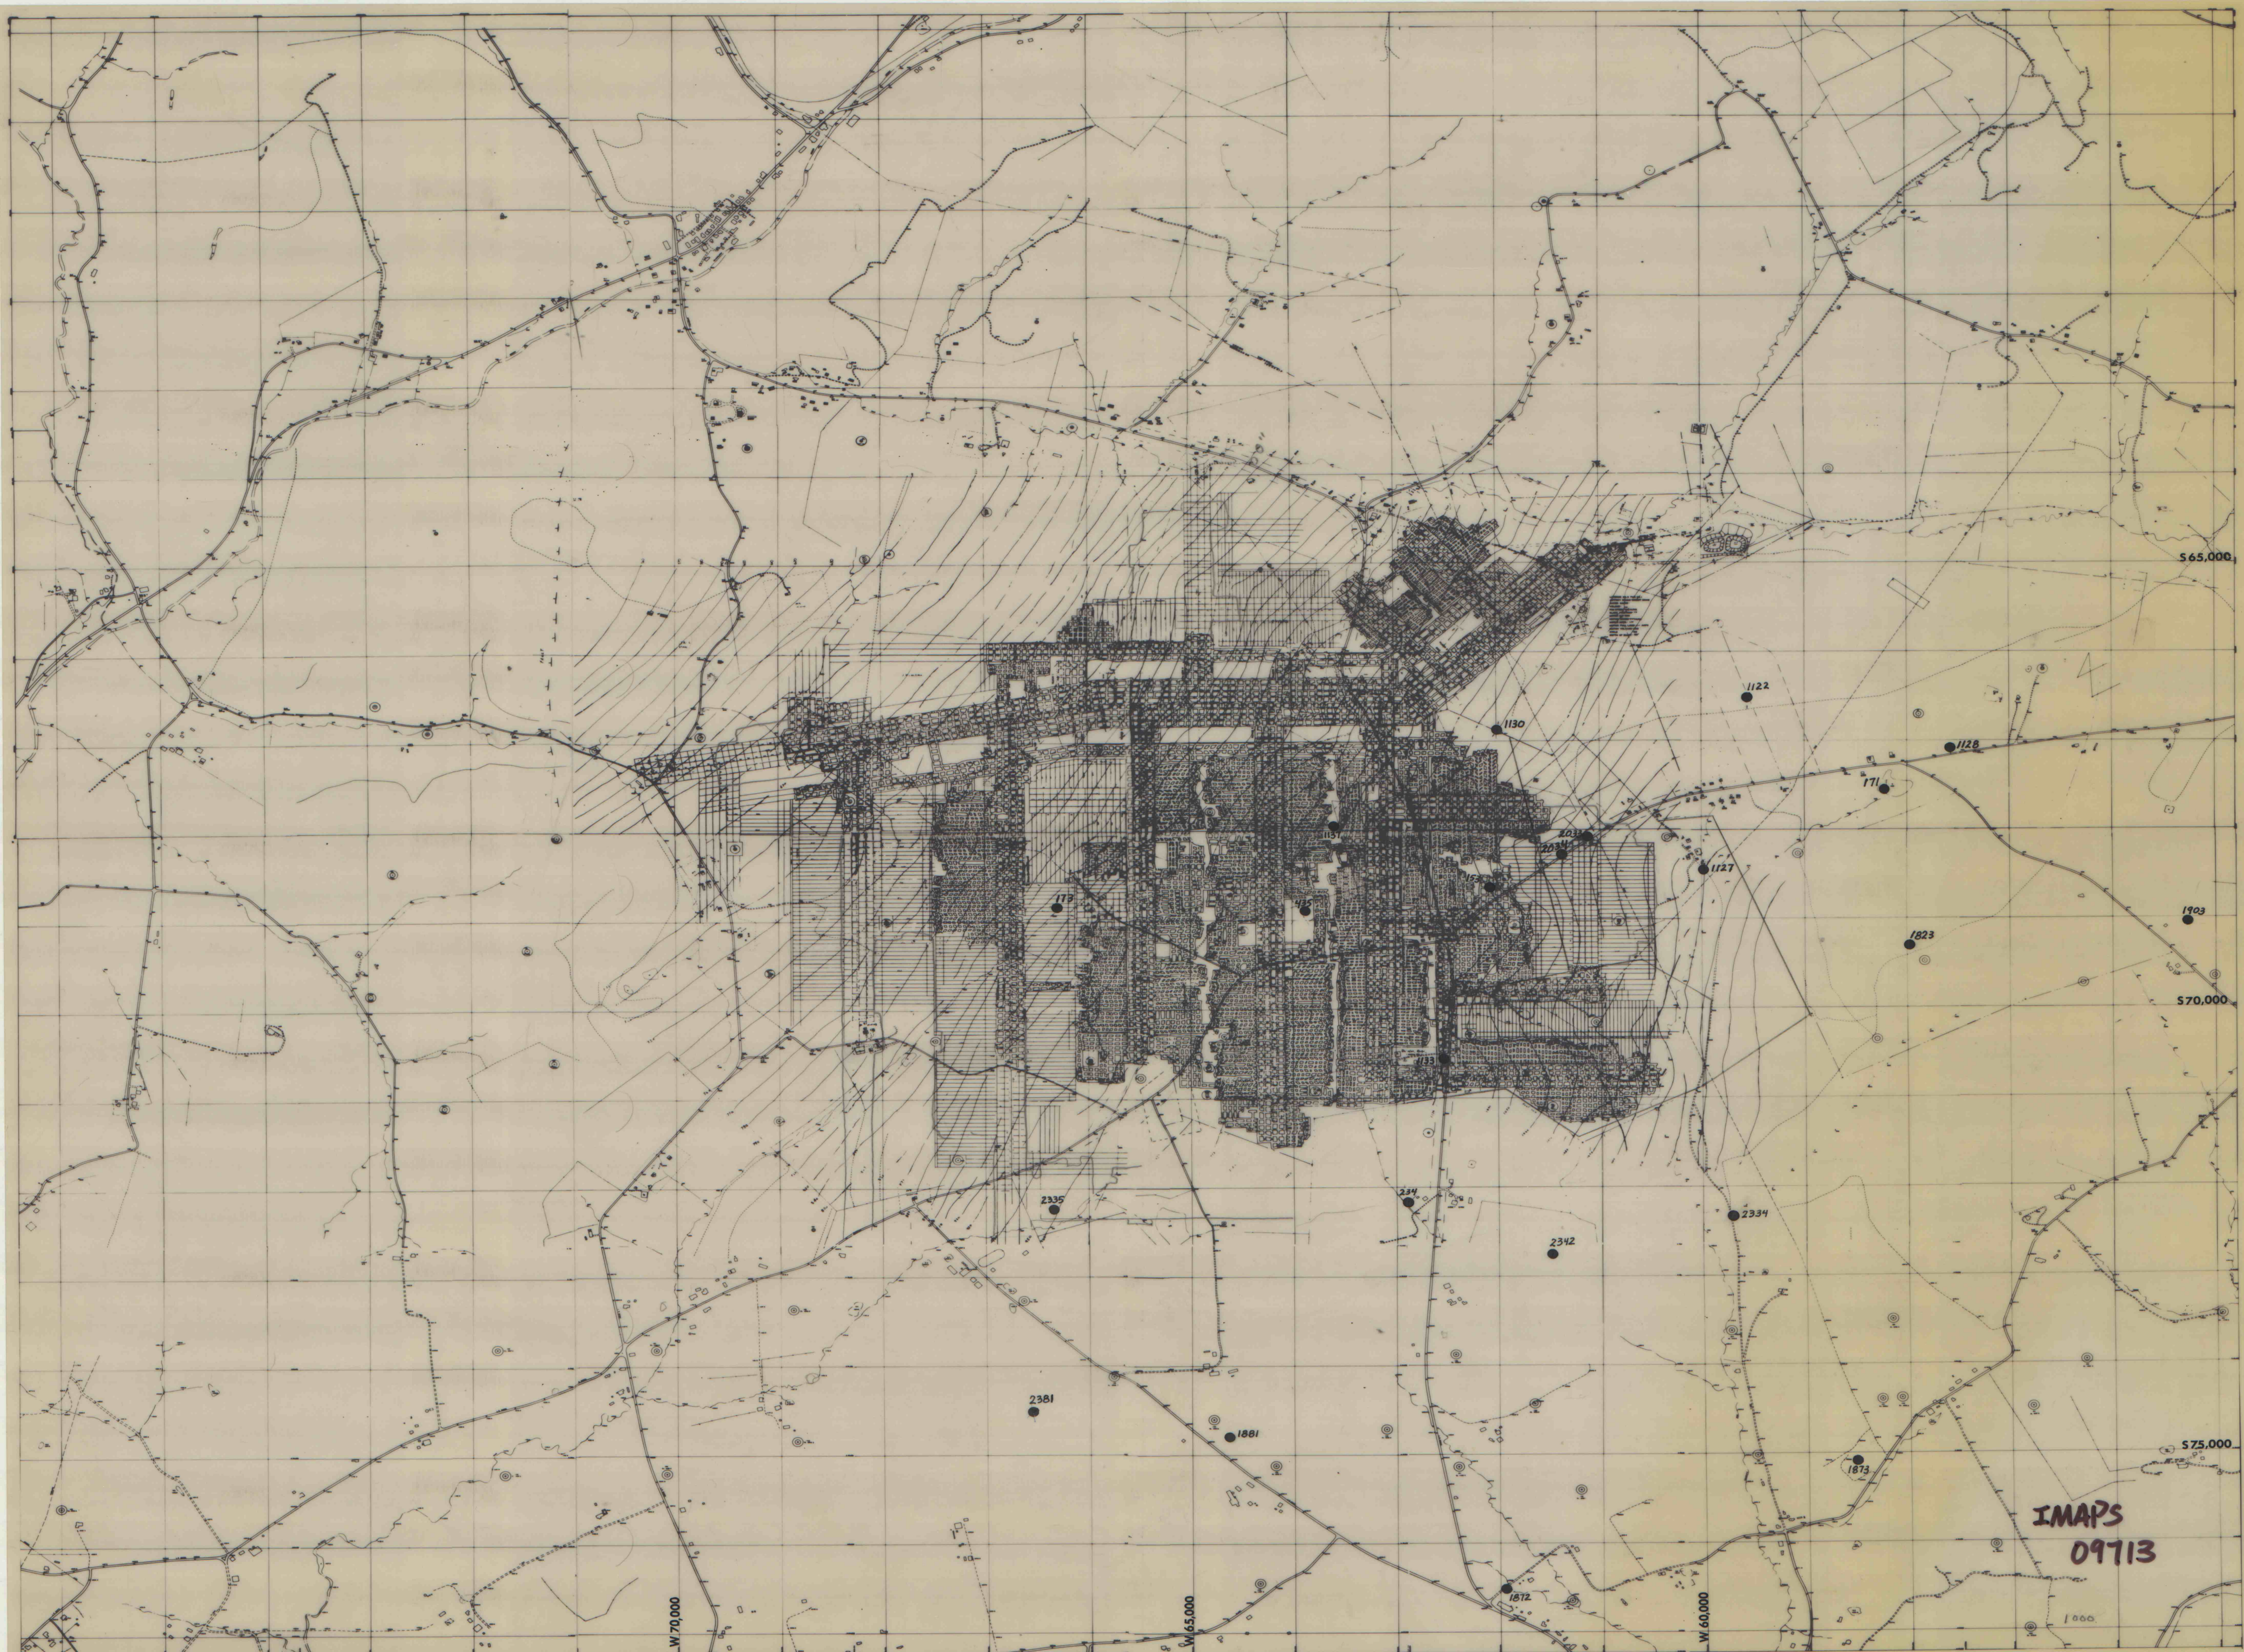

IMAPS
09713