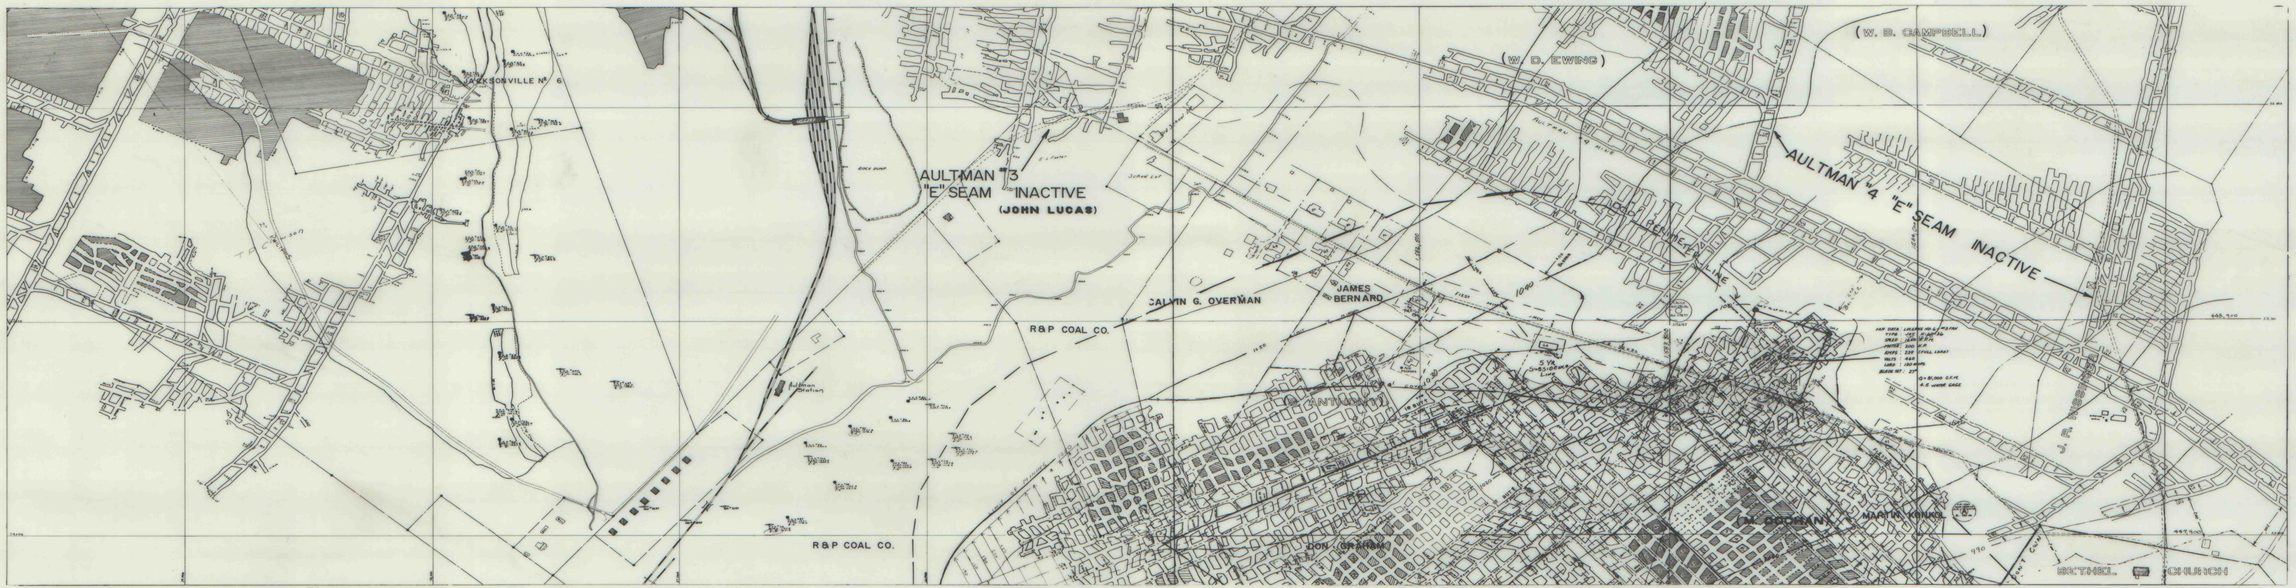

LUCERNE NO. 6 MINE – HELVETIA COAL CO
BLACKLICK & CENTER TWPS., INDIANA CO
SCALE: 1" = 400' DATE: 12/1/88

IMAPS 09727