


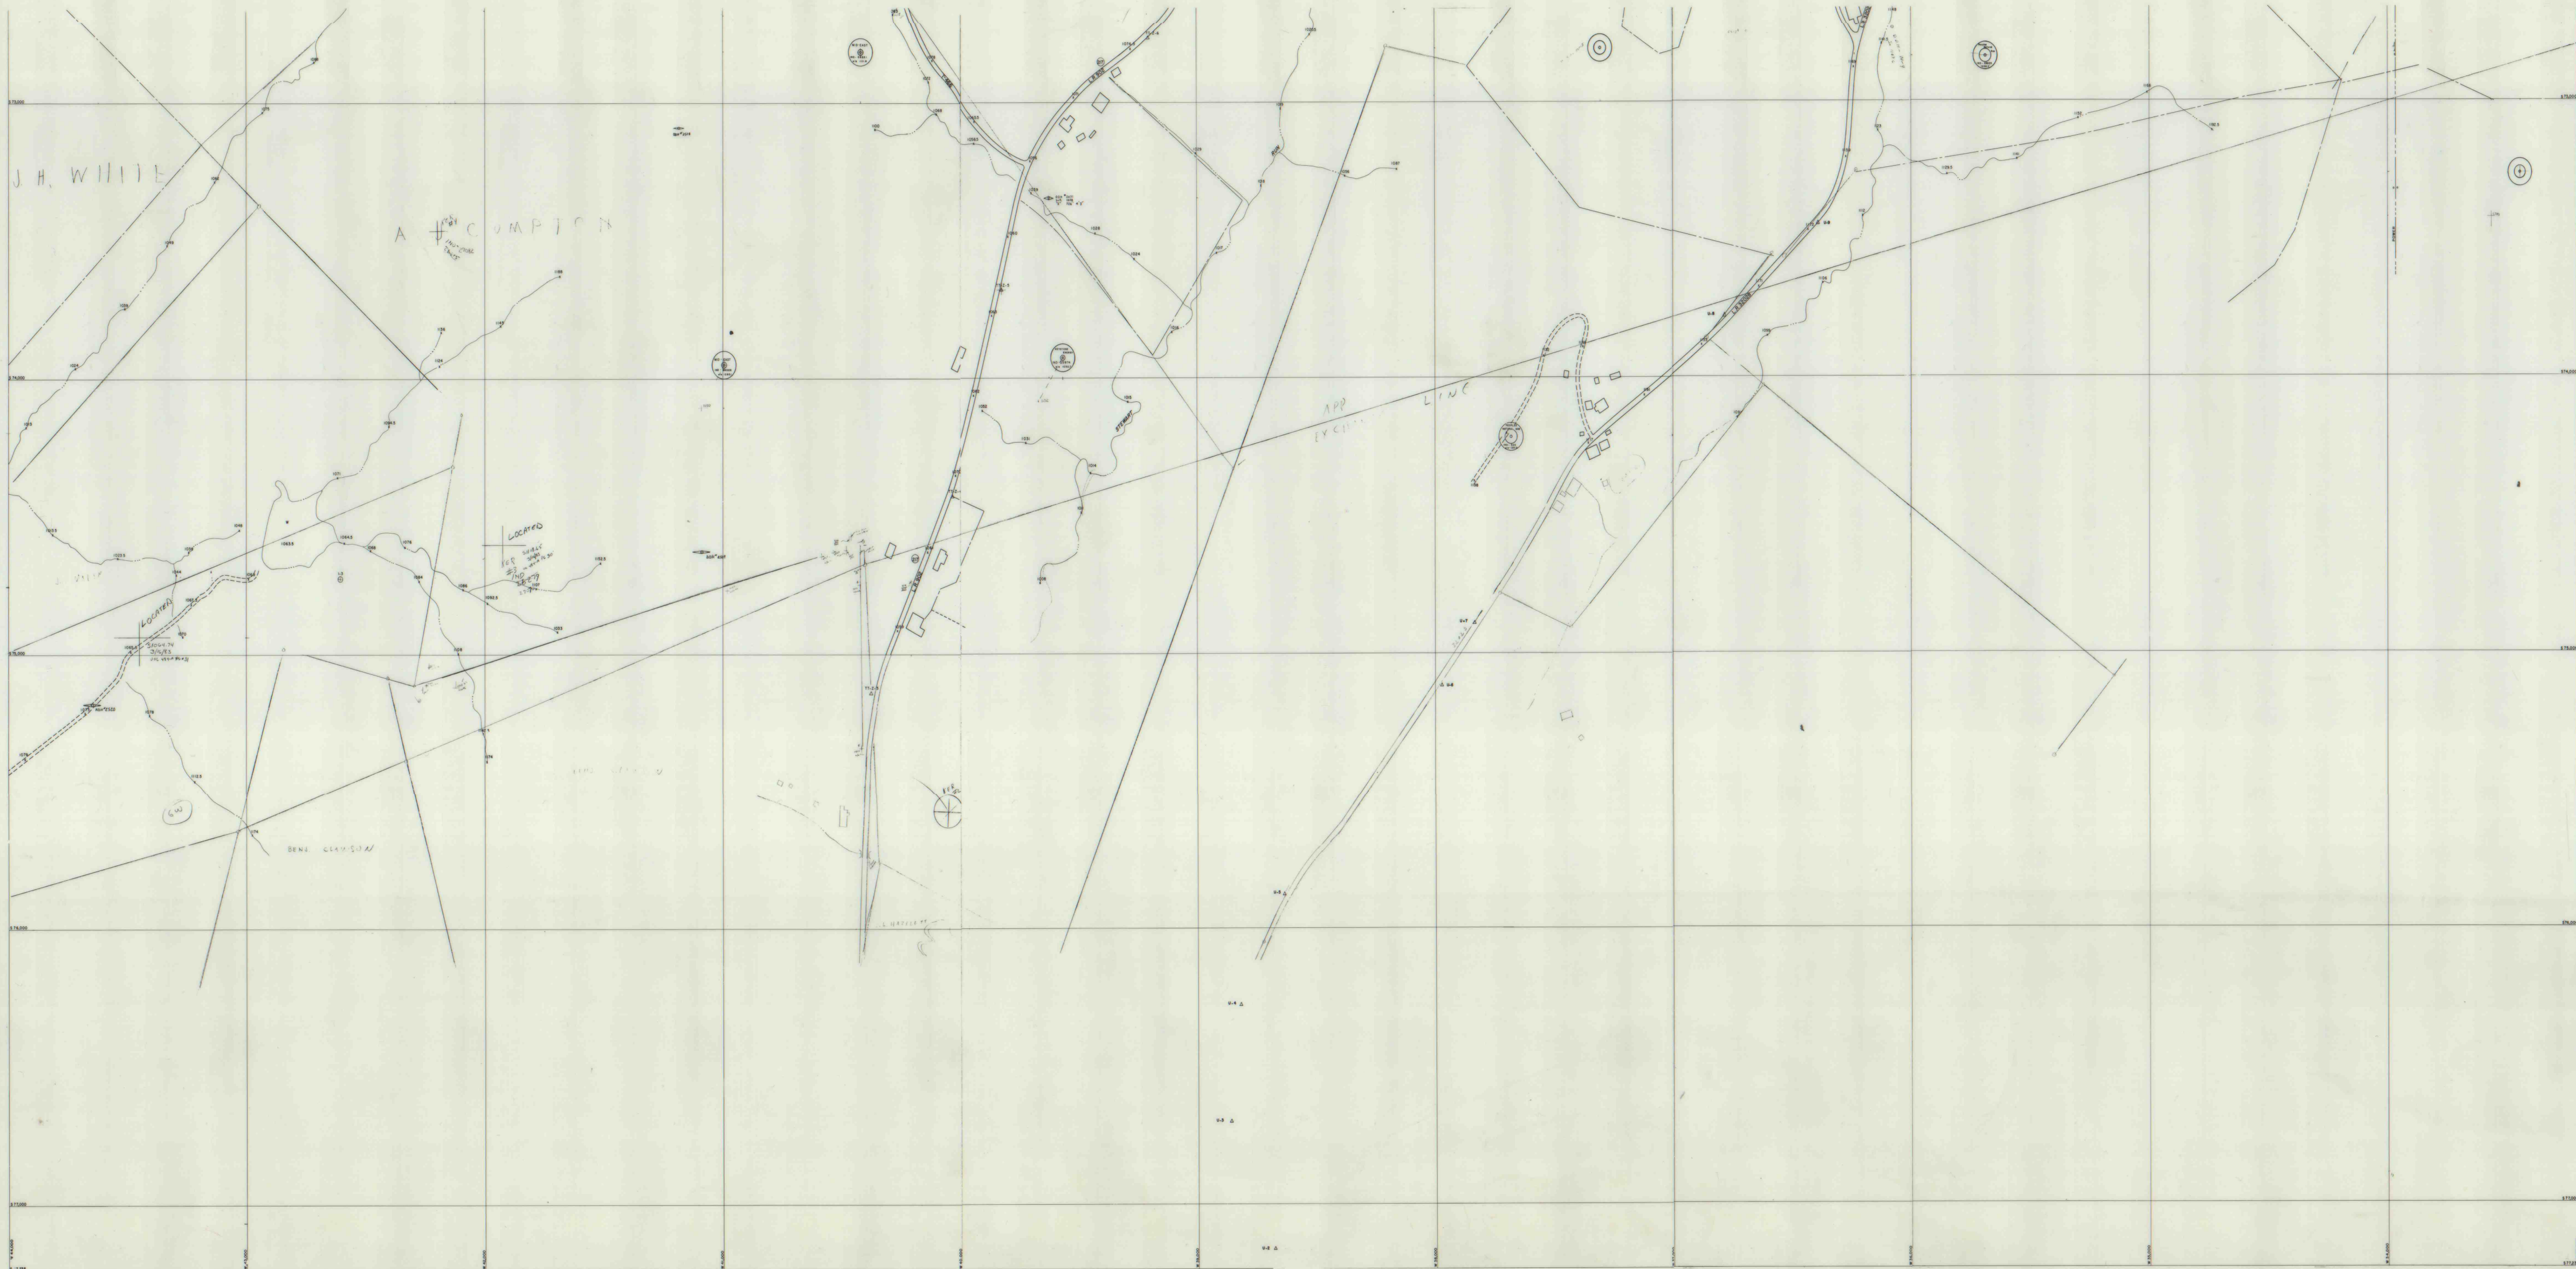

I MAP # 09744 05-1

LUCERNE NO. 6 MINE - HELVETIA COAL CO.
BLACKLICK & CENTER TWPS., INDIANA CO.
SCALE: DATE: