


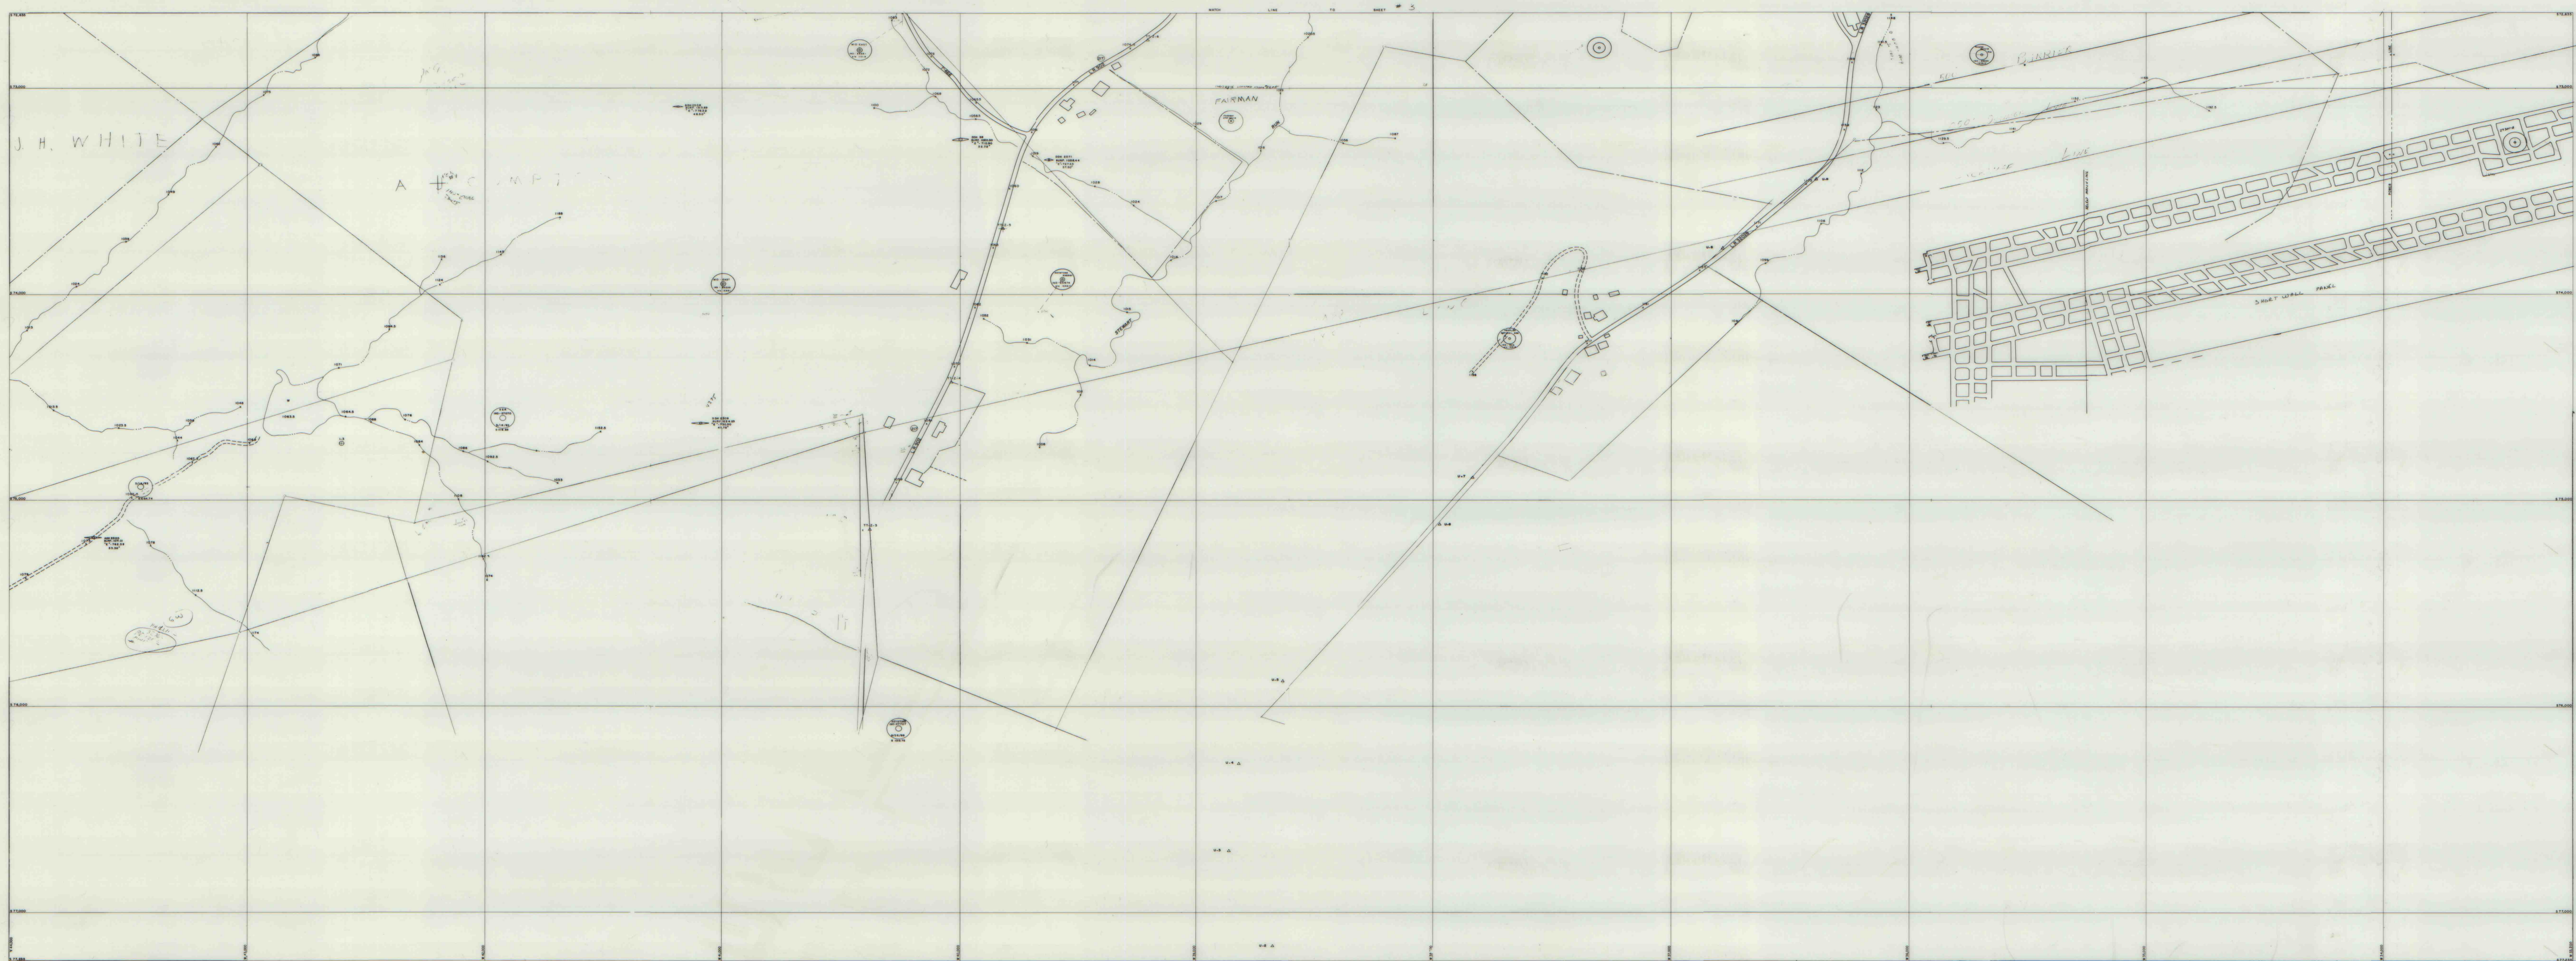

IMAP # 09745 05-2

LUCERNE NO. 6 MINE - HELVETIA COAL CO.
BLACKLICK & CENTER TWP., INDIANA CO.
SCALE: 1" = 400' DATE: 6/1/89

