


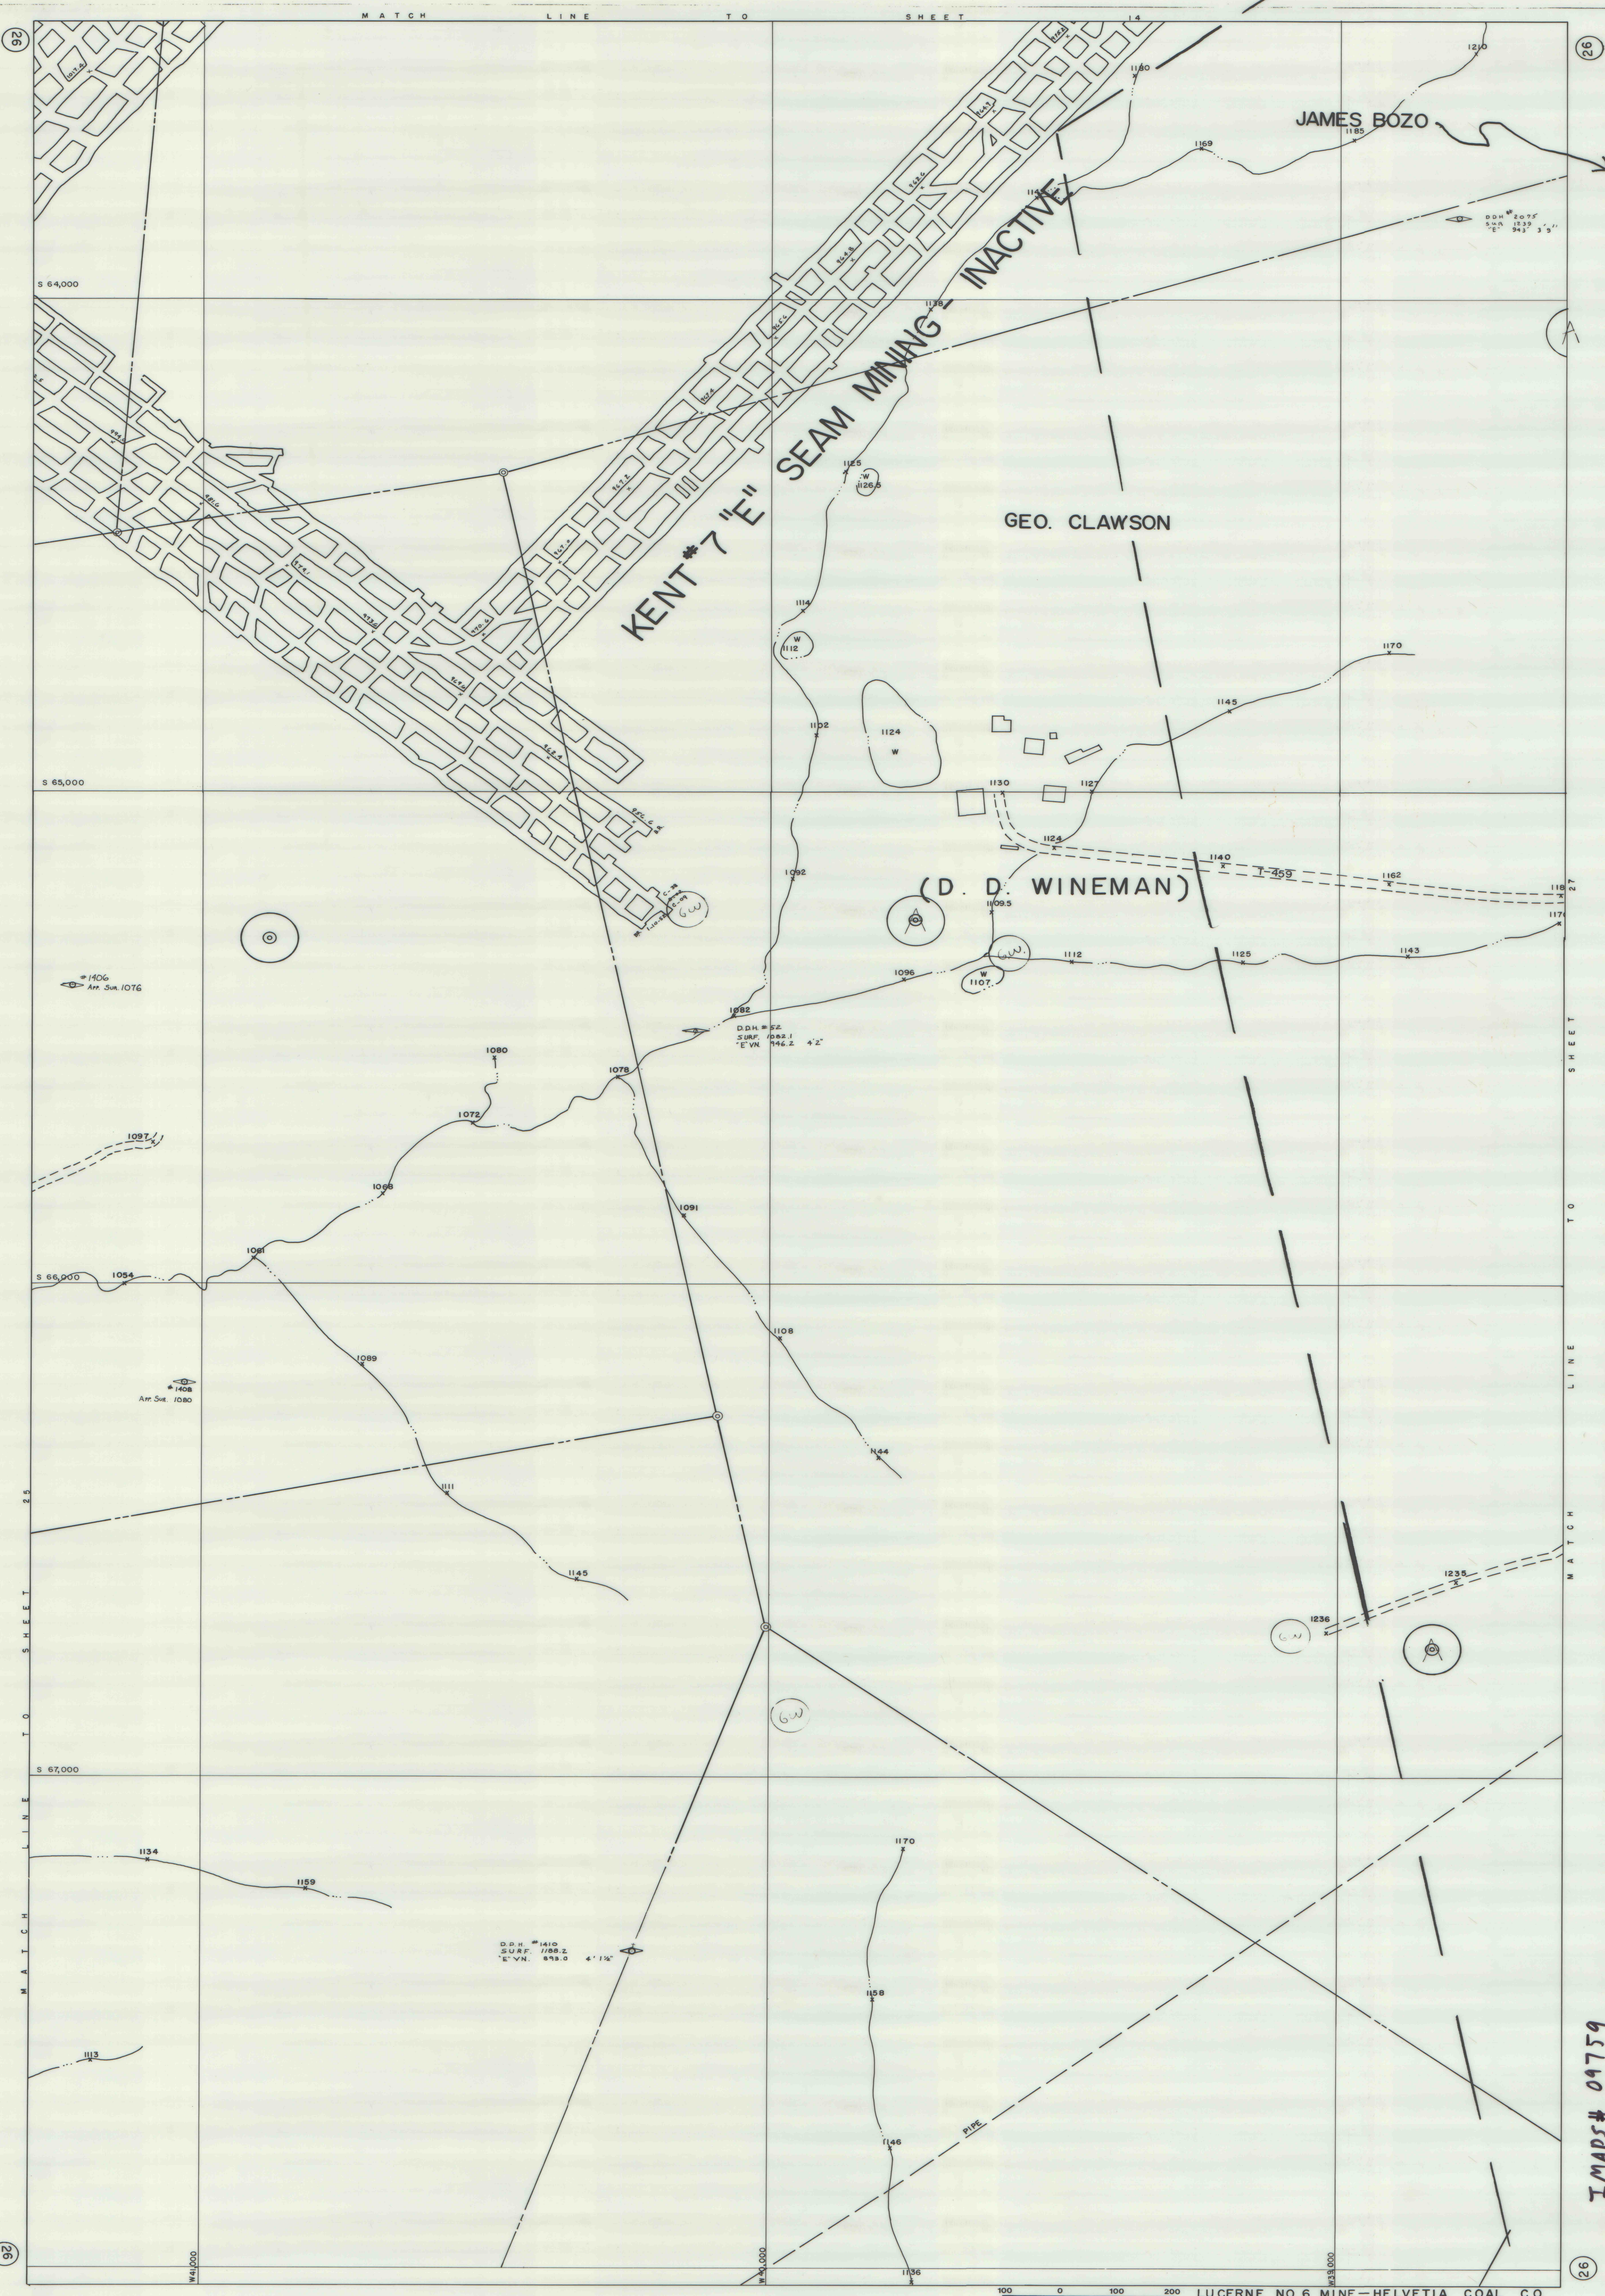

IMAPS# 09759