



LUCERNE NO. 6E RESERVE


ORIGINAL MAINFRAME DATA

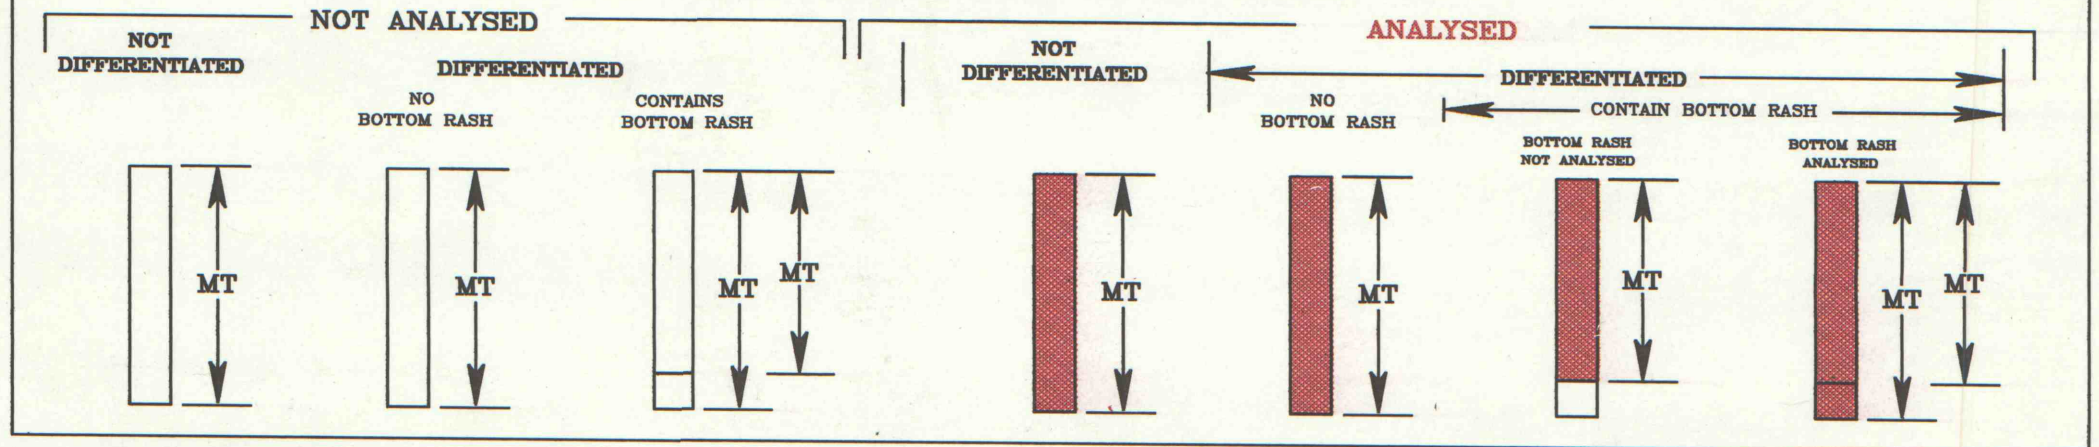

REVISED MAINFRAME DATA

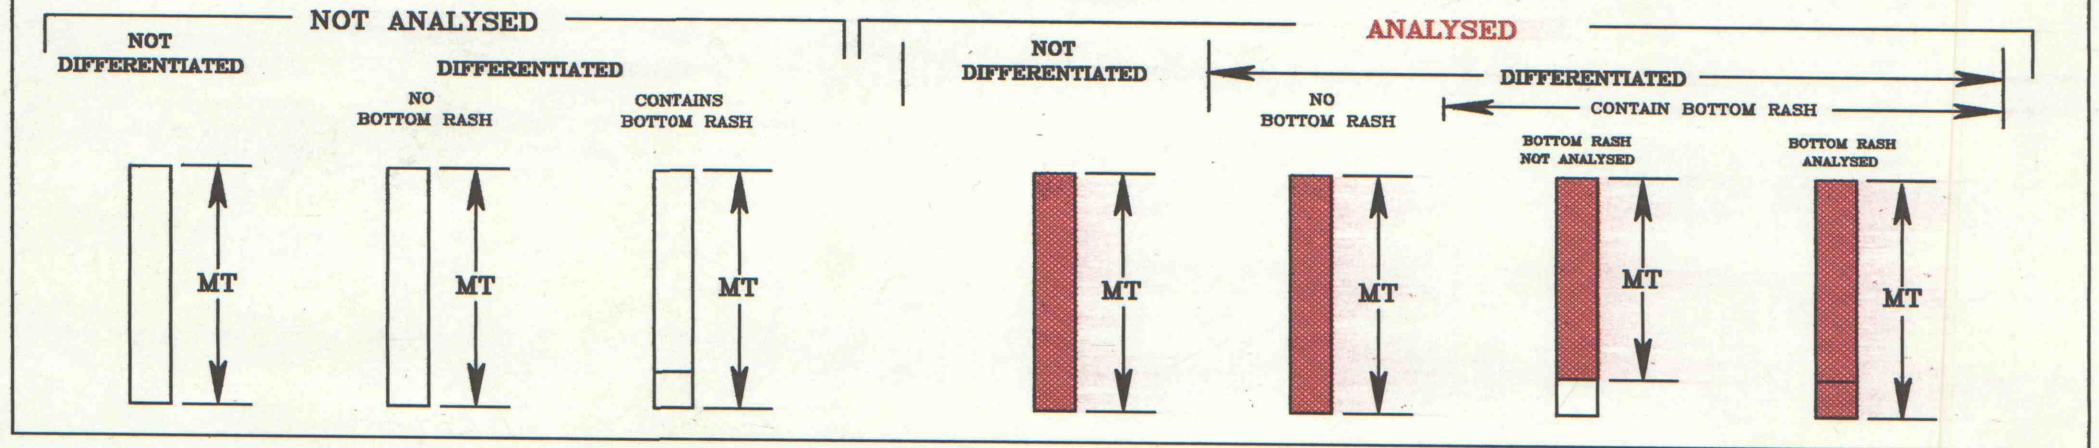


L:\COALPTS\LUC6E020.PTC

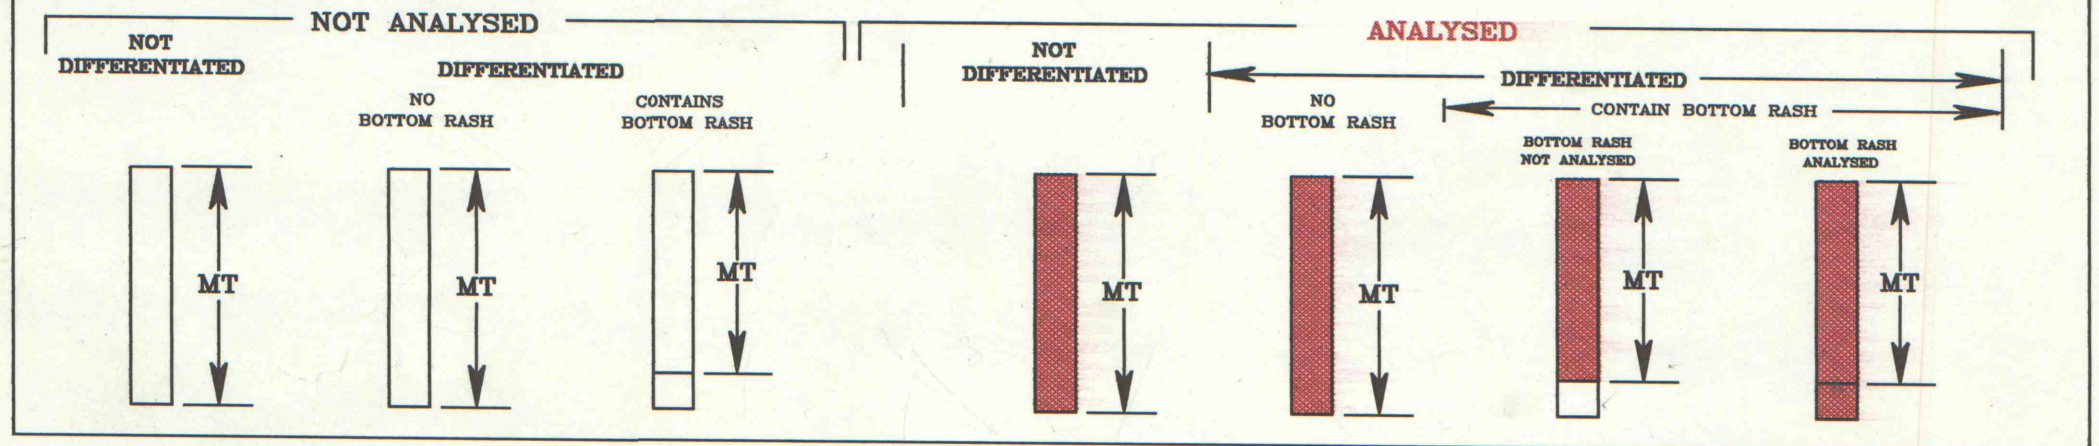

MT = MINEABLE THICKNESS

TOTAL THICKNESS = ROCK-TO-ROCK THICKNESS IN ALL CASES

 ANALYSED THICKNESS

IMAPS # 09789