


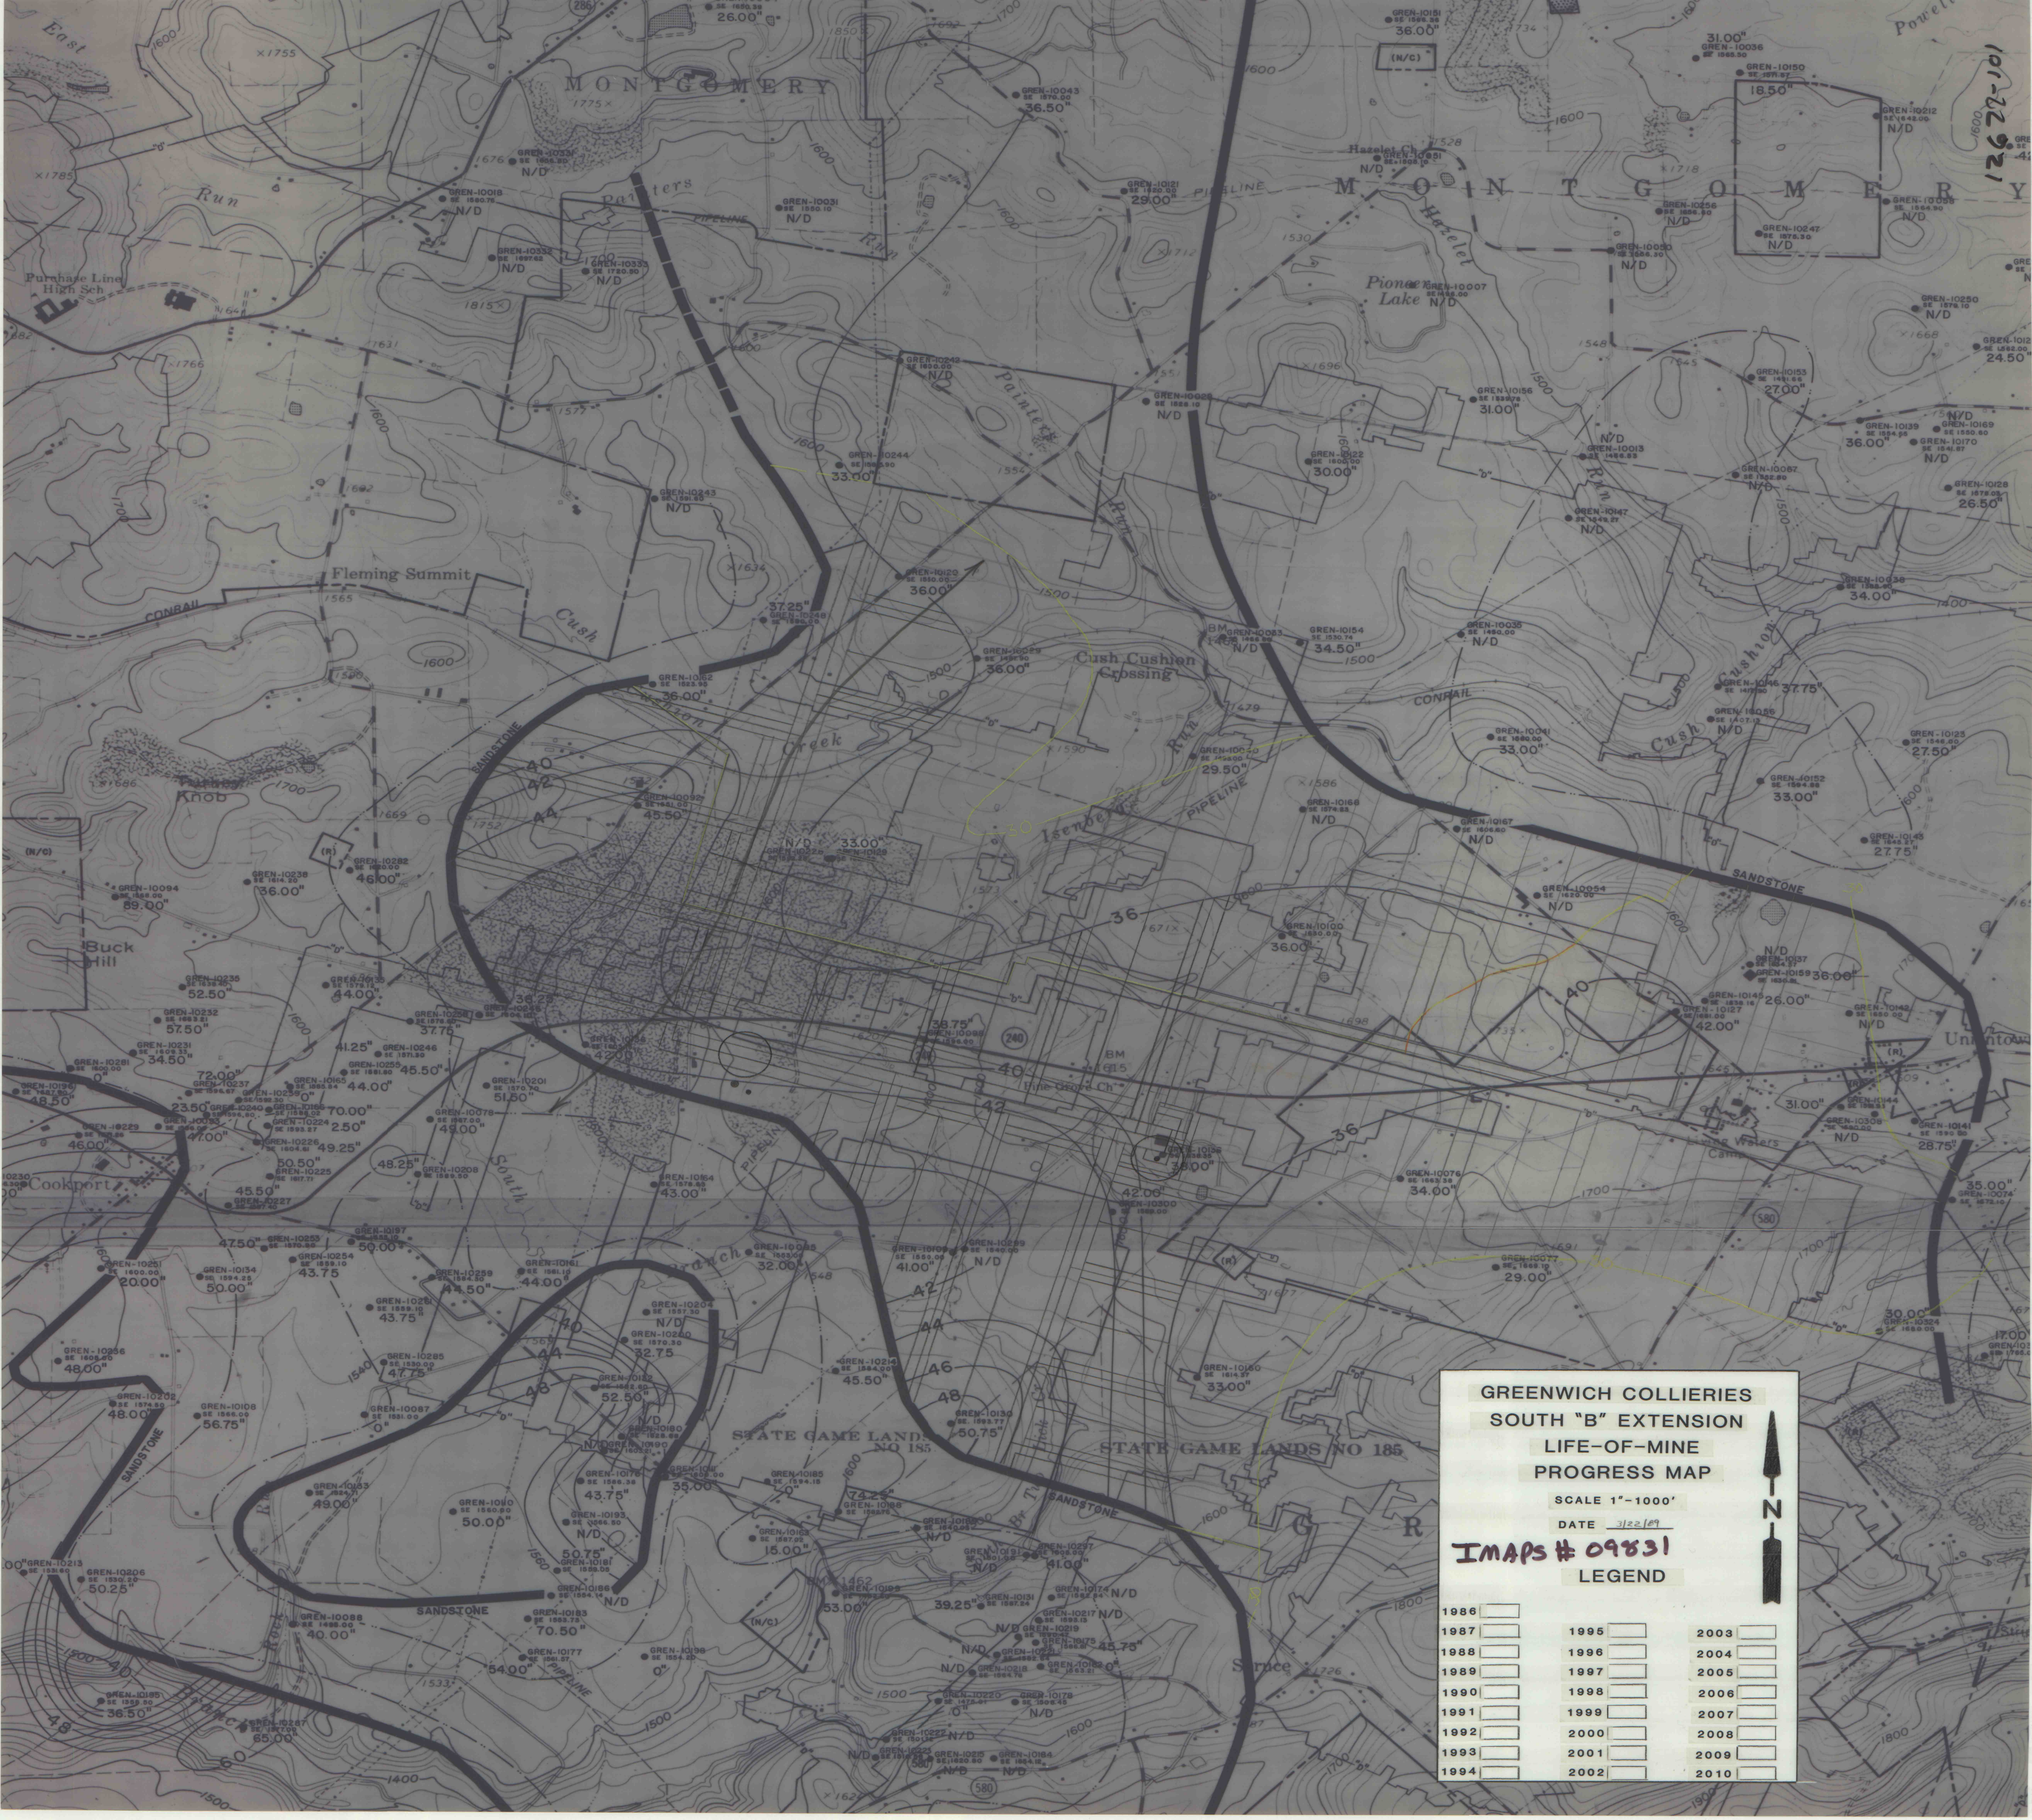

GREENWICH COLLIERIES
SOUTH "B" EXTENSION
LIFE-OF-MINE
PROGRESS MAP

SCALE 1"=1000'
DATE 3/22/89

IMAPS # 09831

LEGEND

1986		1995		2003	
1987		1996		2004	
1988		1997		2005	
1989		1998		2006	
1990		1999		2007	
1991		2000		2008	
1992		2001		2009	
1993		2002		2010	
1994					