


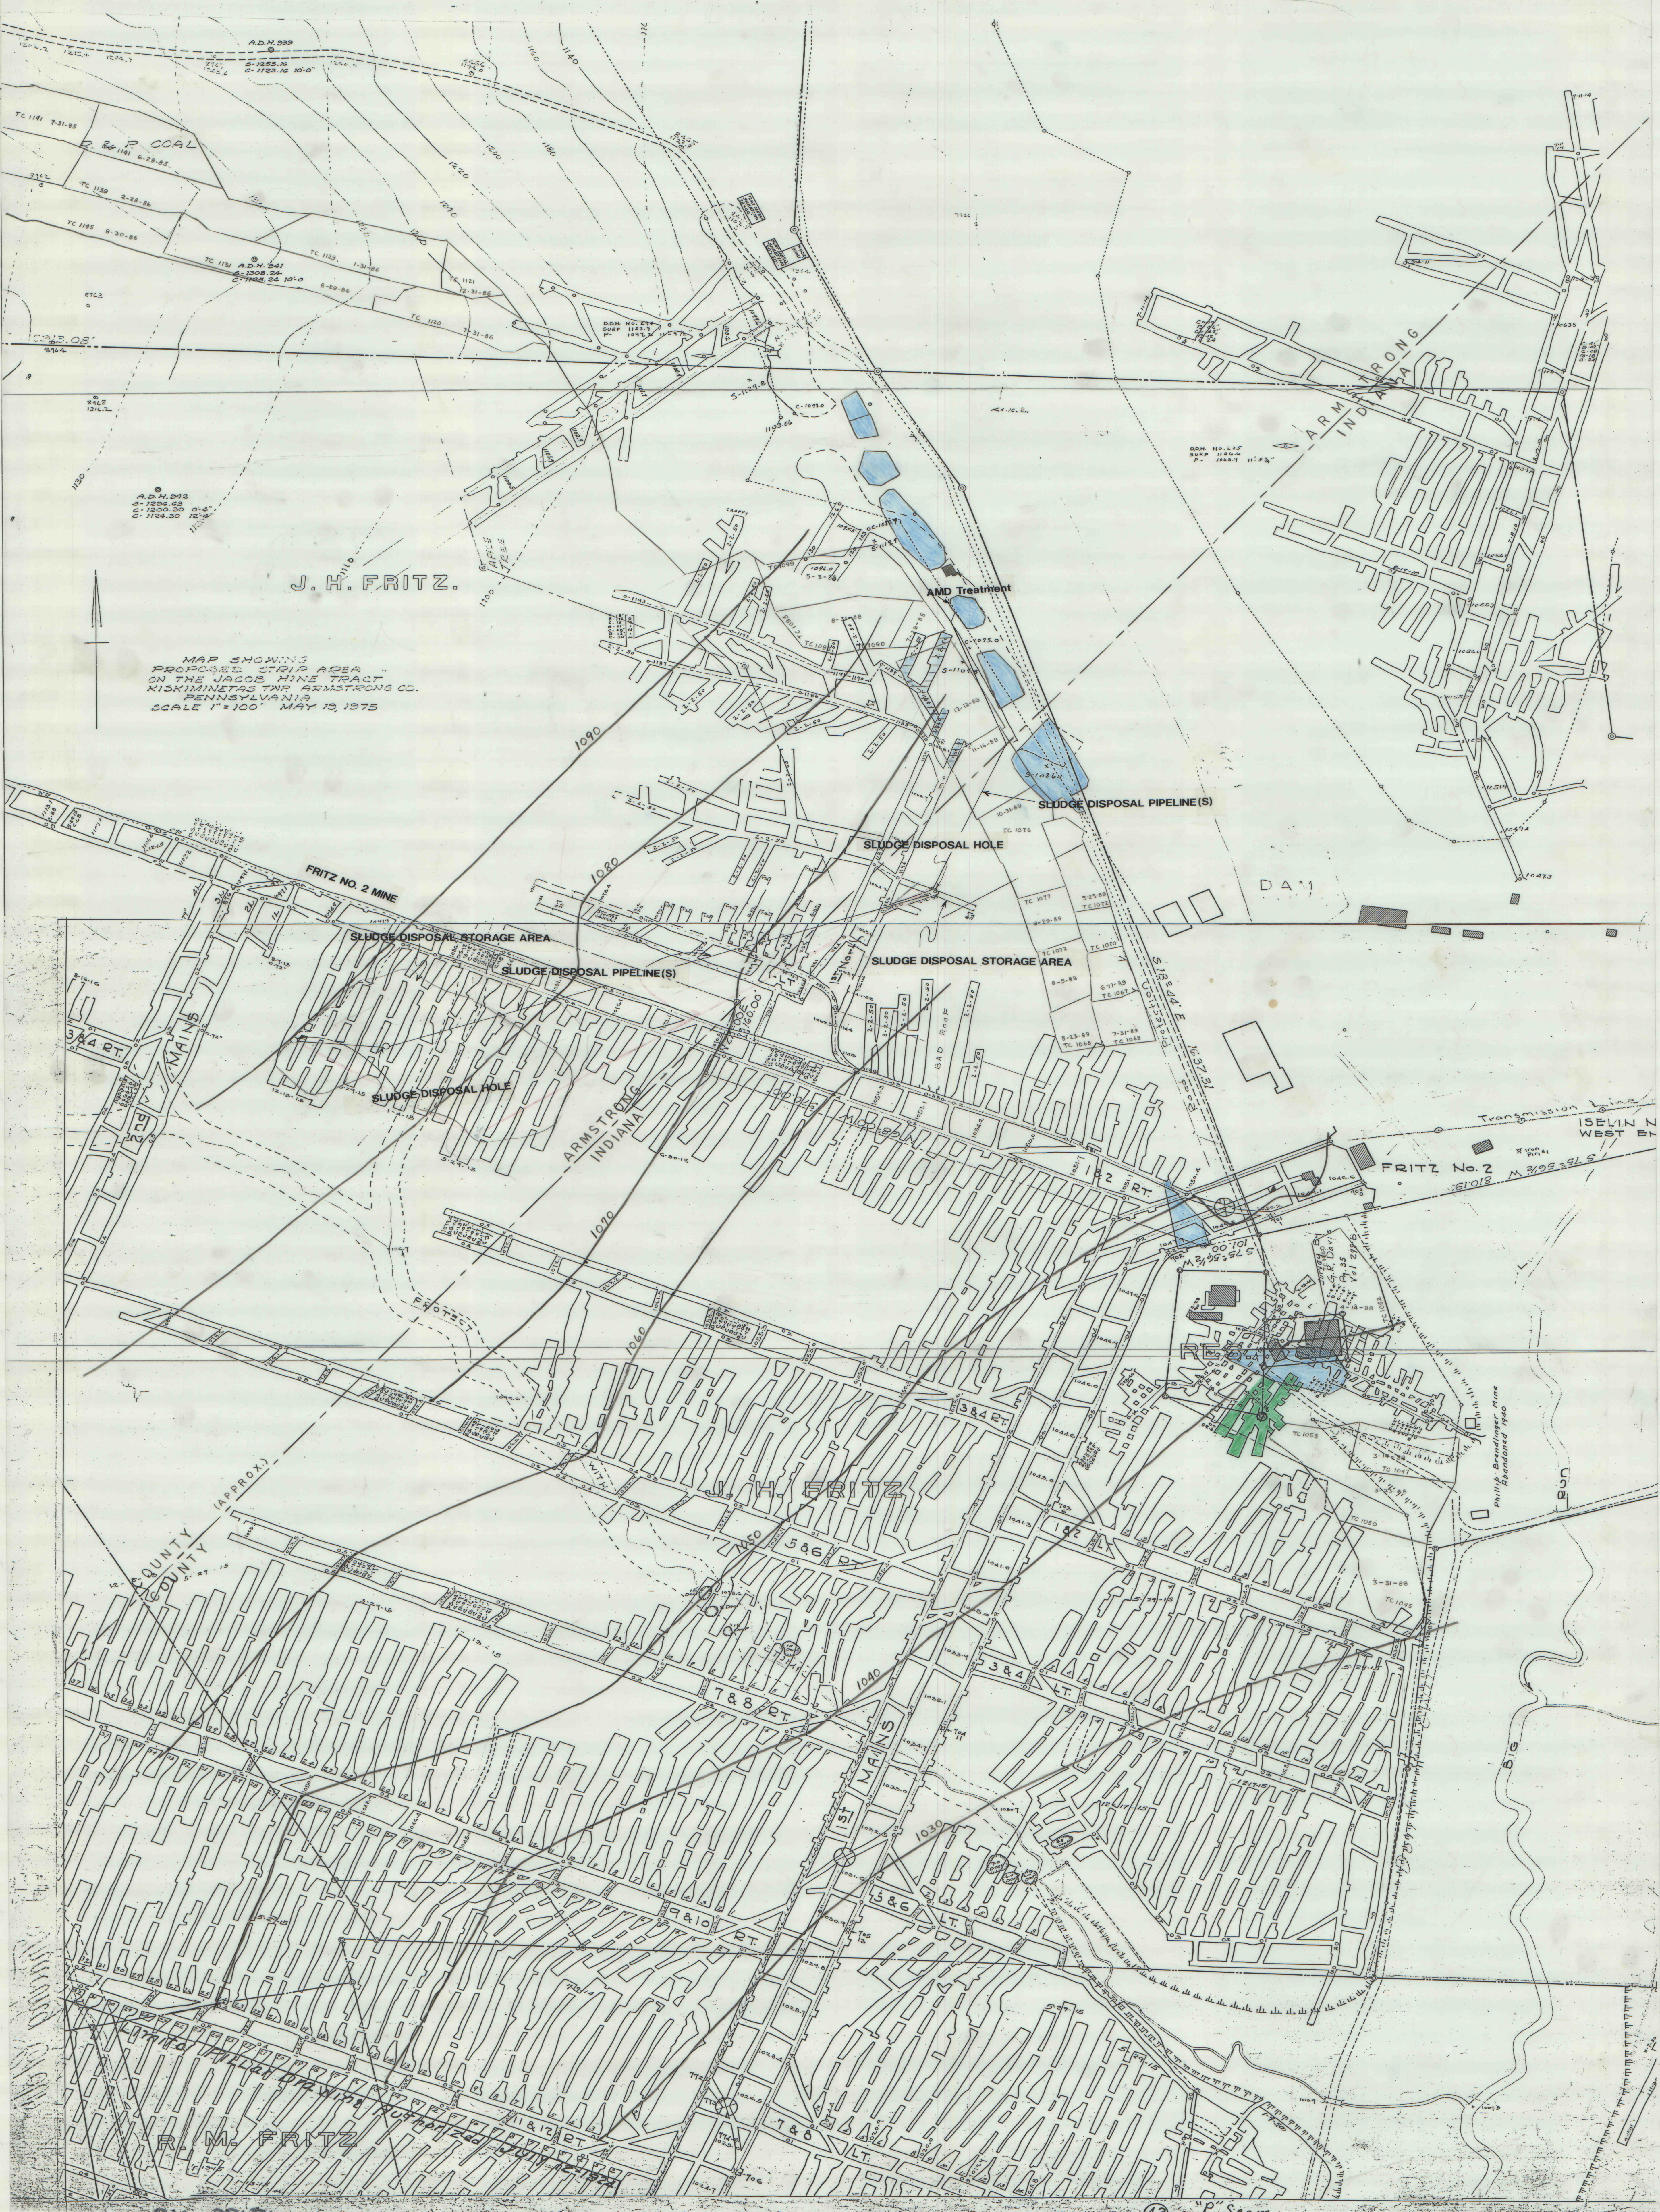

MAP SHOWING
PROPOSED STRIP AREA
ON THE JACOB MINE TRACT
PENNSYLVANIA
SCALE 1"=100' MAY 13, 1975

J. H. FRITZ.

FRITZ NO. 2 MINE

SLUDGE DISPOSAL STORAGE AREA

SLUDGE DISPOSAL PIPELINE(S)

SLUDGE DISPOSAL HOLE

ARMSTRONG INDIANA

SLUDGE DISPOSAL HOLE

SLUDGE DISPOSAL STORAGE AREA

J. H. FRITZ

FRITZ No. 2

ISLIN N WEST BR

Philip Brandinger Mine
Abandoned 1940

R. M. FRITZ

511-15121