


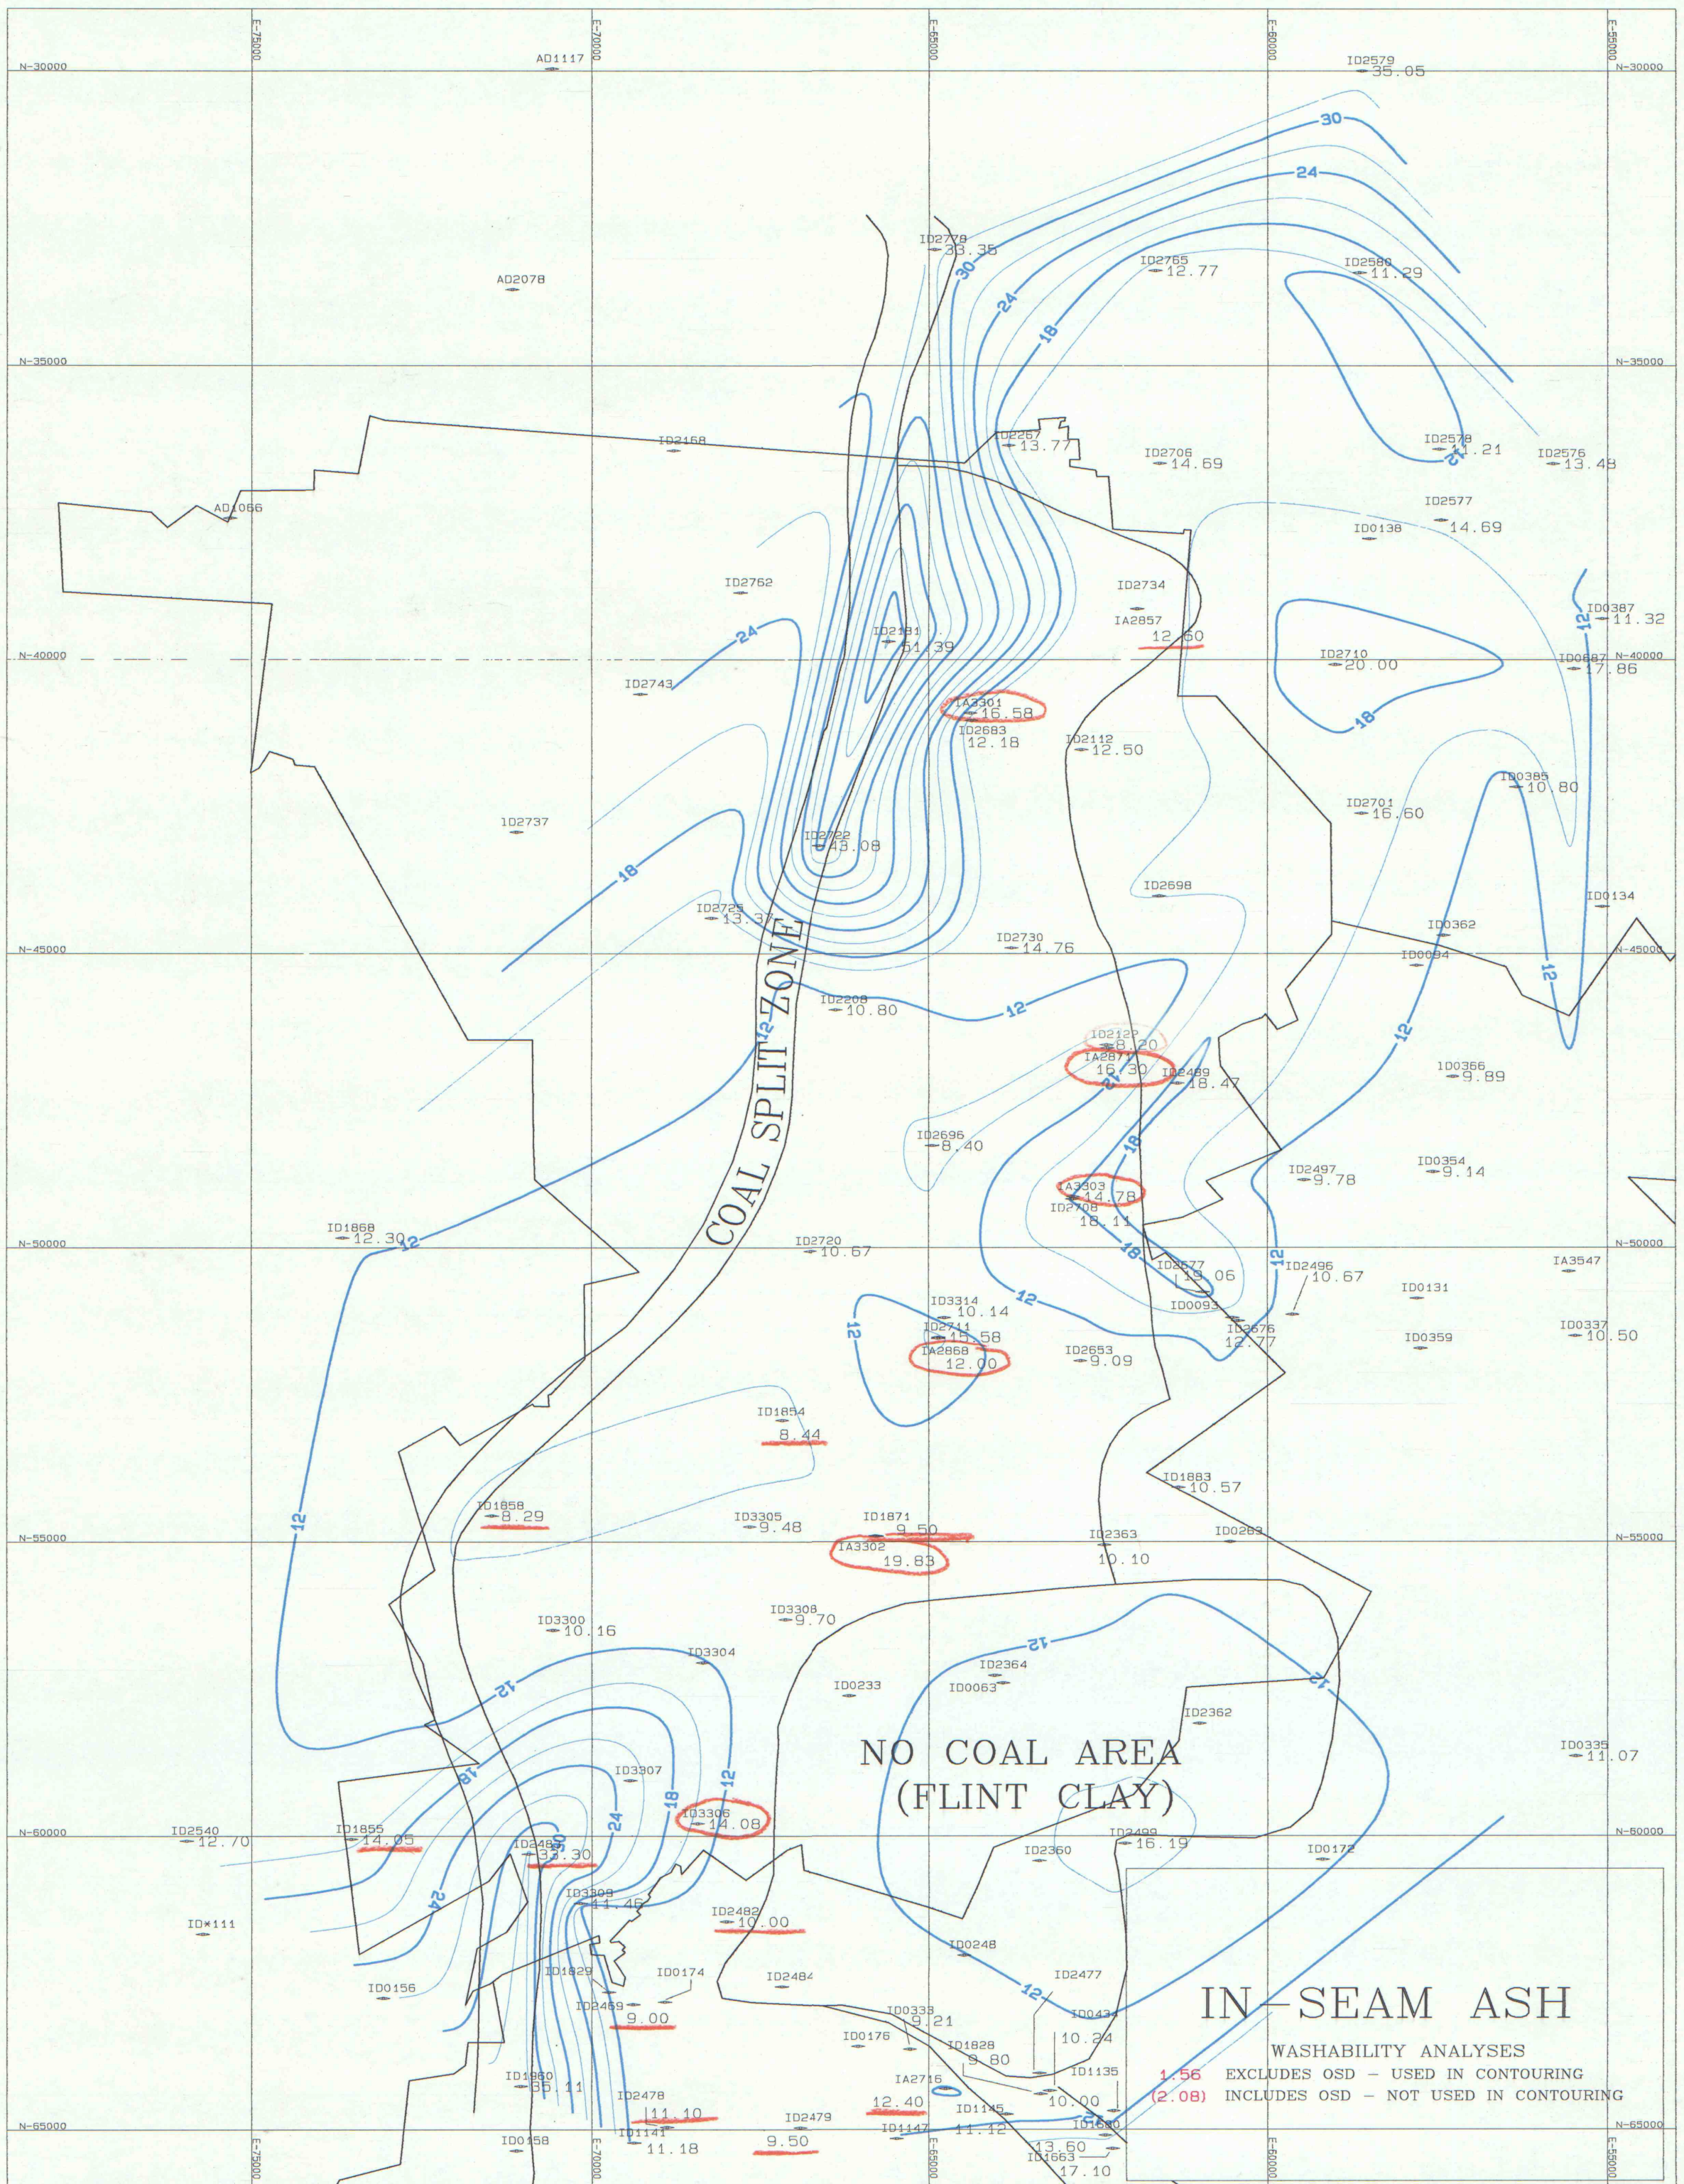

IMAPS # 09885