


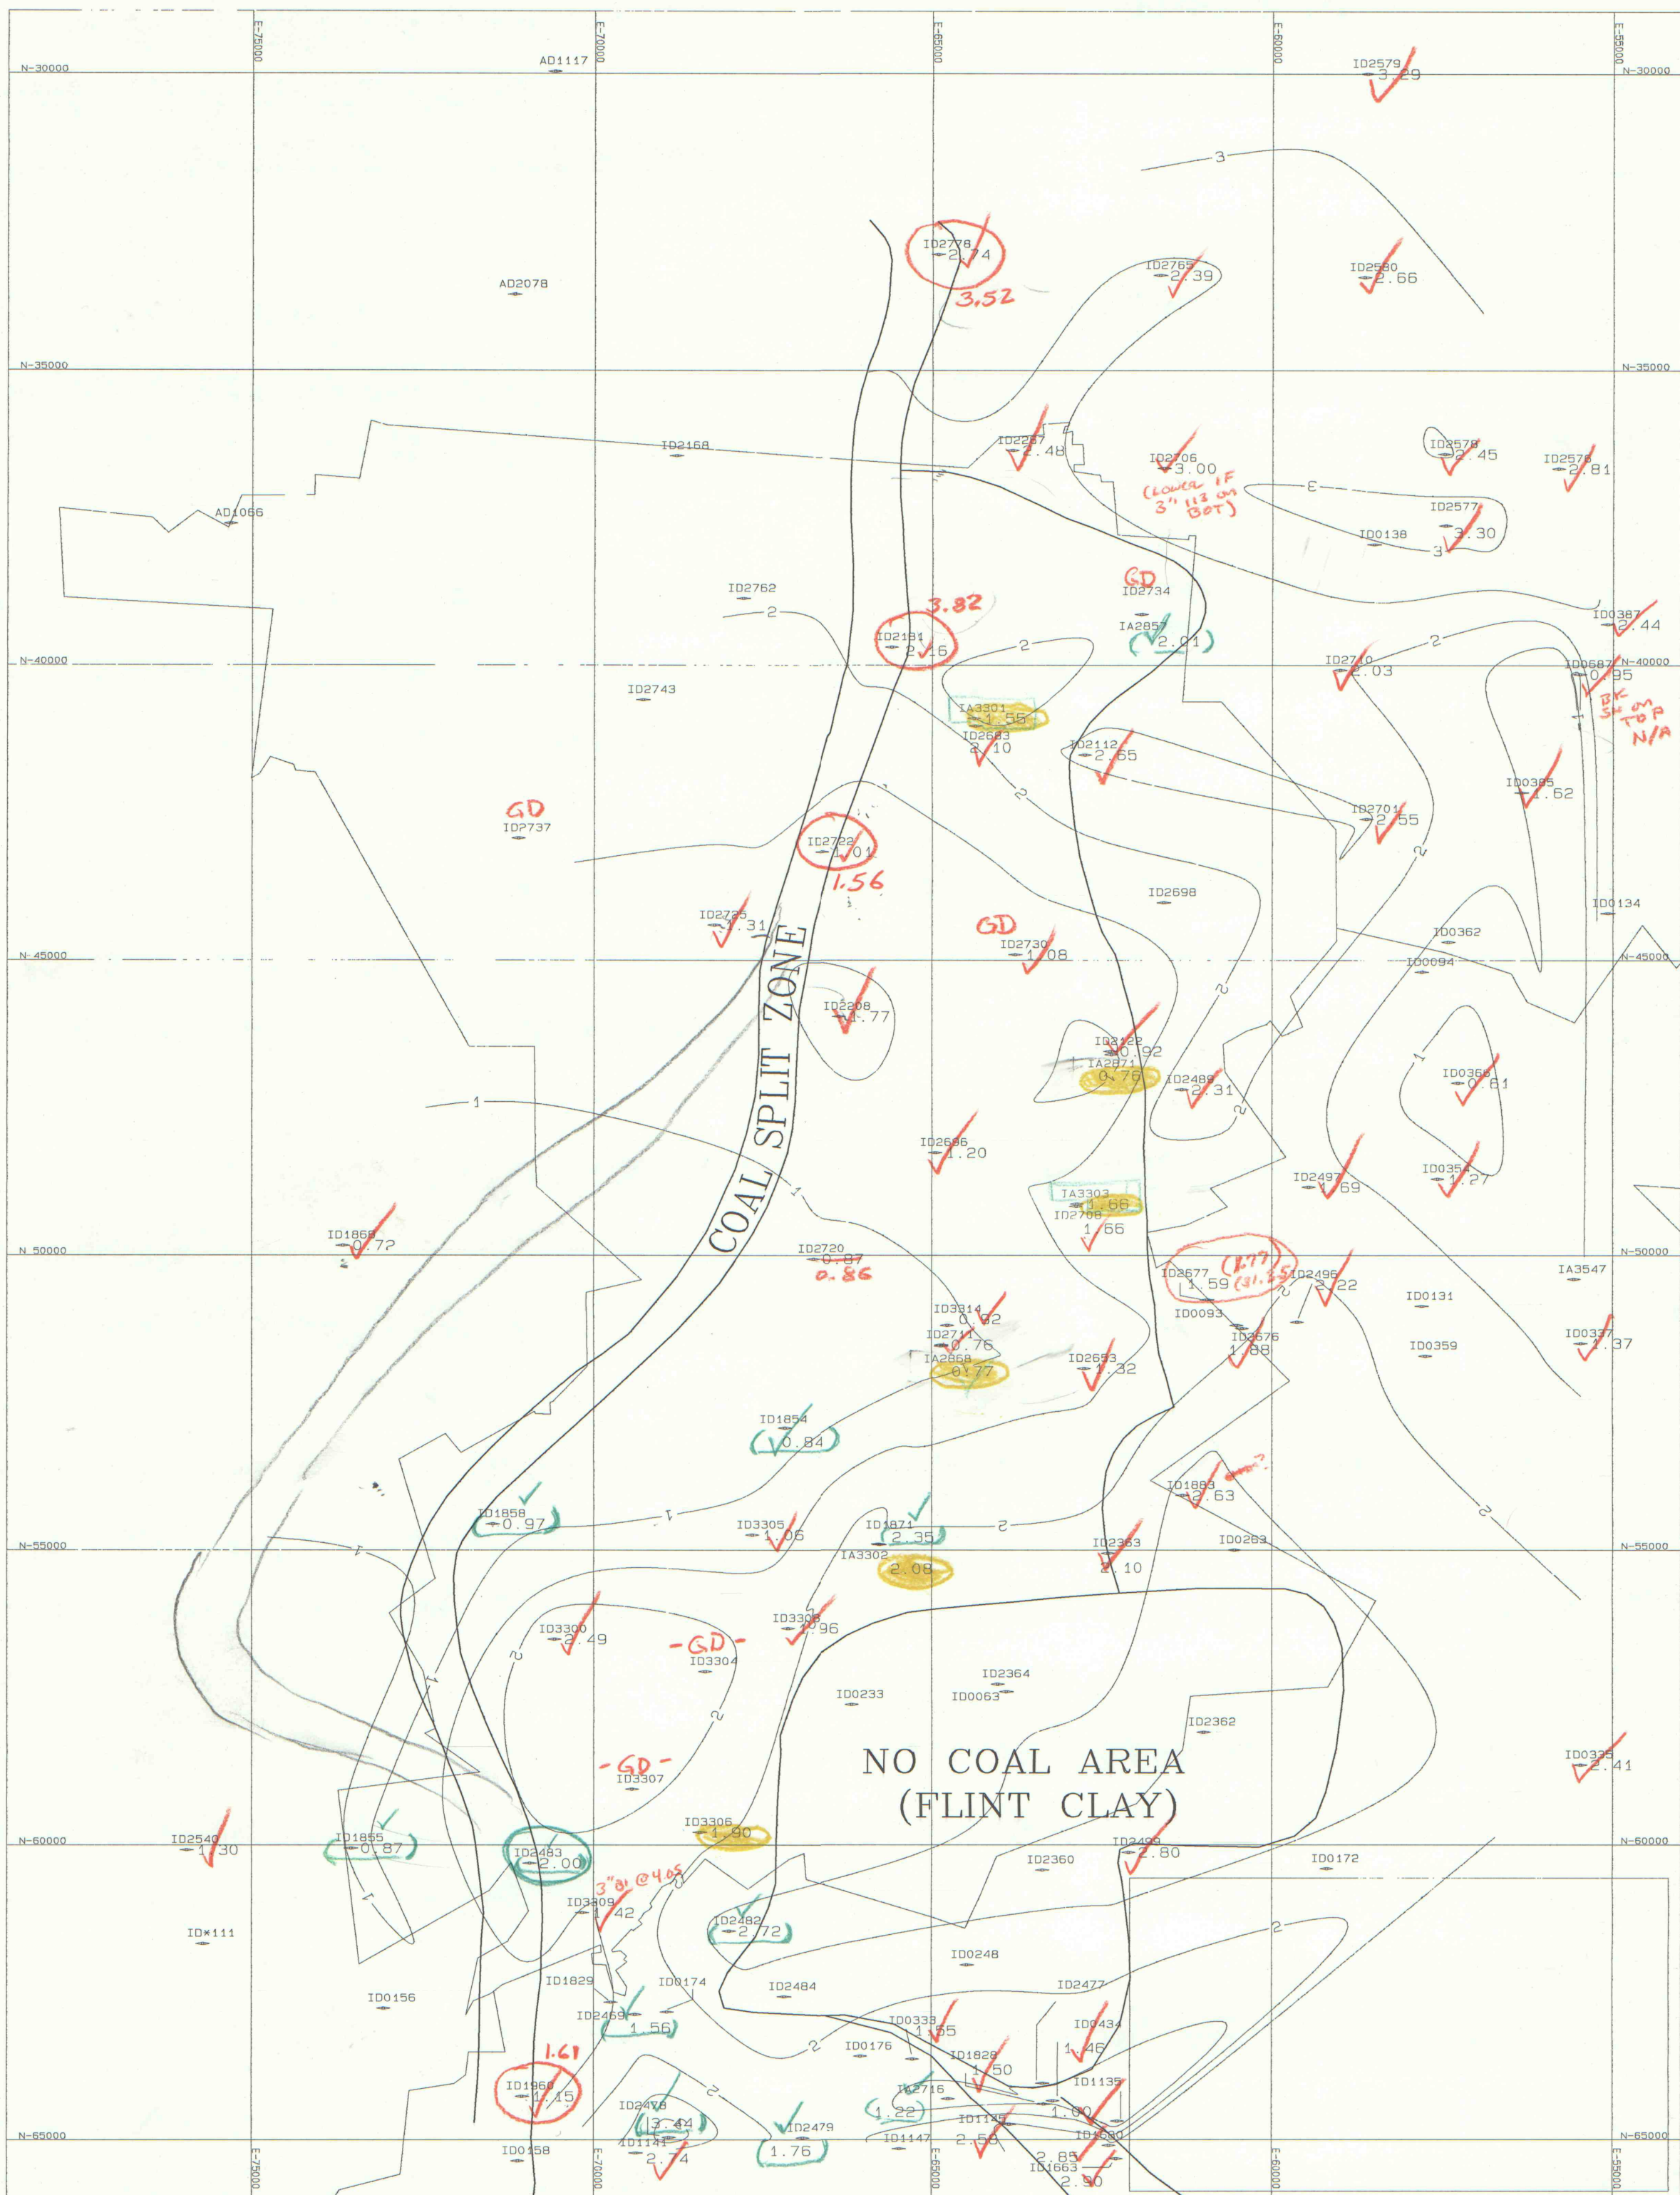

IMAPS # 09886