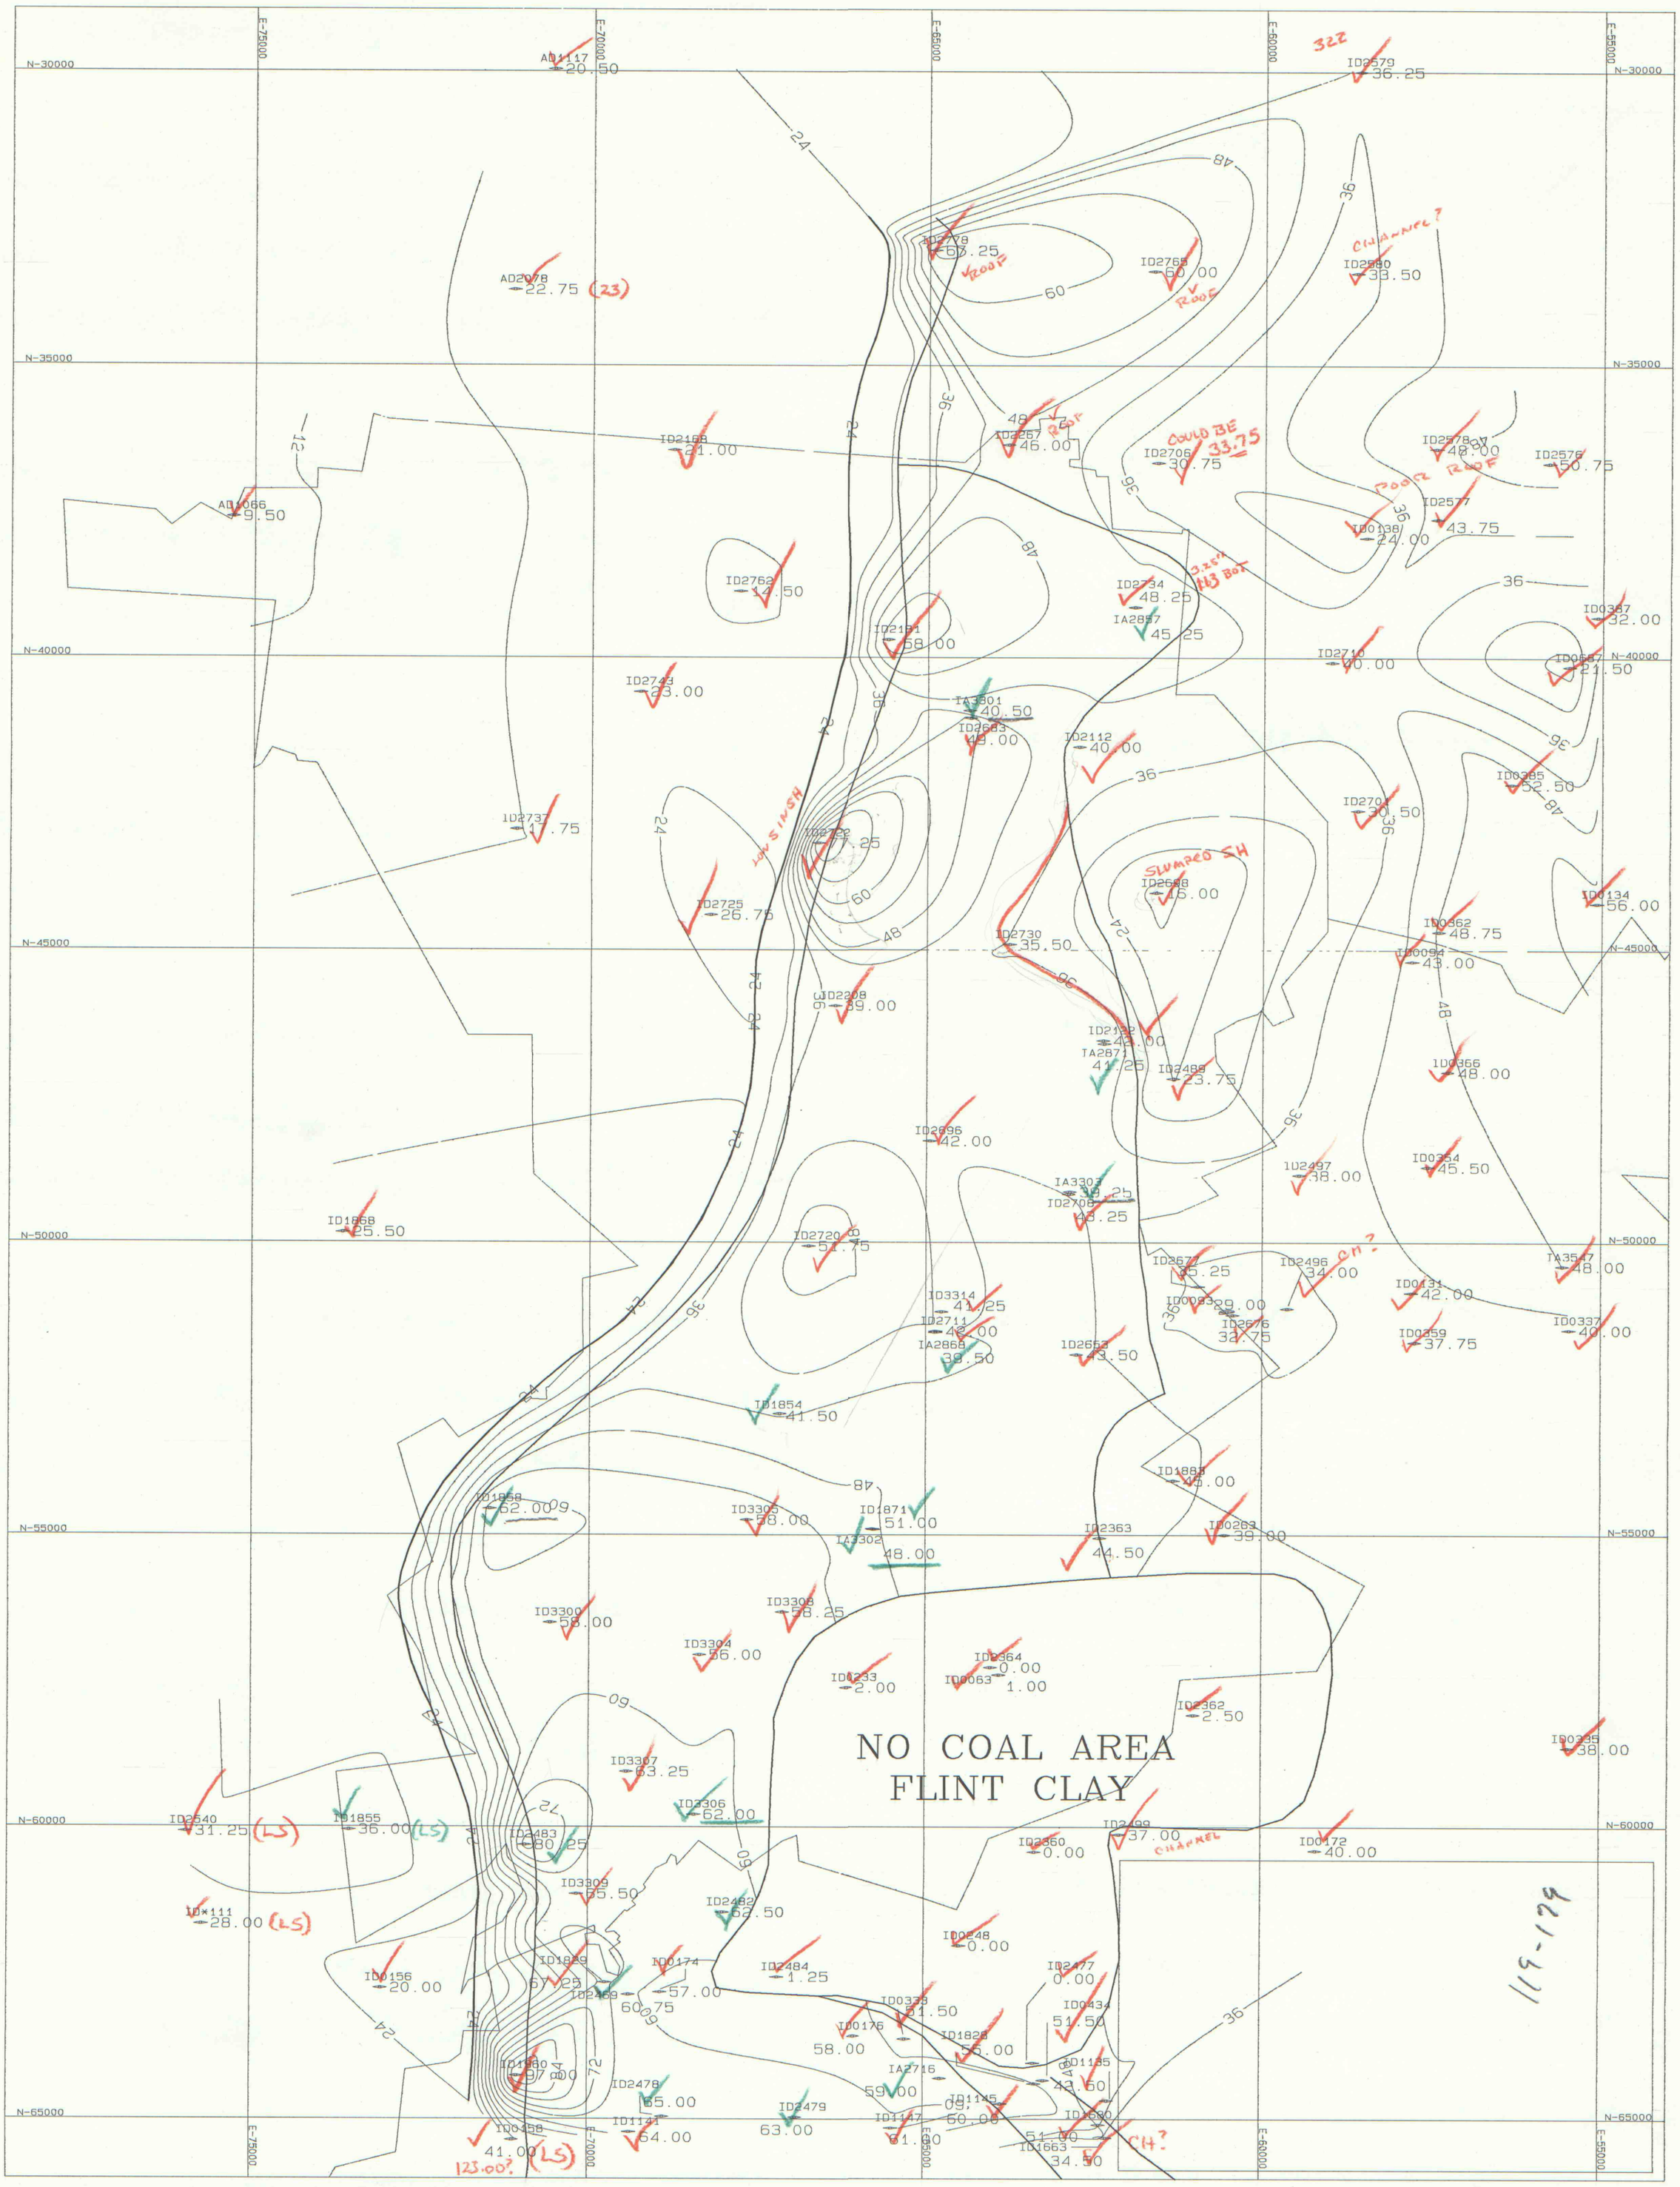
NO COAL AREA
FLINT CLAY
N-30000
N-35000
N-40000
N-45000
N-50000
N-55000
N-60000
N-65000
E-75000
E-70000
E-65000
E-60000
E-55000

IMAPS # 09887