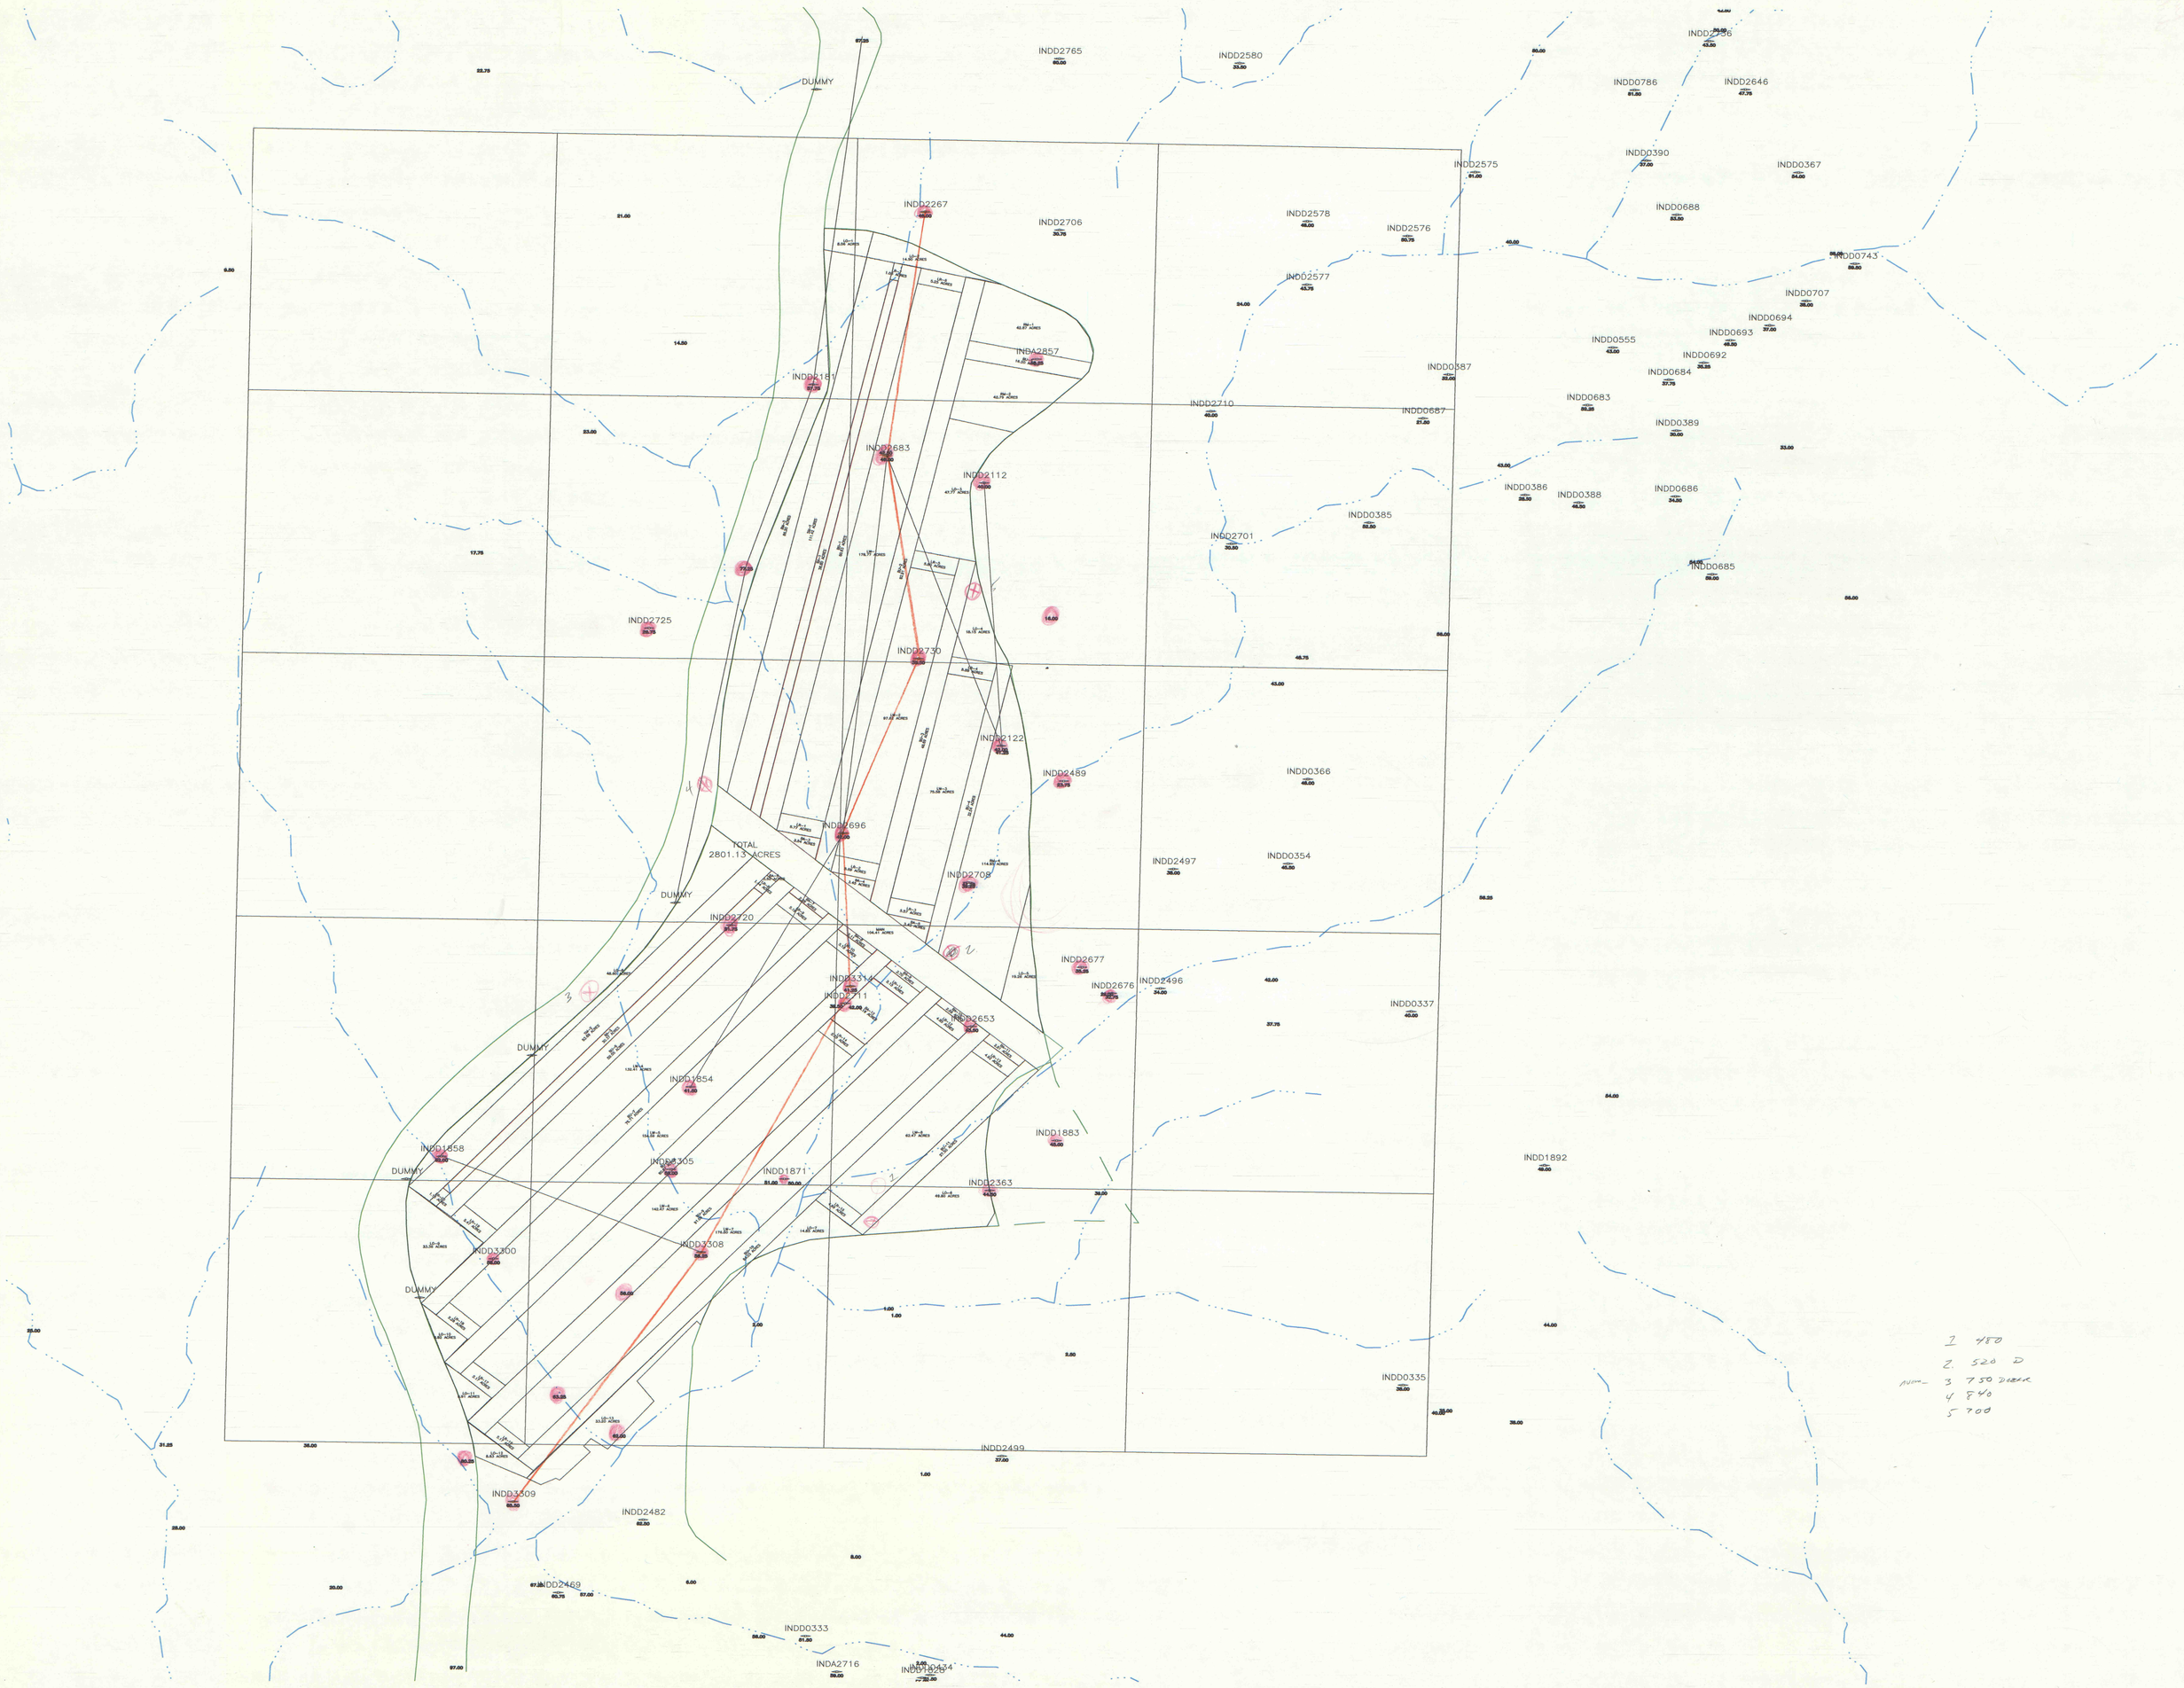

1 480
2. 520 D
AVGM— 3 750 DIRK
4 840
5 700

IMAPS# 09888