


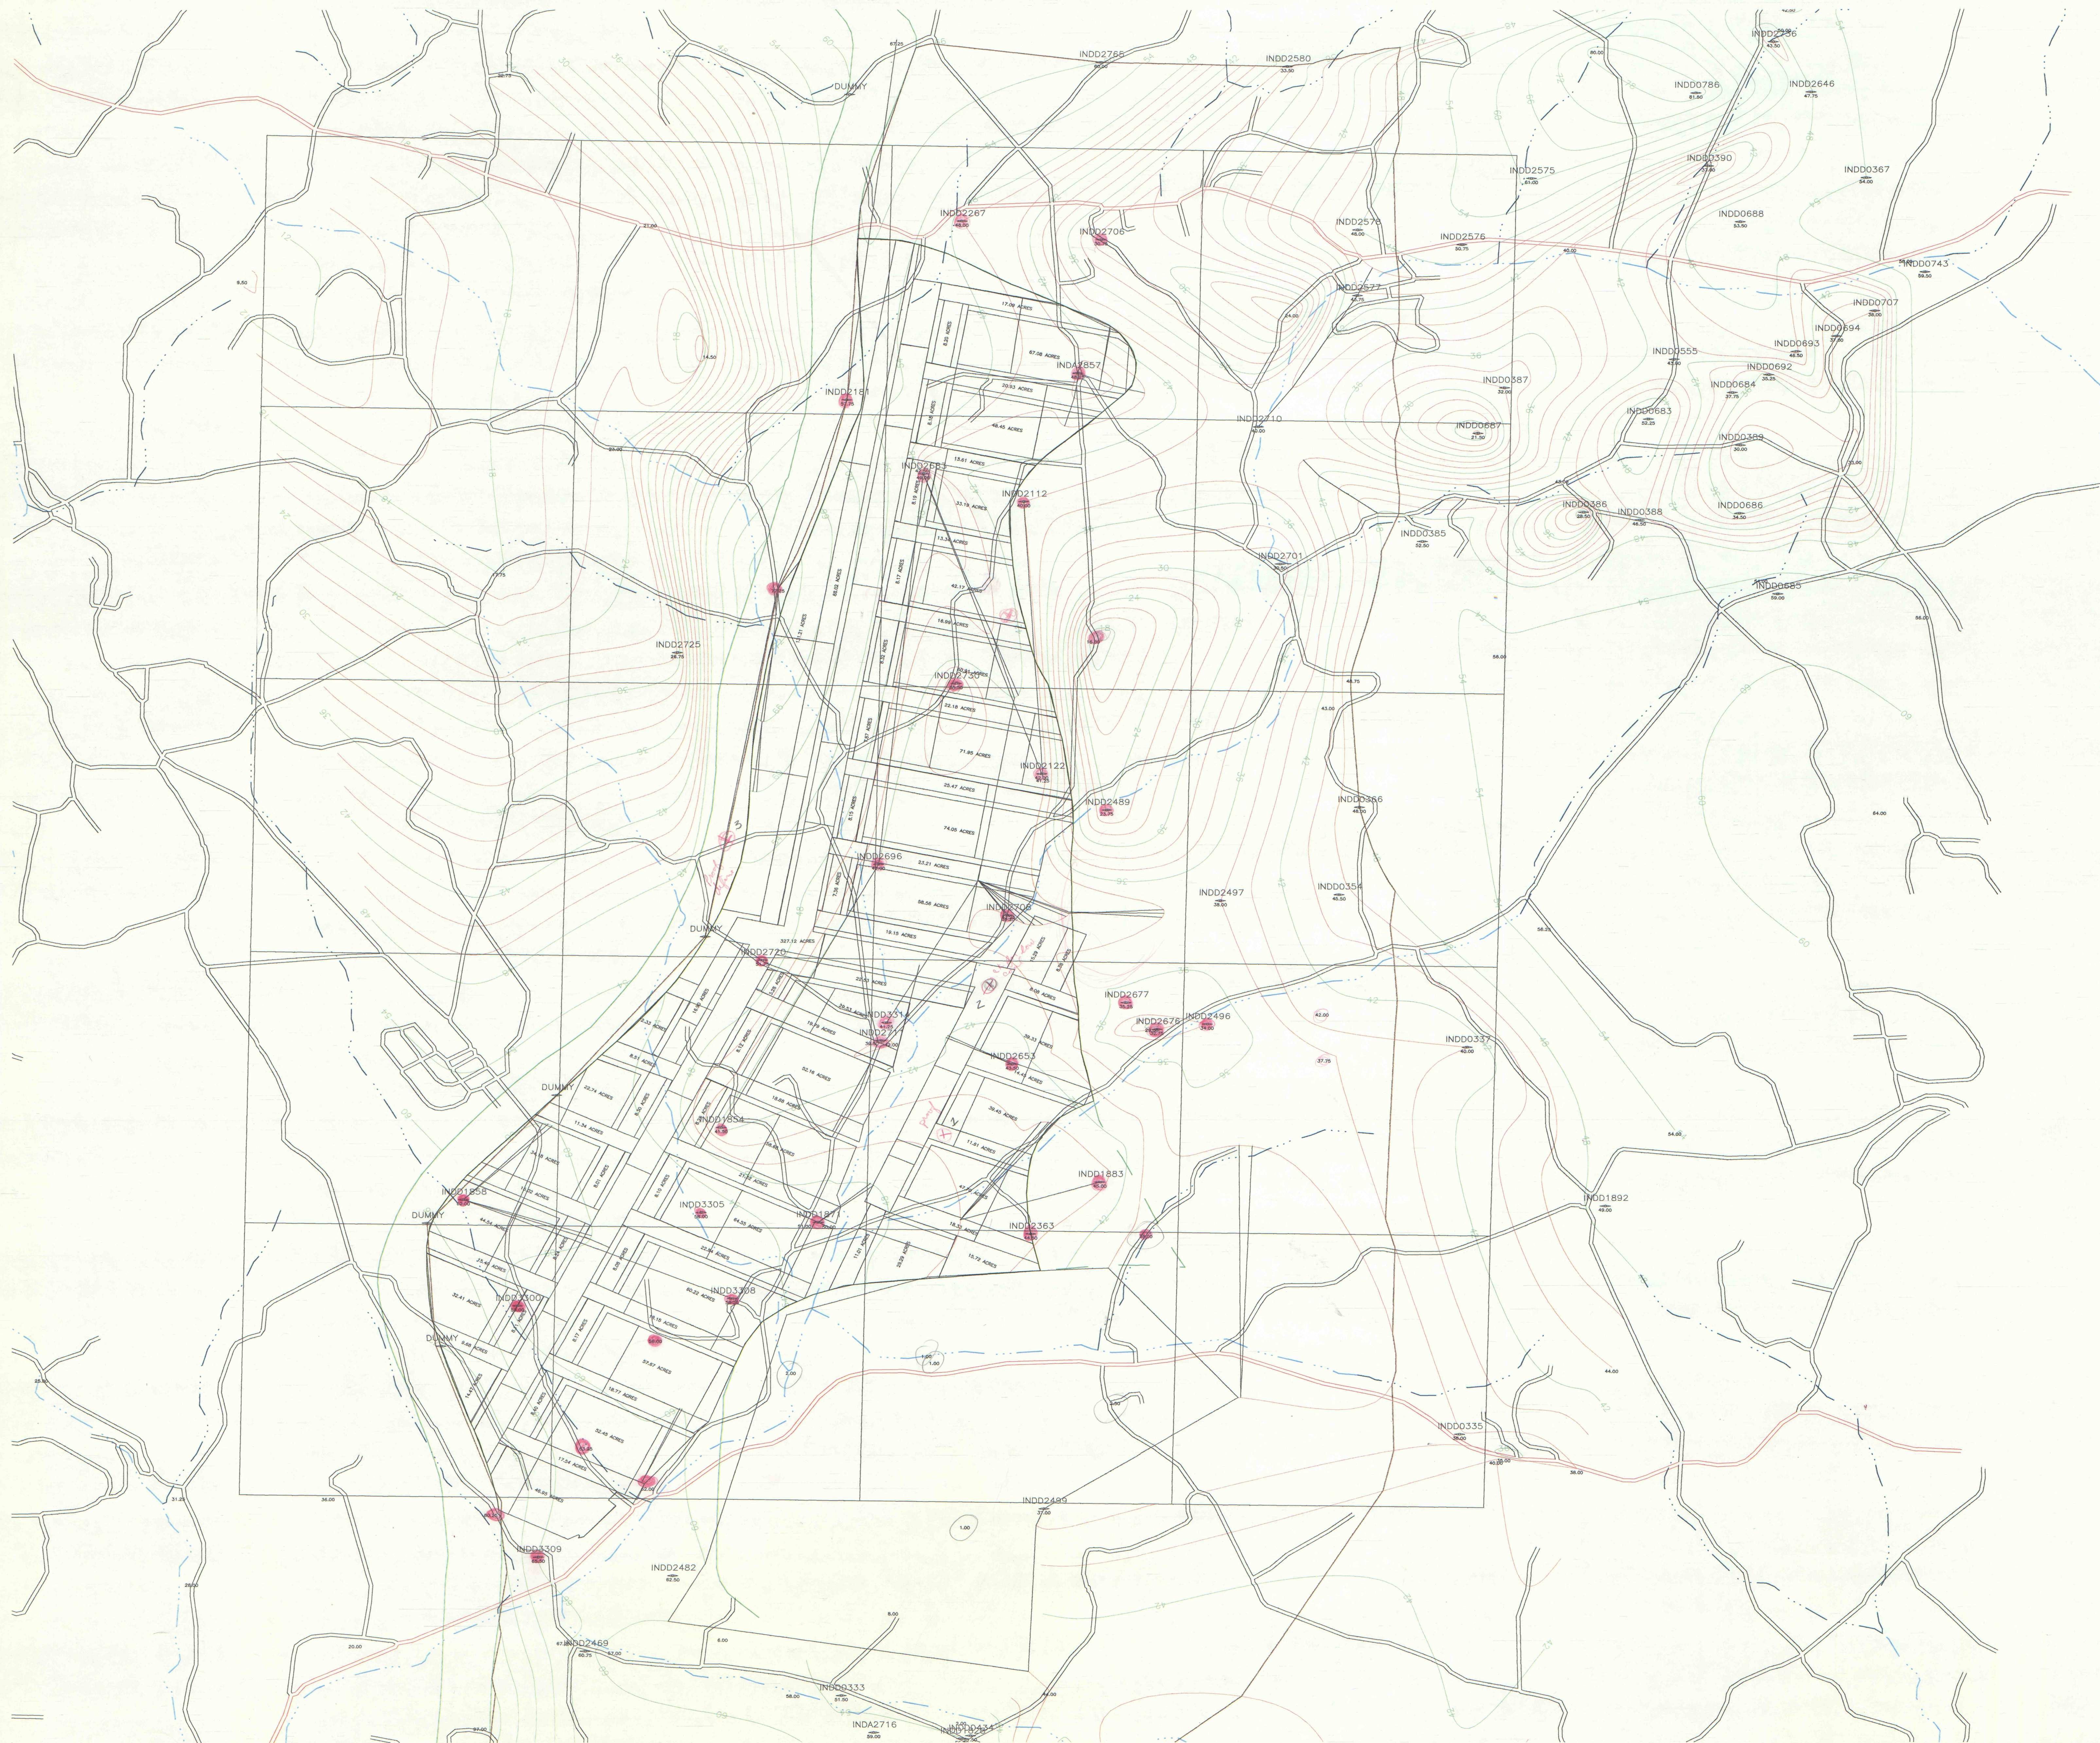

1 700' - down
2 500' - down
3 700' - down
4 750' - down