
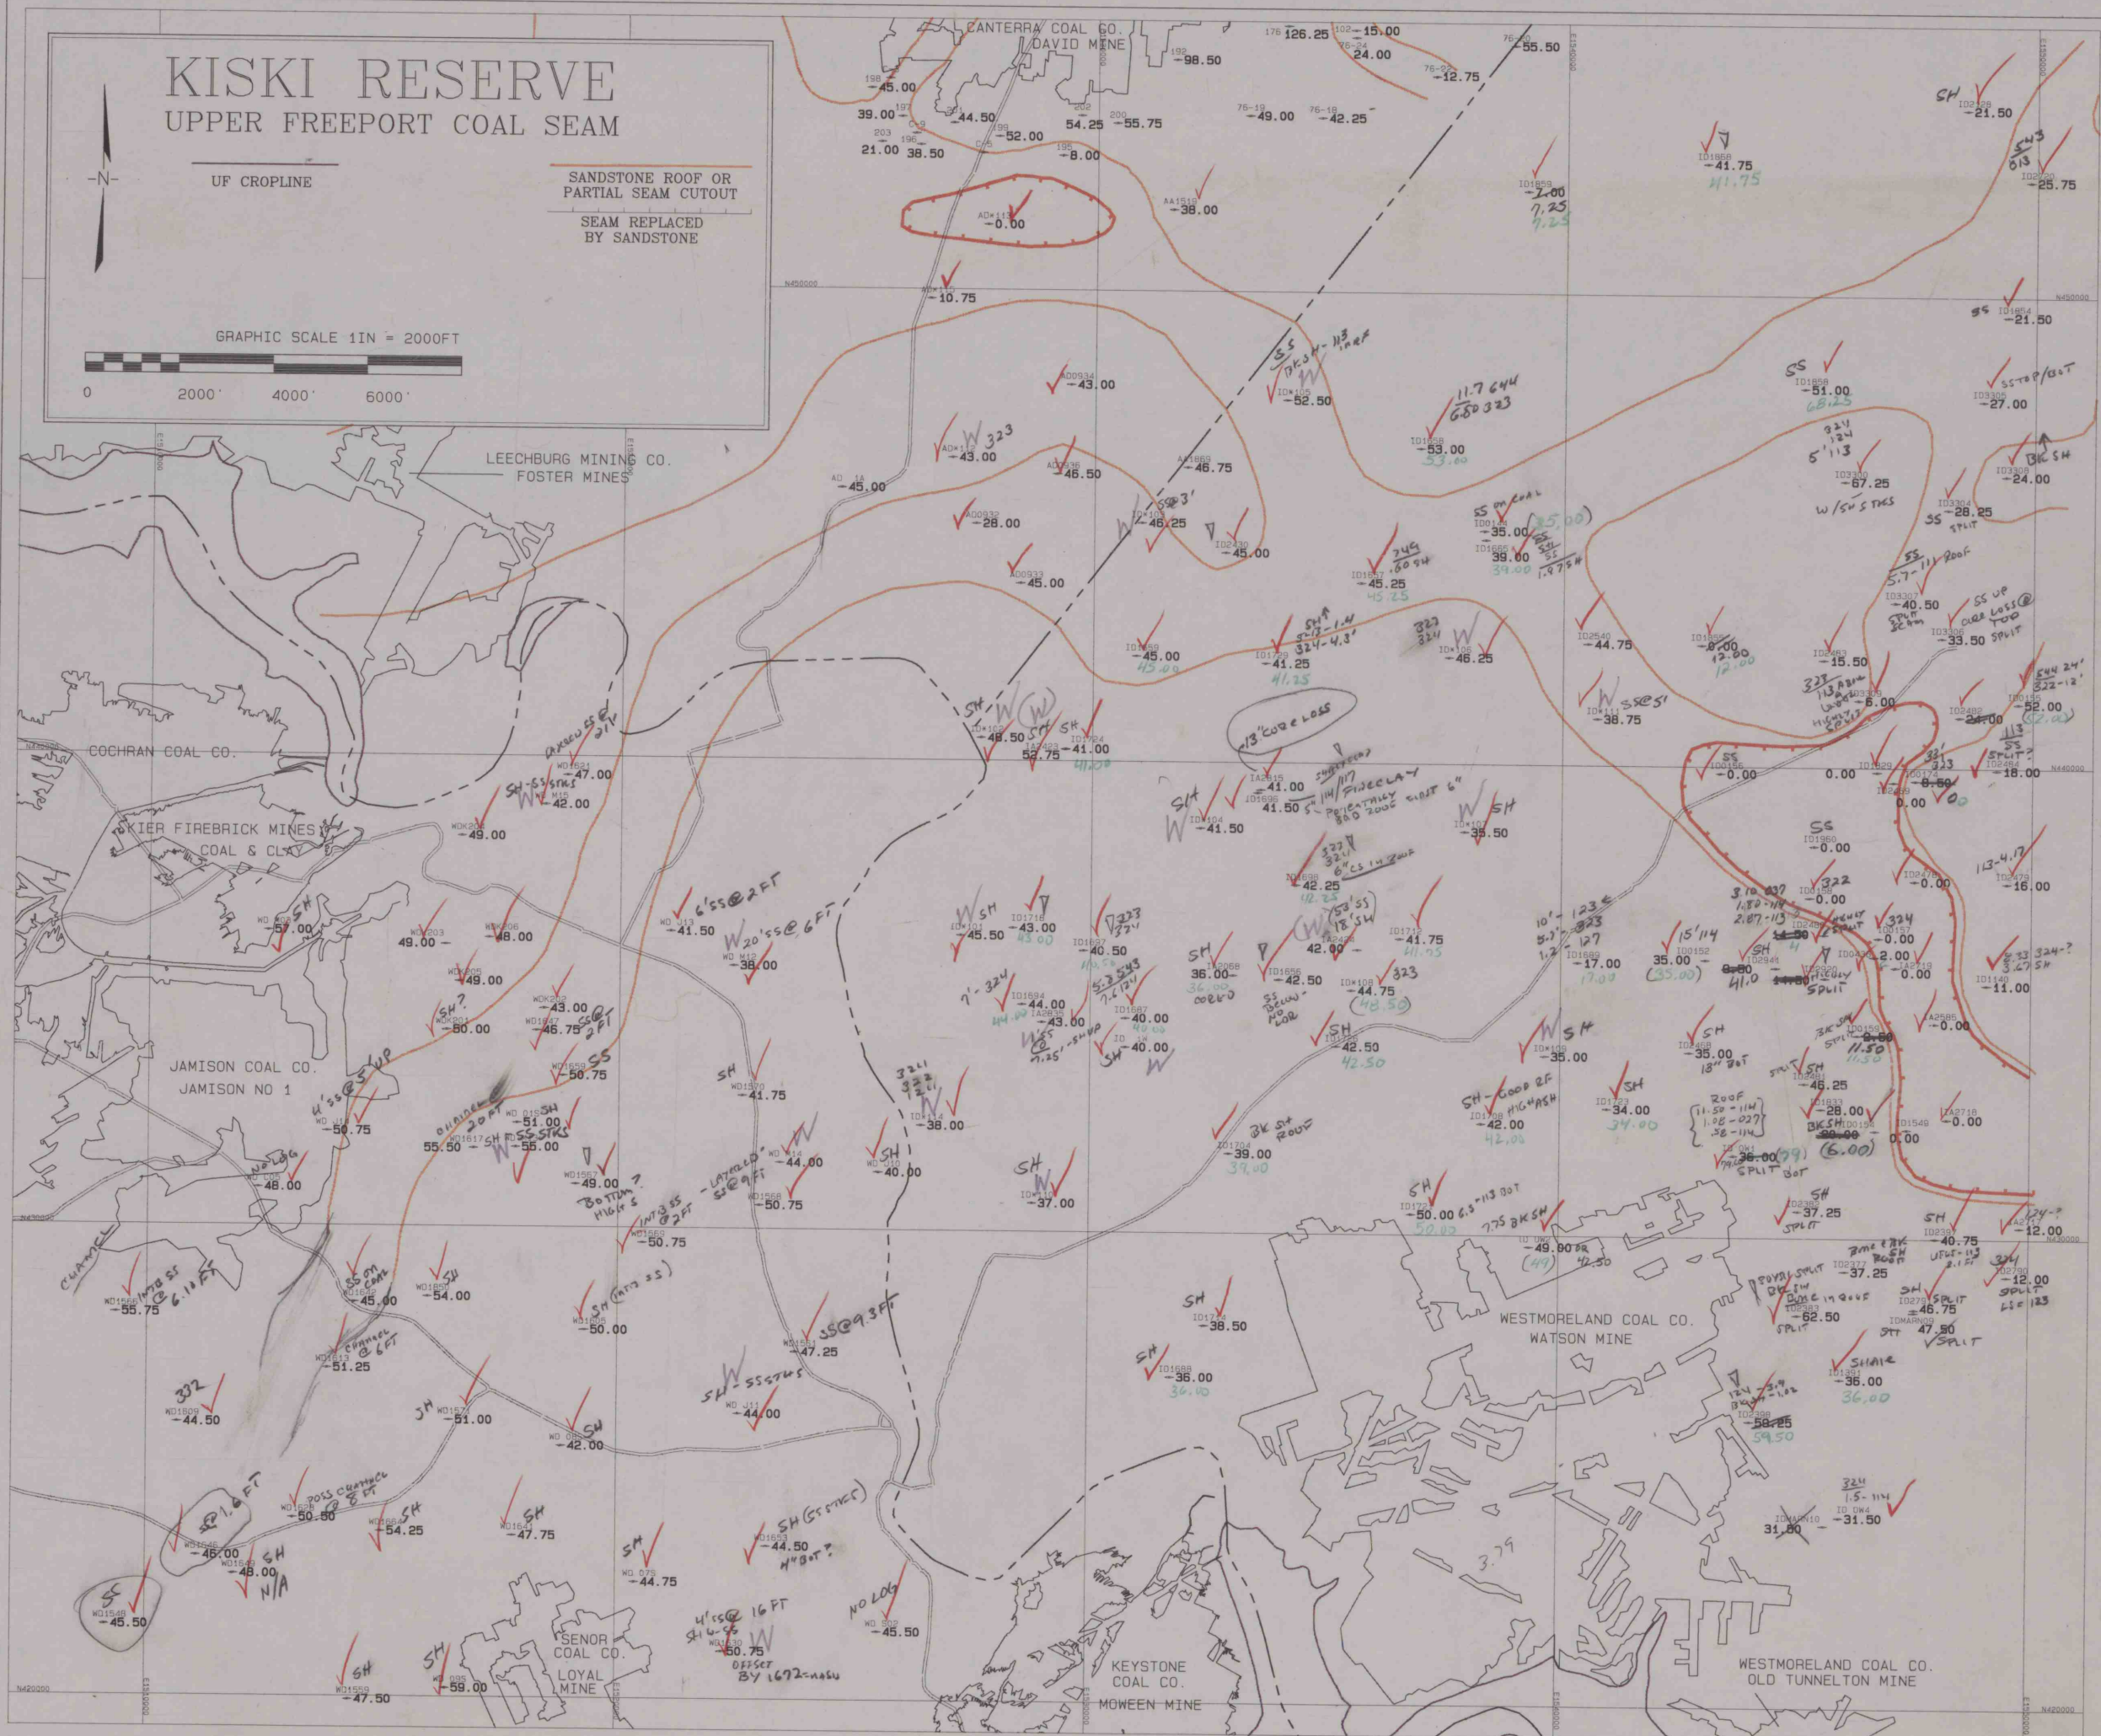


SANDSTONE ROOF OR
PARTIAL SEAM CUTOUT

SEAM REPLACED
BY SANDSTONE

GRAPHIC SCALE 1IN = 2000FT

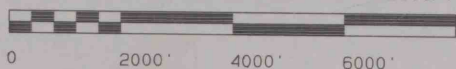

MINEABLE THICKNESS

IMAPS# 09918