


UPPER FREEPORT COAL SEAM

STRUCTURE

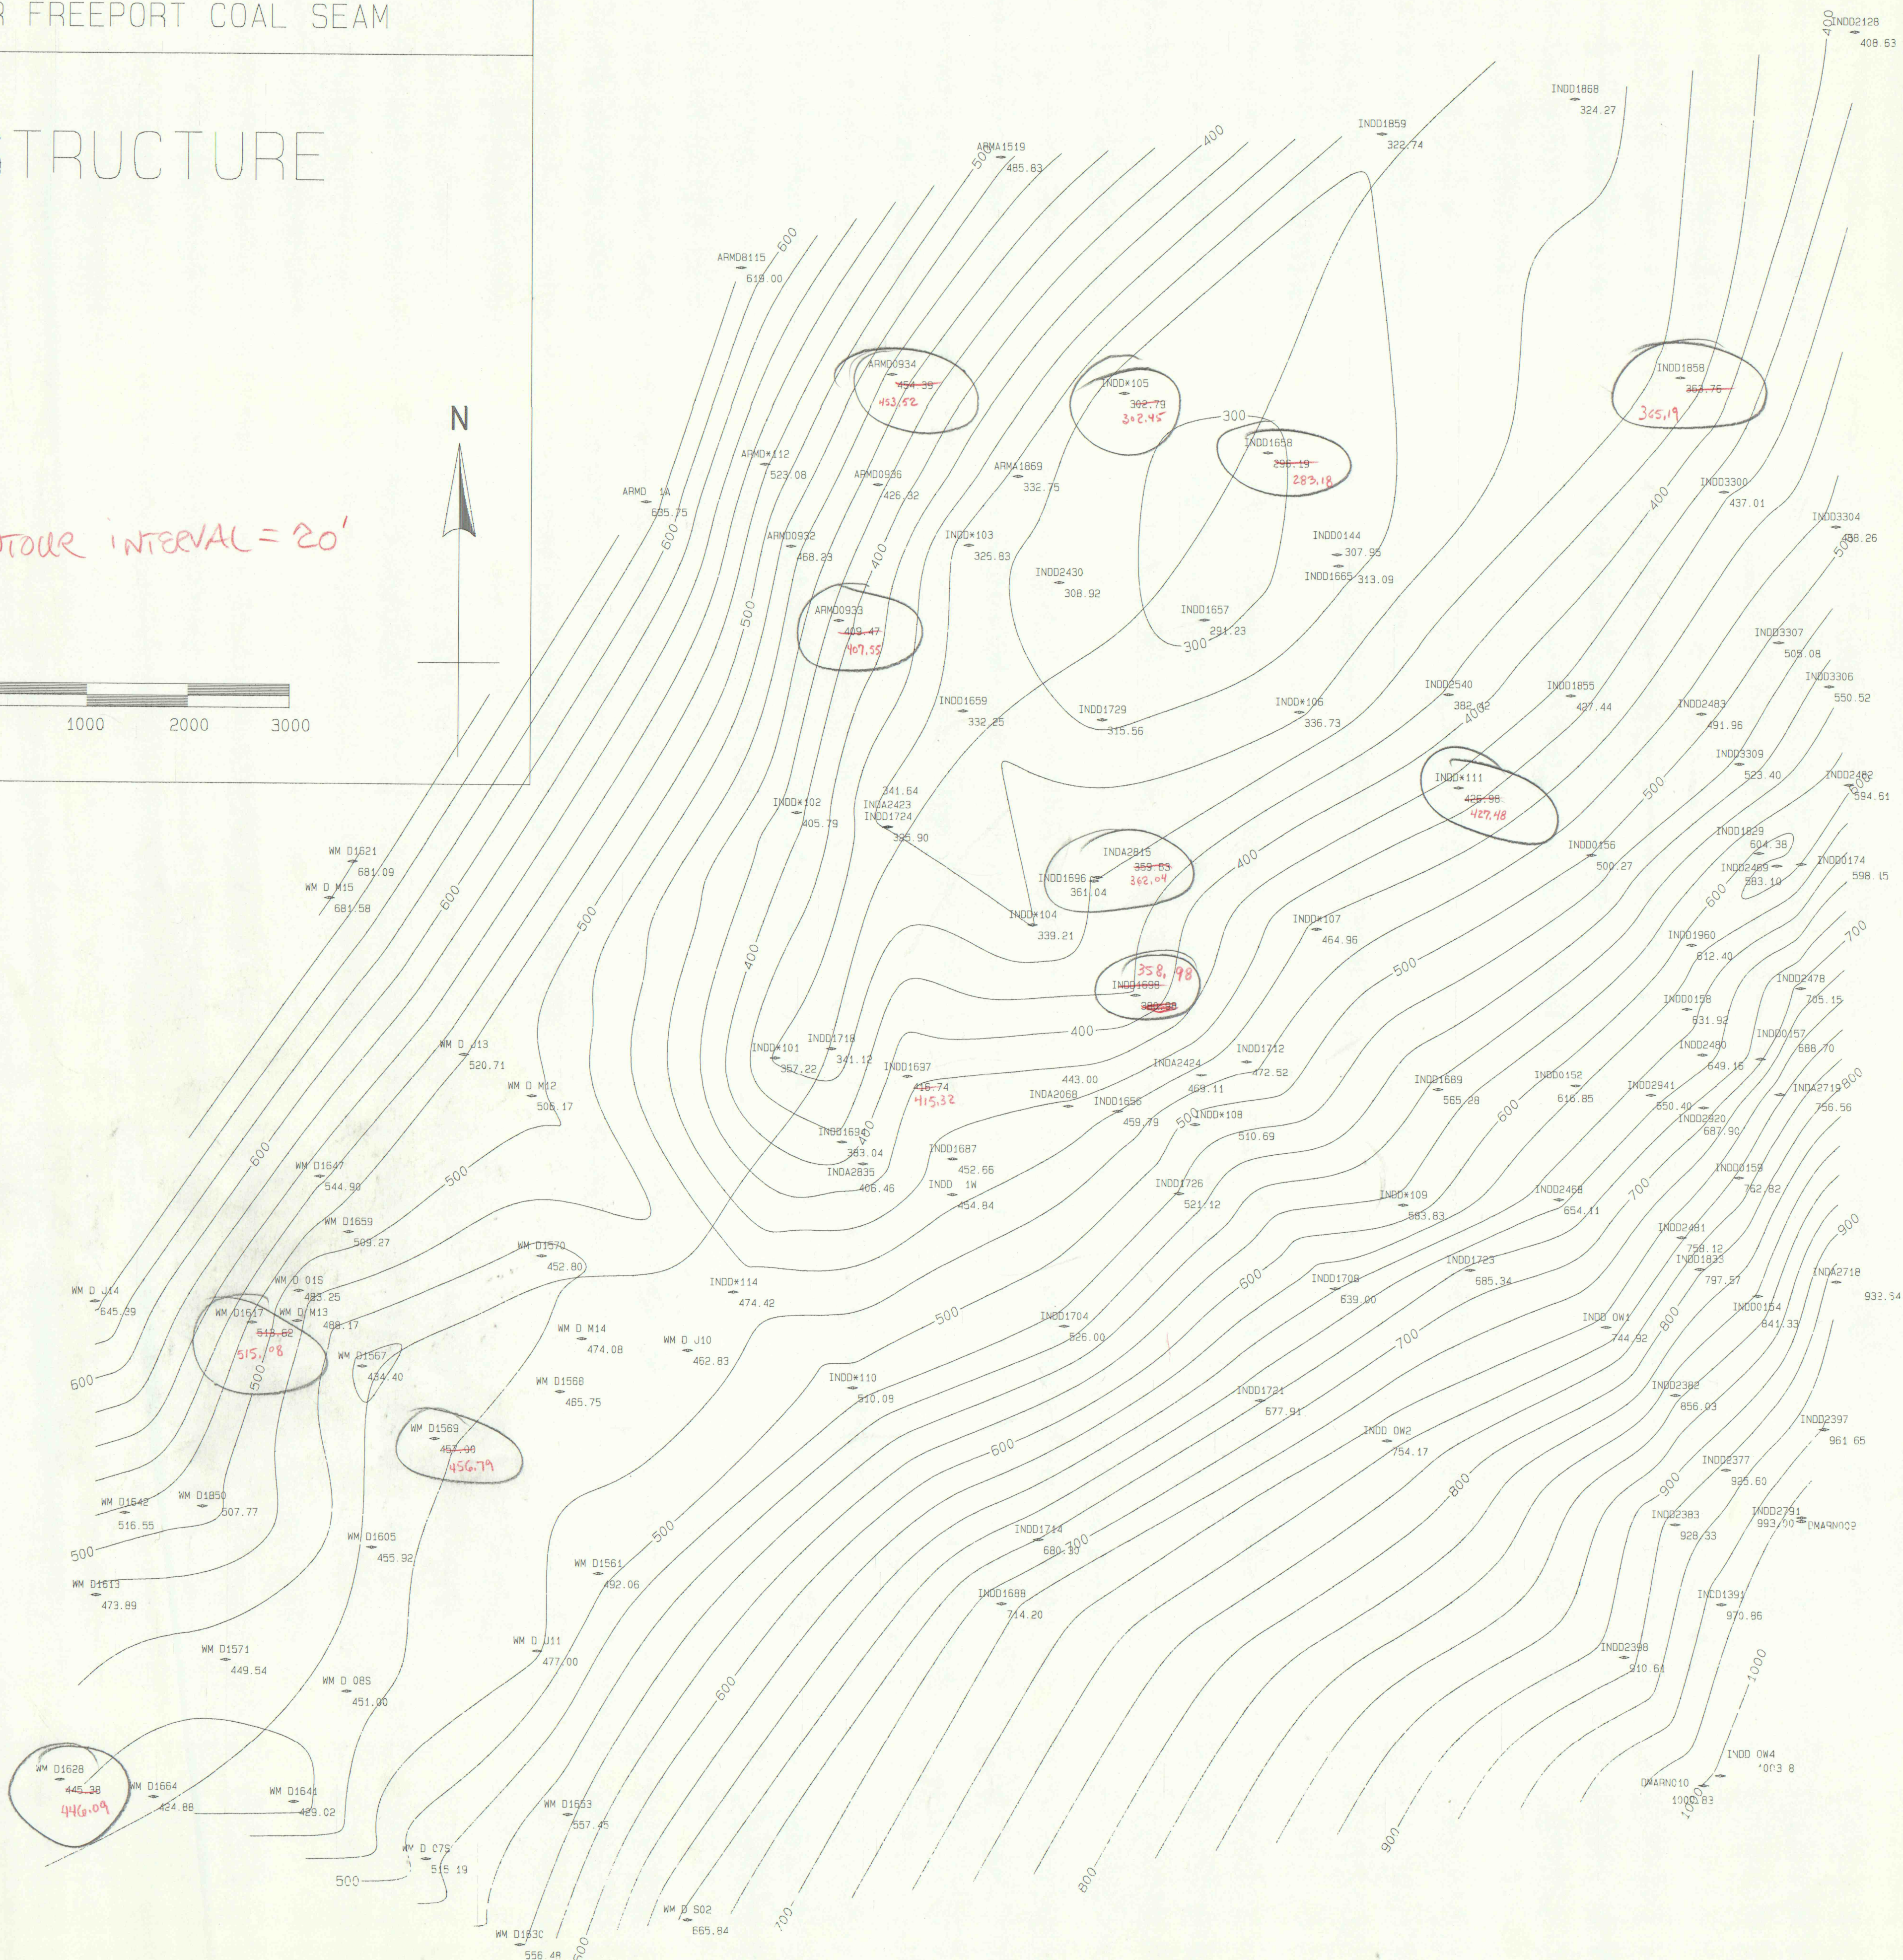

ics
com Triple "A"

IMAPS# 09951