


KISKI RESERVE


UPPER FREEPORT COAL SEAM

STRUCTURAL CONTOUR MAP


CONTOUR INTERVAL = 20'

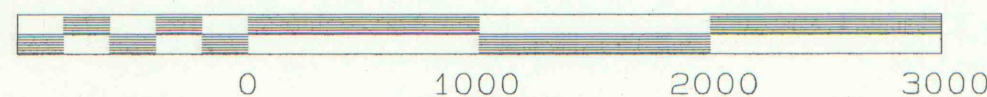

N

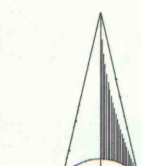

DATE : WED MAY 5 11:55:23 1993
PROJECT : F: KISKI
TITLE : DJS

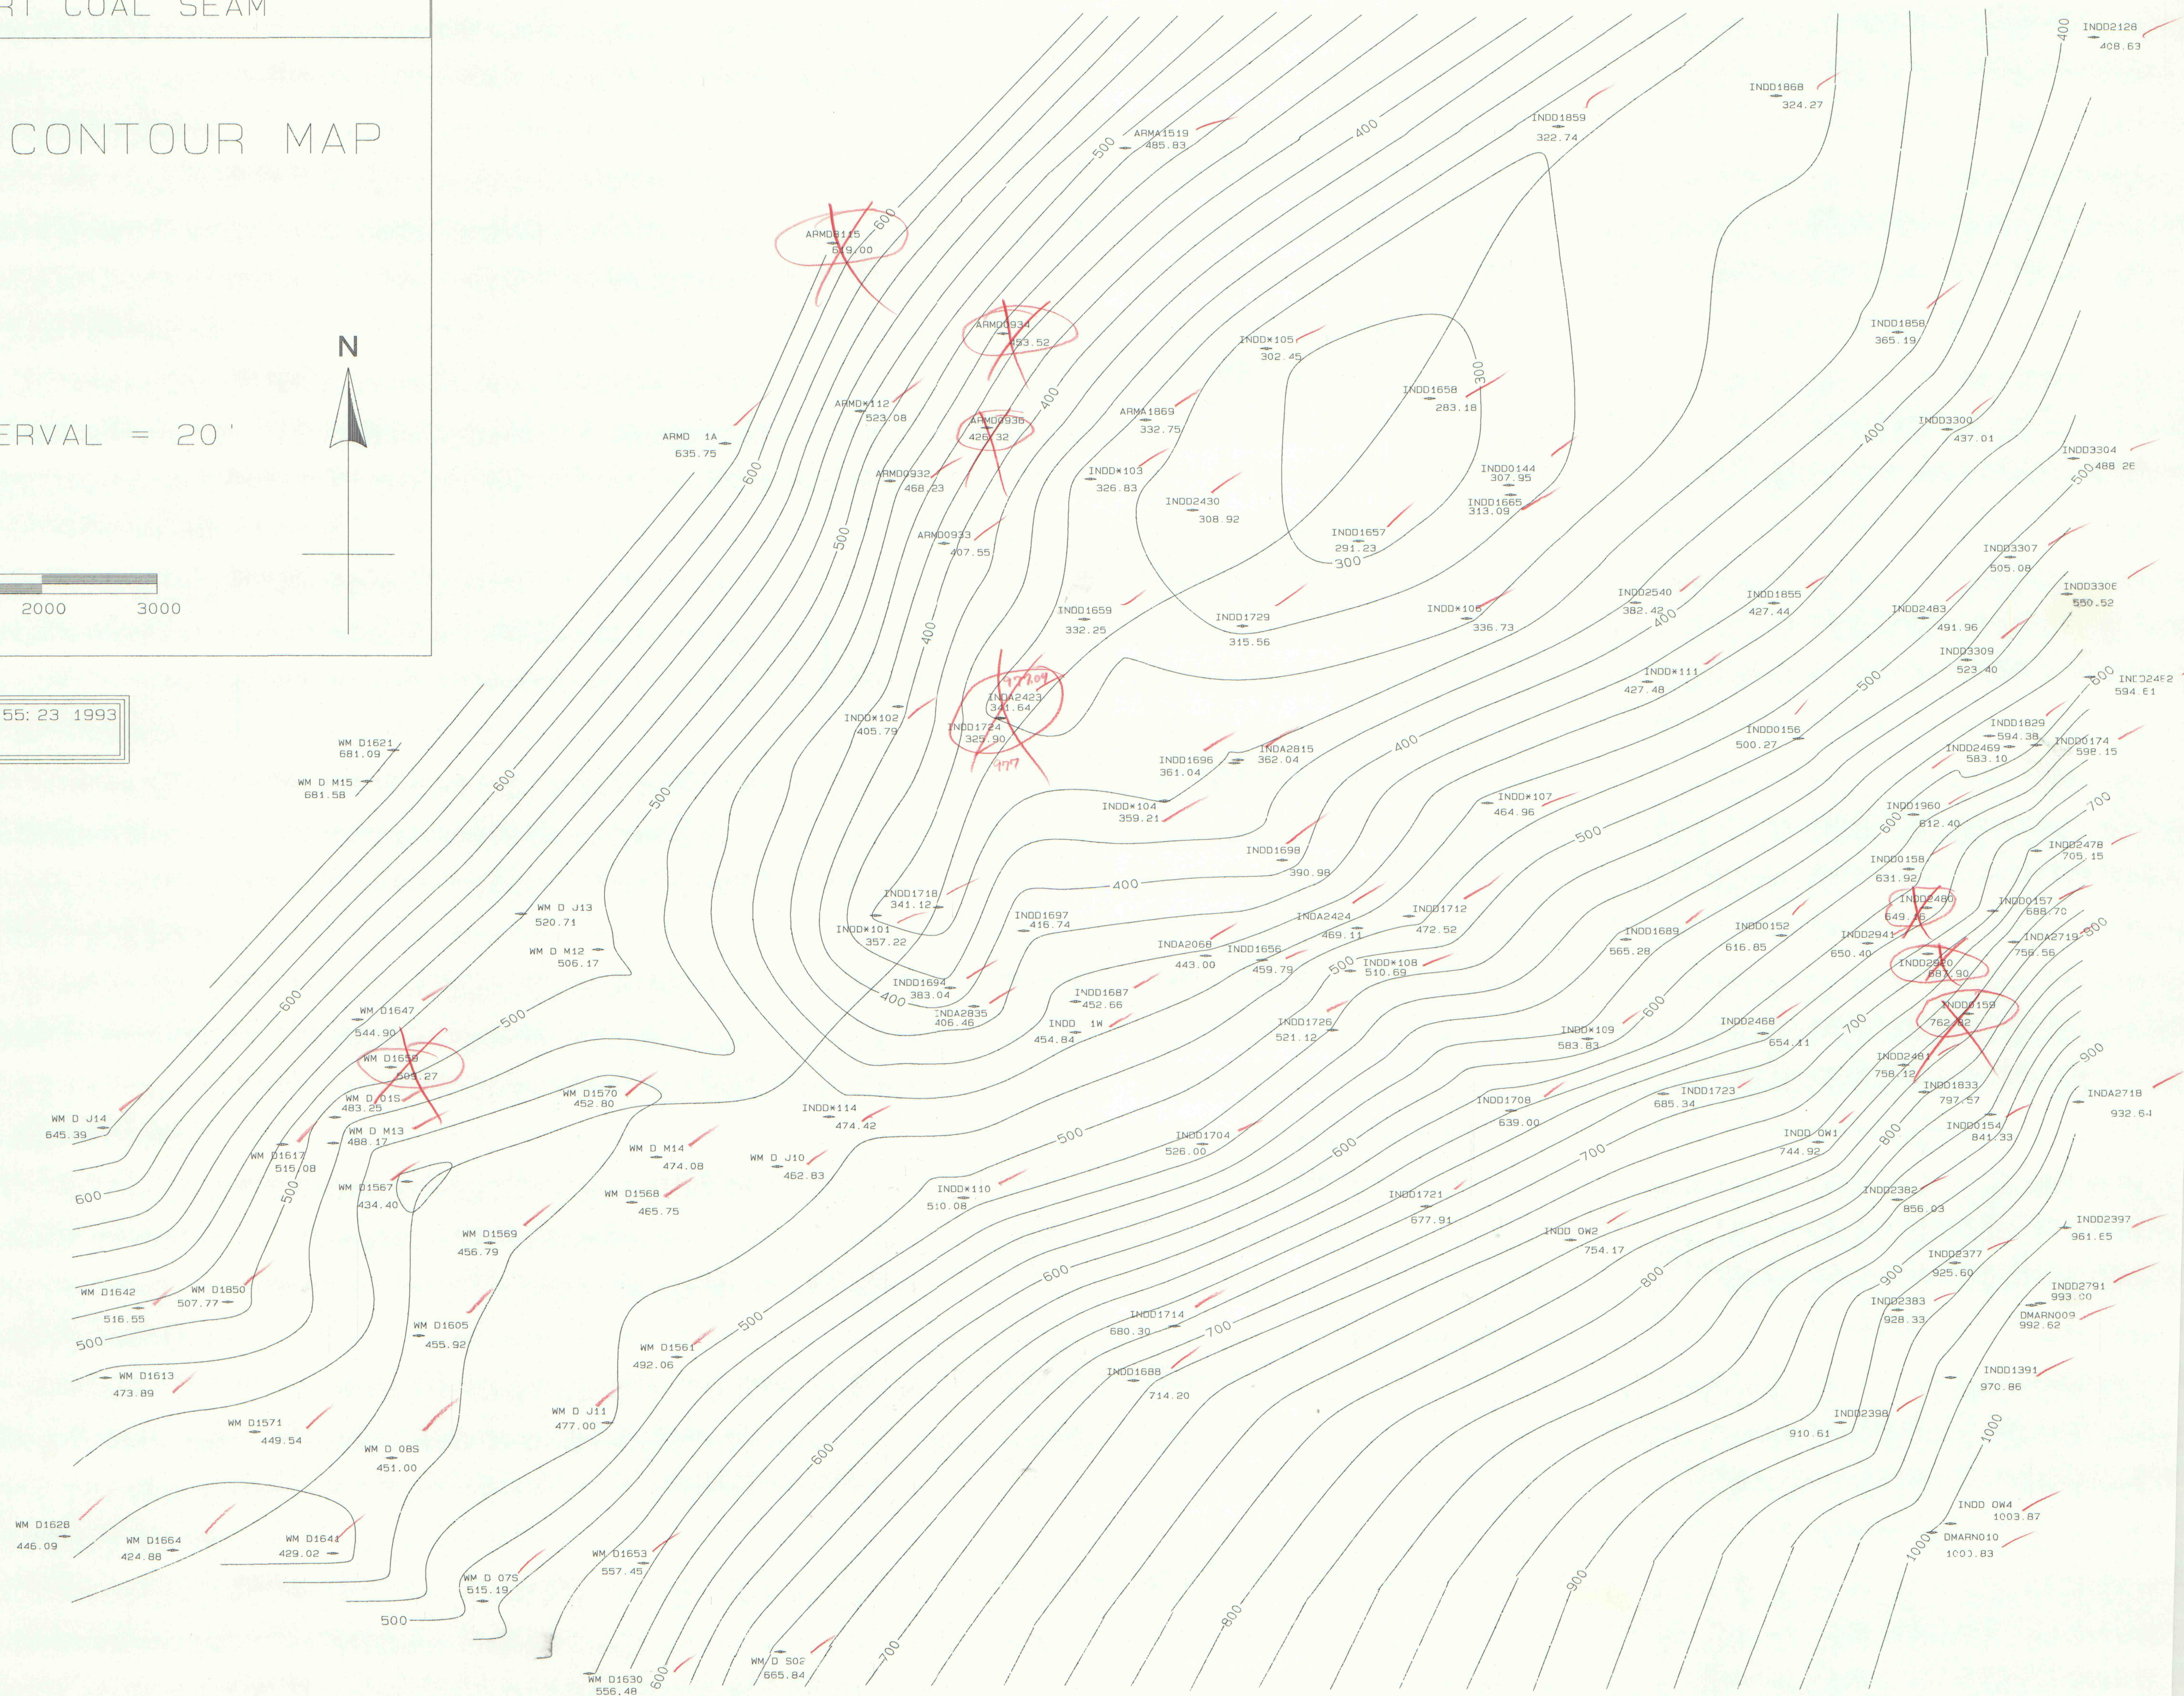

IMAPS# 09955