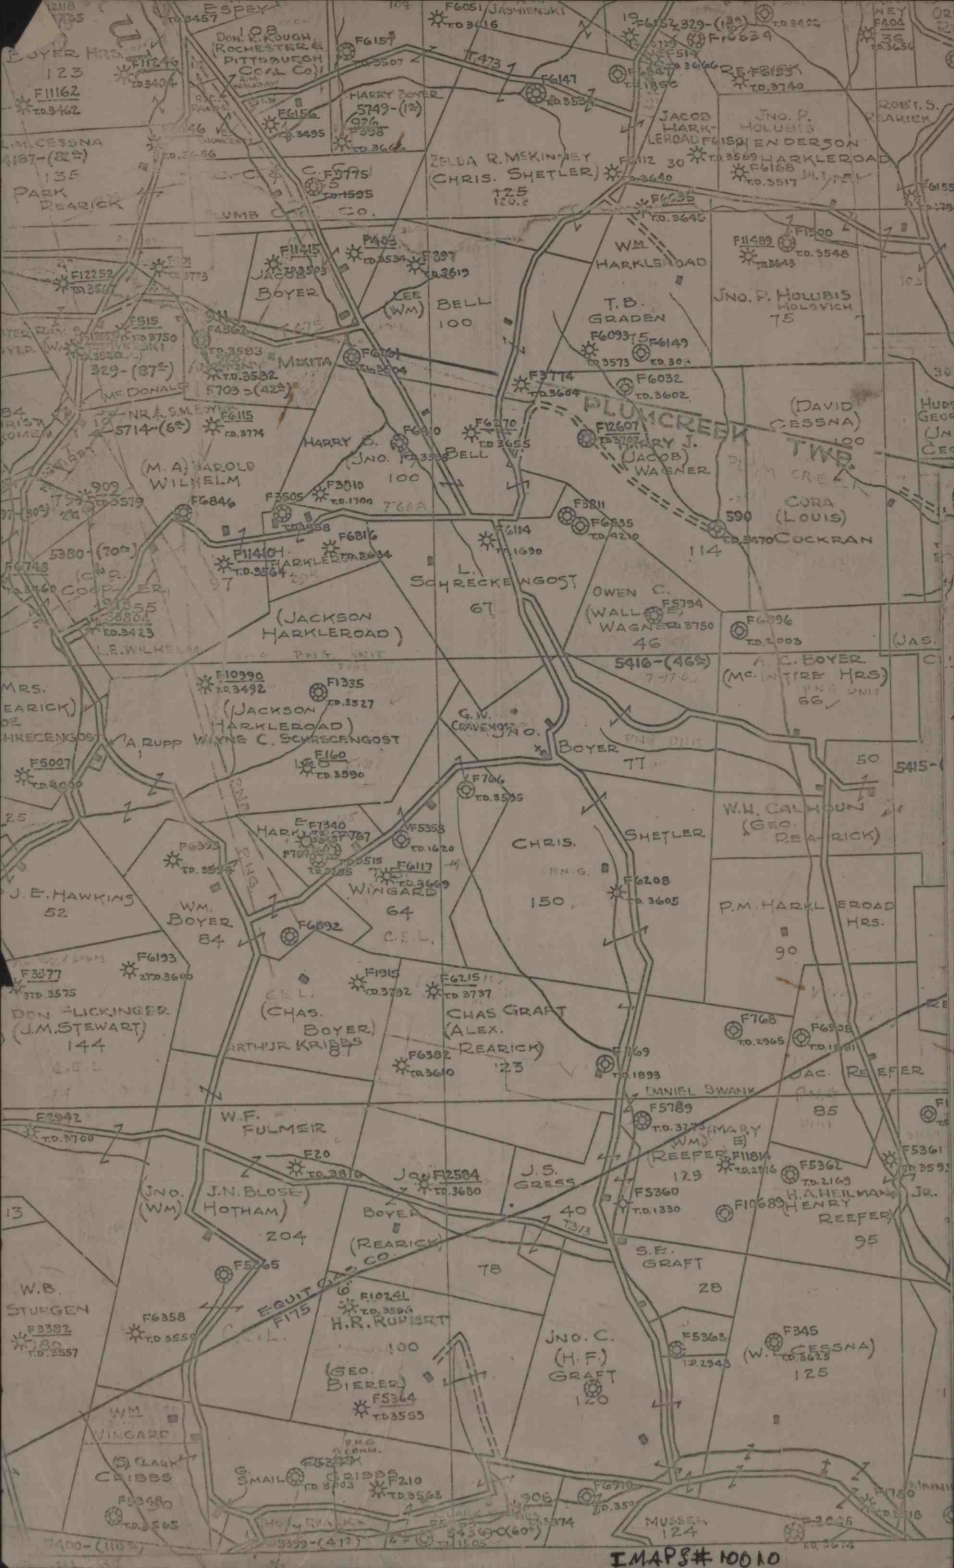
ESPEY
DON R. BOROUGH
ROCHESTER & PITTSBURGH COAL CO.
BOYER HTS.
123
PARK REARICK
HARRY BOYER
5749-(12)
ZELDA R. McKINNEY
(CHRIS. SHETLER)
125
JACOB HARKLEROAD
JNO. P. HOLUBIS
HENDERSON HARKLEROAD
ROB'T. S. REARICK
WM. HARKLEROAD
T.B. GRADEN
JNO. P. HOLUBIS
HOLOVICH
75
BOYER
LEE (WM)
BELL
100
MEKITA
329-(87ac)
McDONALD
5714-(6ac)
HARRY J. (JACOB) WAGNER
PLUM CREEK TWP.
(DAVID CESSNA)
100
CORA (LOUIS) COCKRAN
590
114
(M. A.) HAROLD WILHELM
JNO. BELL
100
L. SCHRECKENGOST
67
OWEN C. (WALL) WAGNER
46
(JACKSON HARKLEROAD)
5416-(46ac)
A. C. BOYER (McINTIRE HRS.)
66
(JACKSON HARKLEROAD)
WAYNE C. SCHRECENGOST
A. RUPP
JNO. BOYER
77
CHRIS. SHETLER
150
W.H. CALHOUN (GEO. REARICK)
P.M. HARKLEROAD HRS.
90
J.E. HAWKINS
52
WM. BOYER
84
WINGARD
64
DON FLICKINGER (J.M. STEWART)
144
(CHAS. BOYER) ARTHUR KRIBBS
87
CHAS GRAFT (ALEX. REARICK)
123
DANIEL SWANK
JAC. REEFER
85
W.F. FULMEIR
(WM) REEFER
129
JNO. (WM) HOTHAM
204
J.N. BLOSE
BOYER (REARICK CO.)
78
J.S. GRESS
40
H.A. HEILMAN Jr.
HENRY REEFER
95
S.E. GRAFT
28
W.B. STURGEN
H.R. RUPERT
100
(GEO. BIERER)
JNO. C. (H.F.) GRAFT
120
(W.) CESSNA
125
WM. WINGARD
CLAUD CRIBBS
SMAILS
CRIBBS
MUSSER
124

IMAPS# 10010