


PENNSYLVANIA
LATROBE QUADRANGLE

NW ¼

59

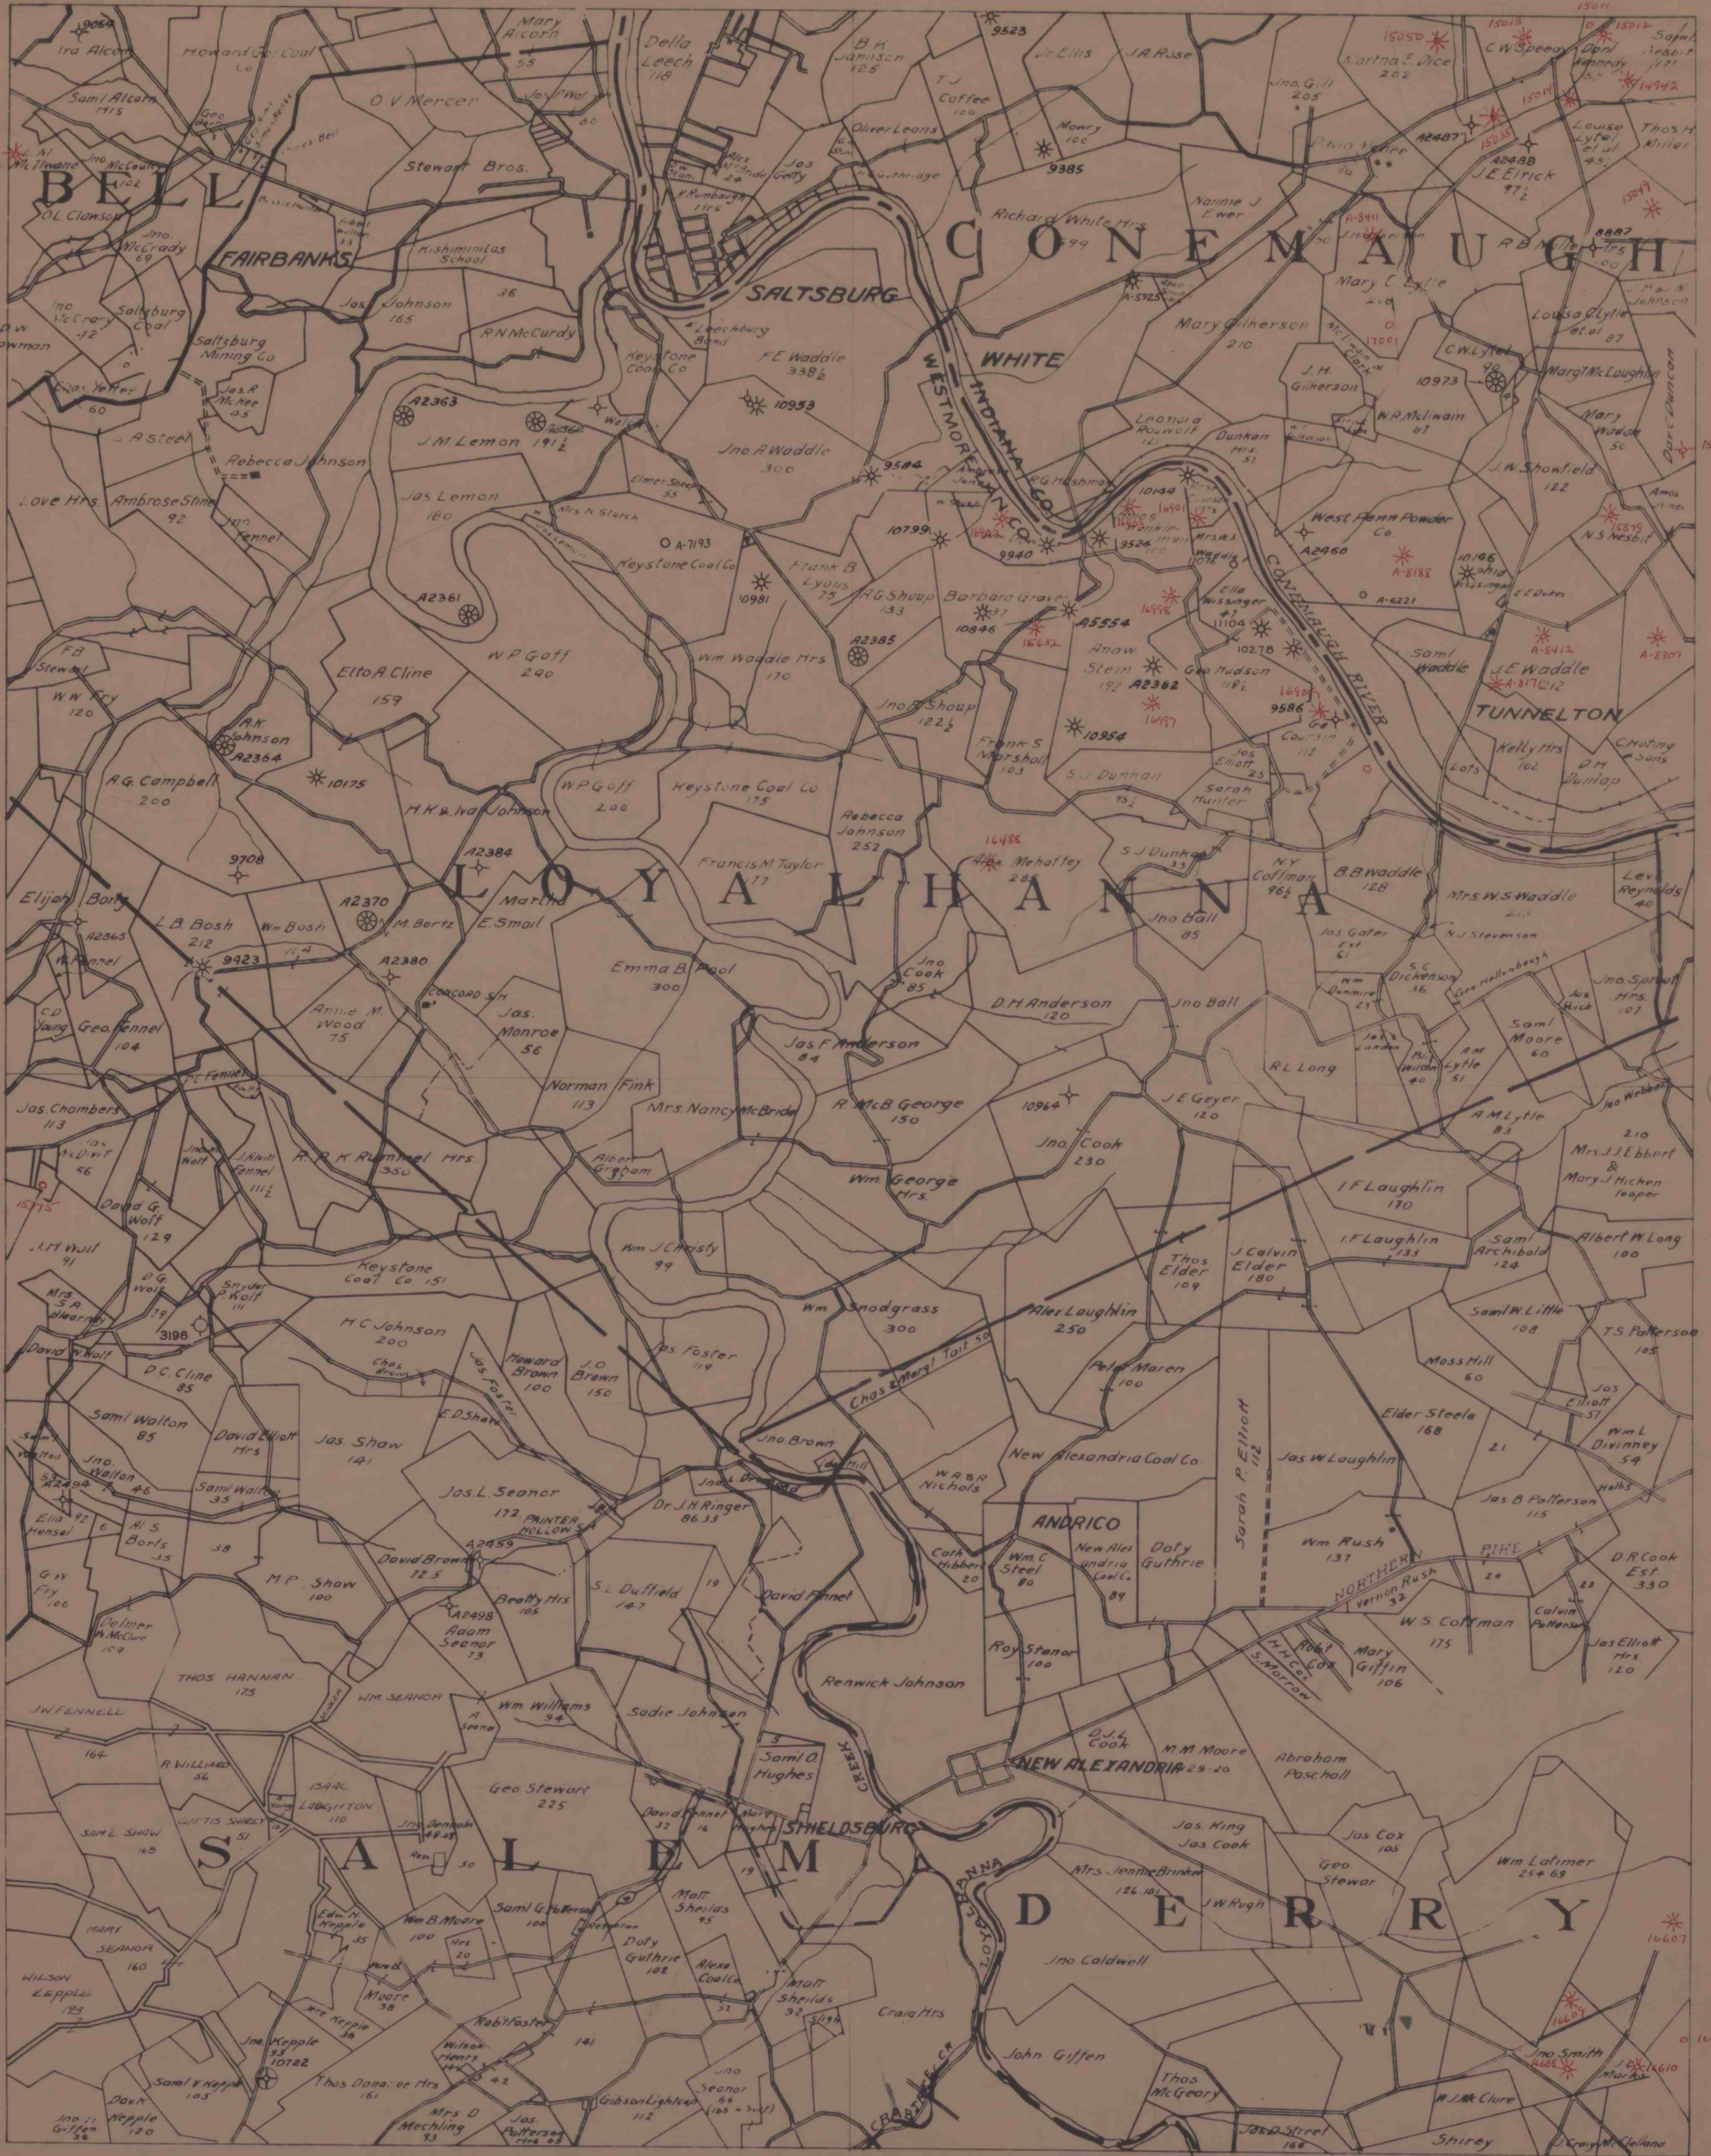

SCALE 1"=2000'

43

LATROBE NW 41
IMAPS 10022

4-25-77