


PENNSYLVANIA
DUBOIS QUADRANGLE

NW 1/4

103

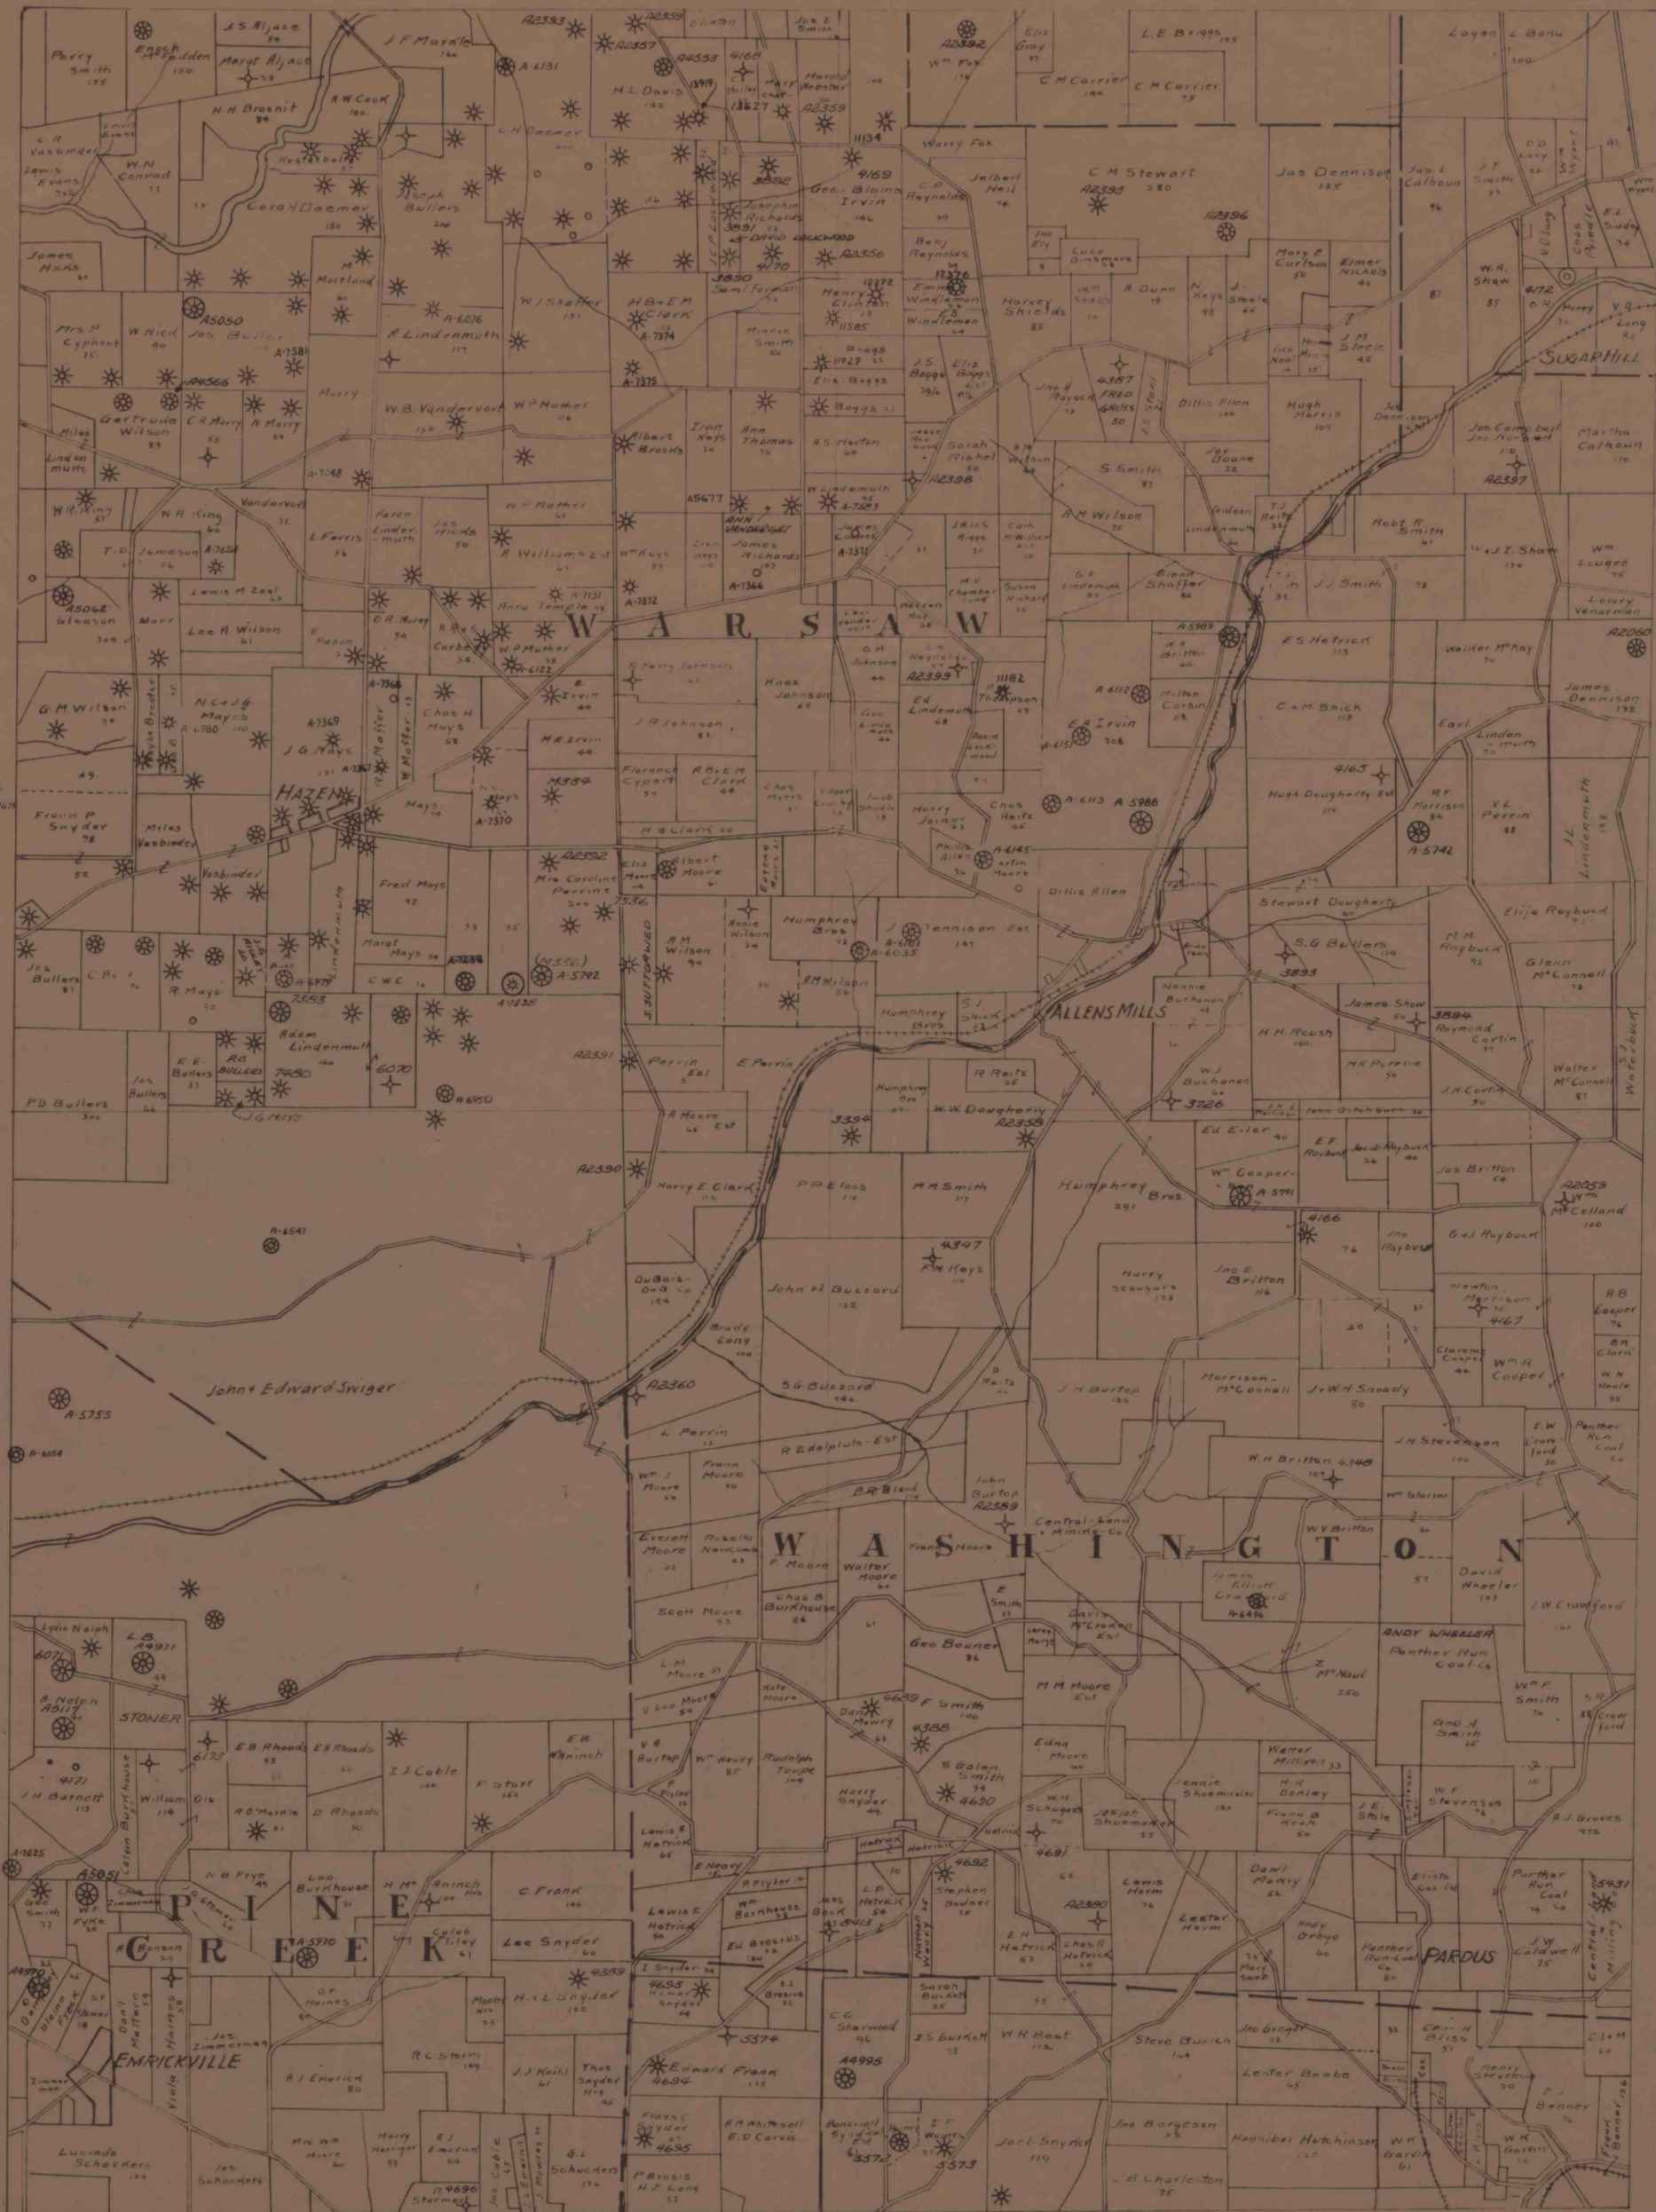

SEP 30 1974

SCALE - 1" = 2000'

DUBOIS NW93 IMAPS #10030