


DO NOT EXTEND

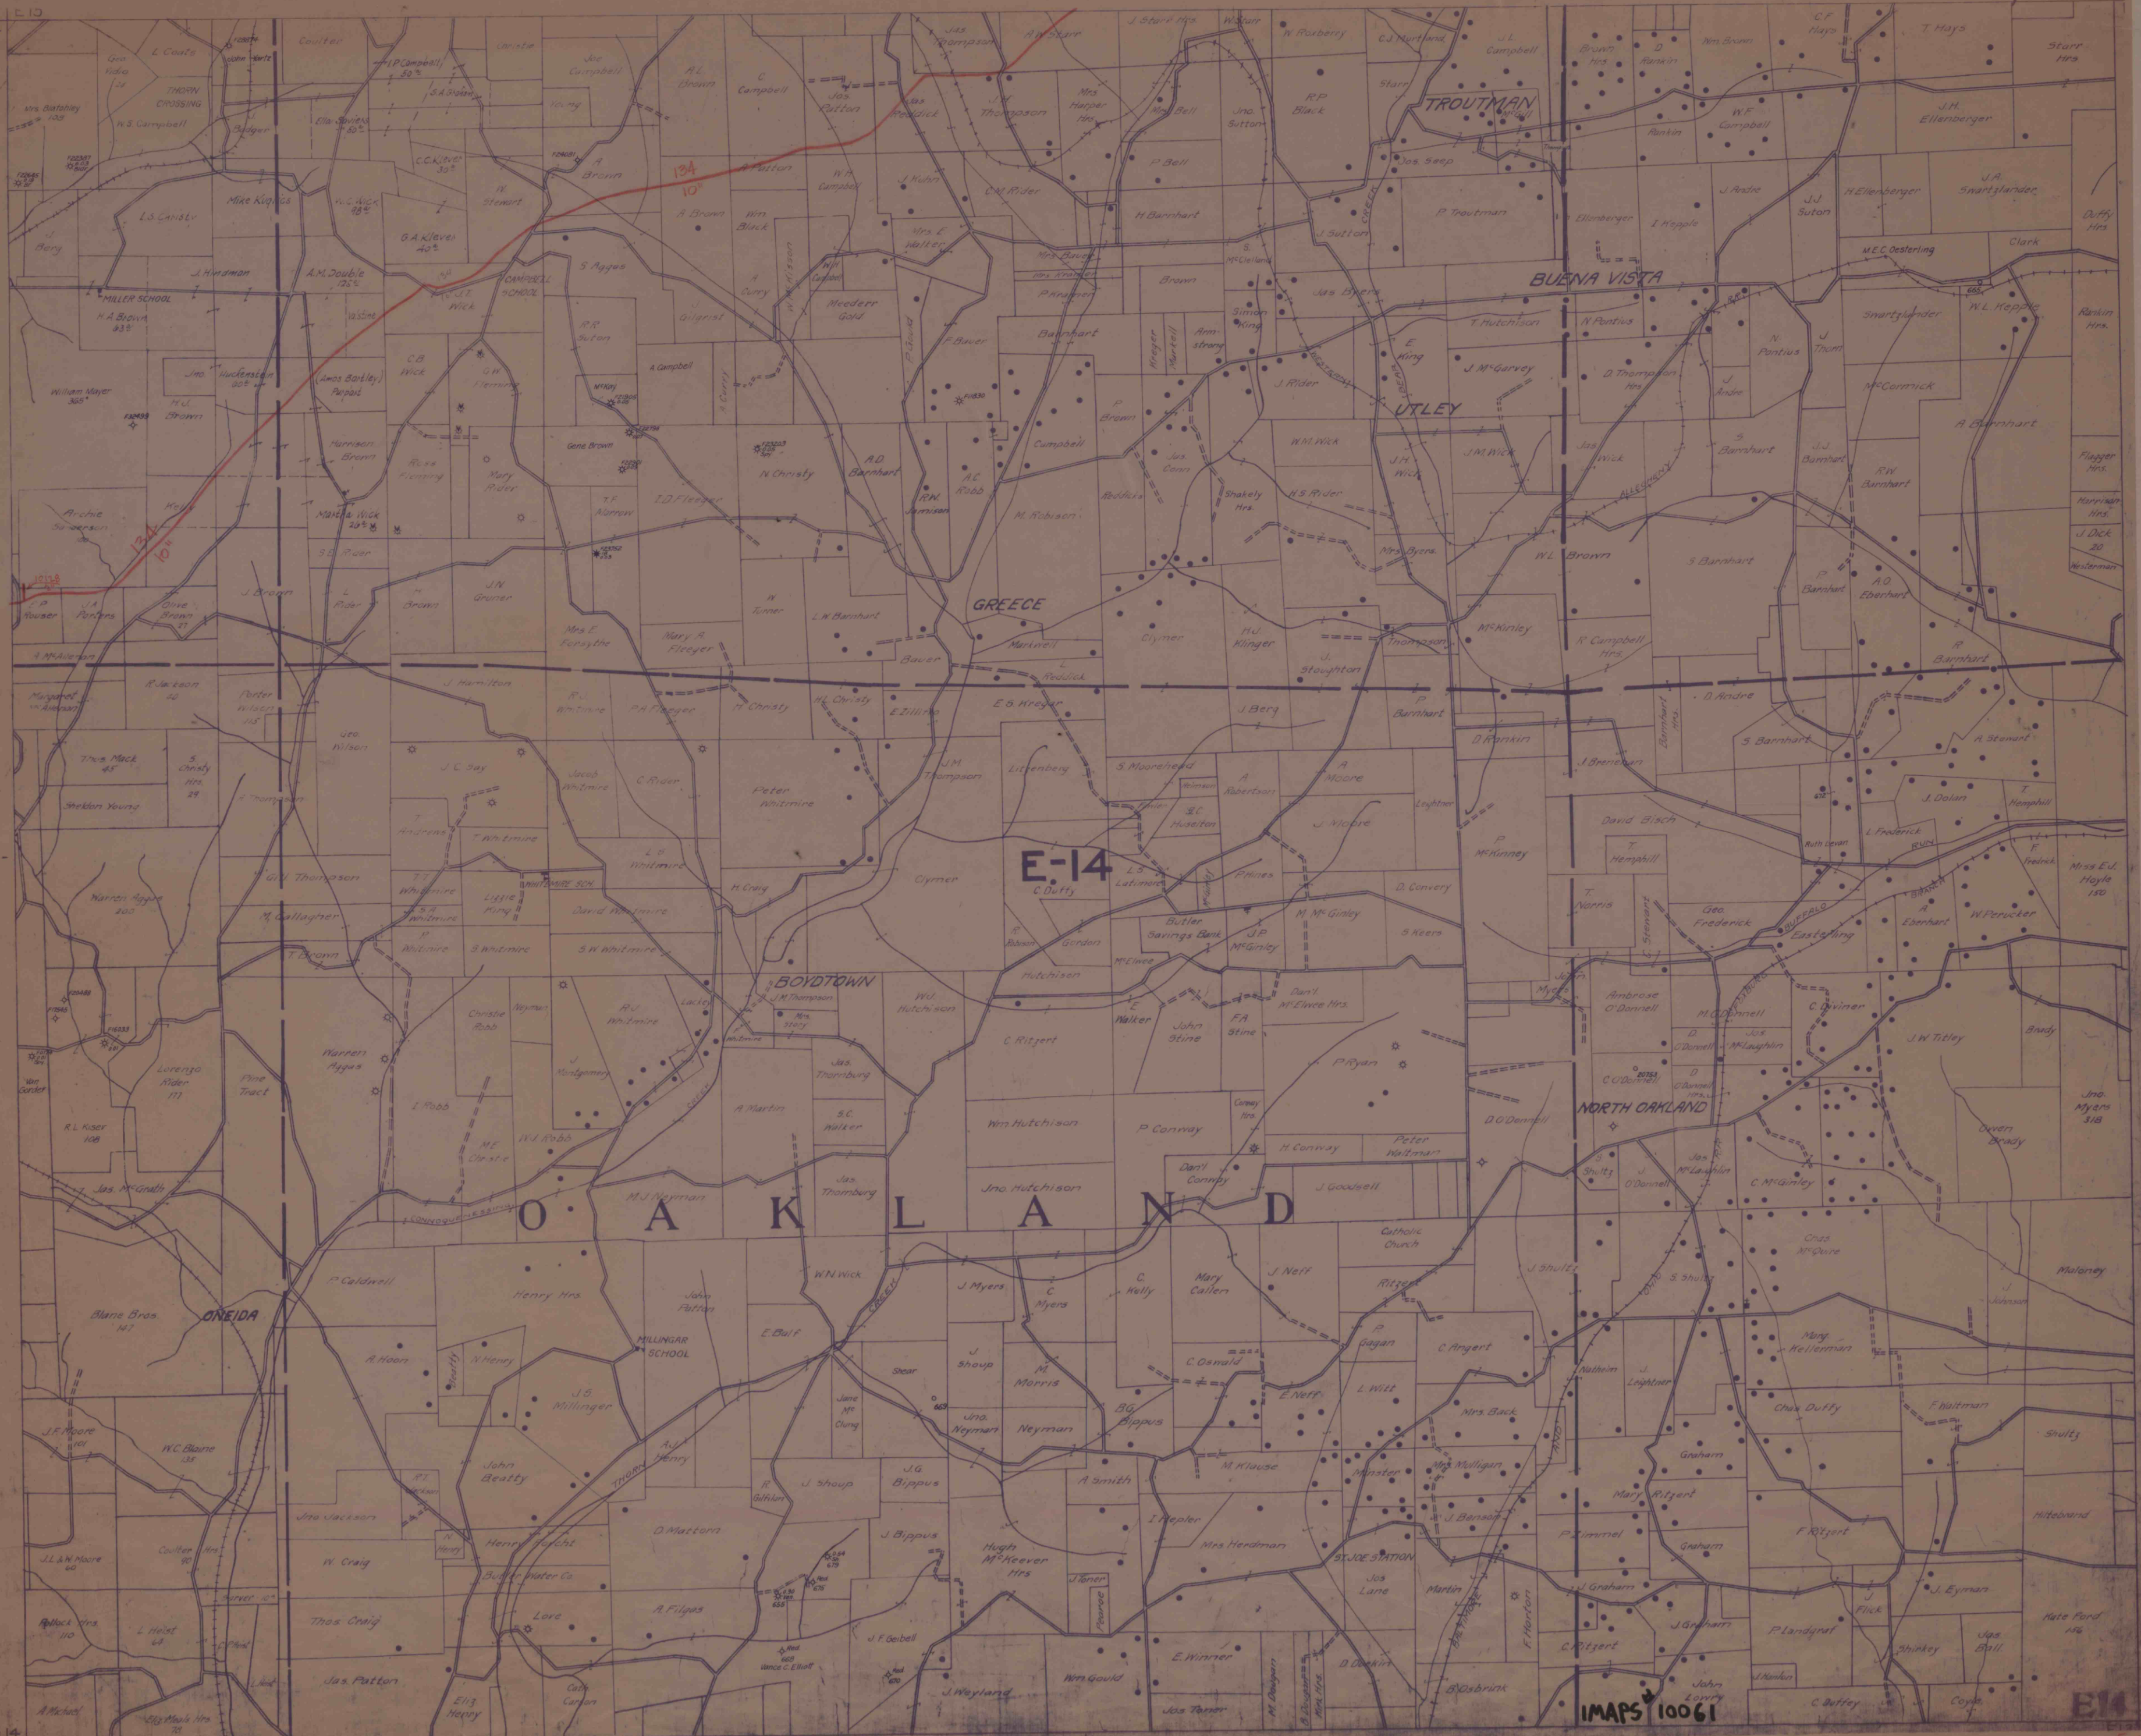

E-14

IMAPS 10061

E14