


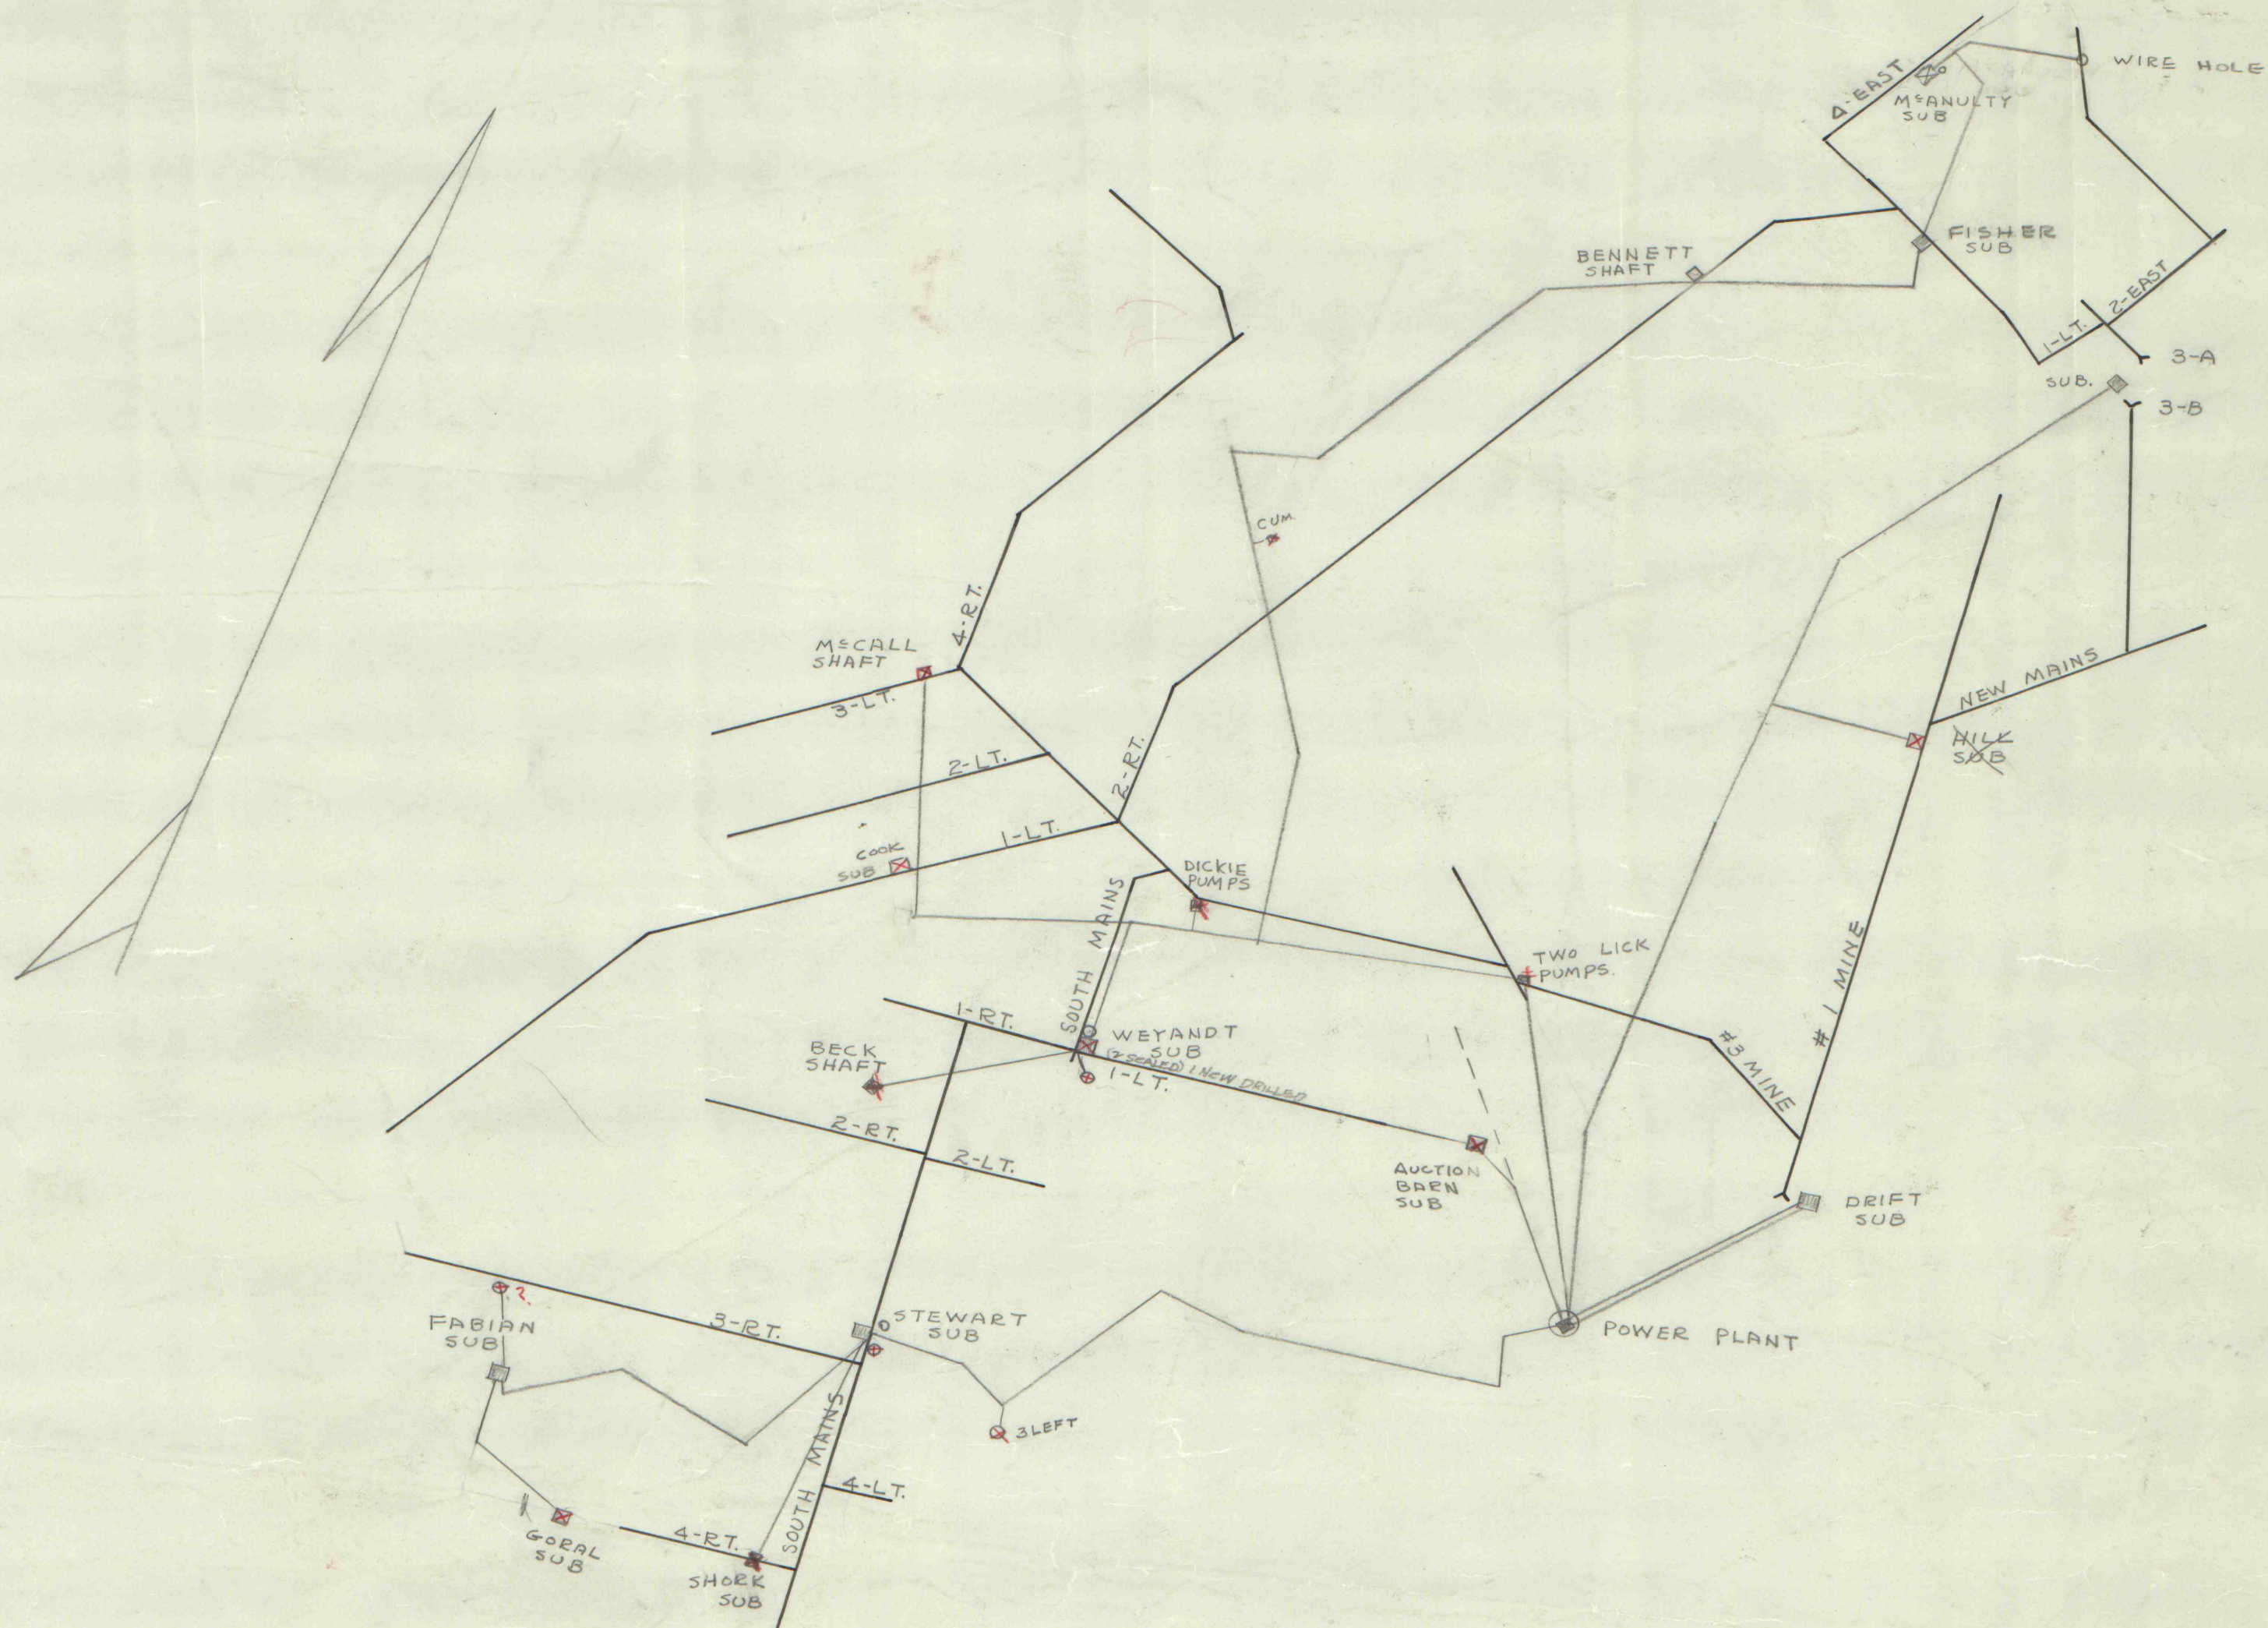

Borehole
Sealed

DATE REVISED		TYPE INSTALLATION		ROCHESTER & PITTSBURGH COAL CO. ENGINEERING DEPT. INDIAN, PA.
		ADDED	REMOVED	
		FINDLEY SUB.	WETLAND (NEW DRILLED & HOLES SEALED)	SCHEMATIC MAP SHOWING HEADINGS & G.G.K.V. TRANS- MISSION LINES ON SURFACE. LUC-3
		GORAL	HILL 10-1-65	
		AUCTION BARN	AUCTION 10-1-65	
			GORAL 10-1-65	
			COOK 10-1-65	
			CUMMINGS	SCALE - Refer map key.
				TRACED BY
				CHECKED BY
				NO. 9422-67