


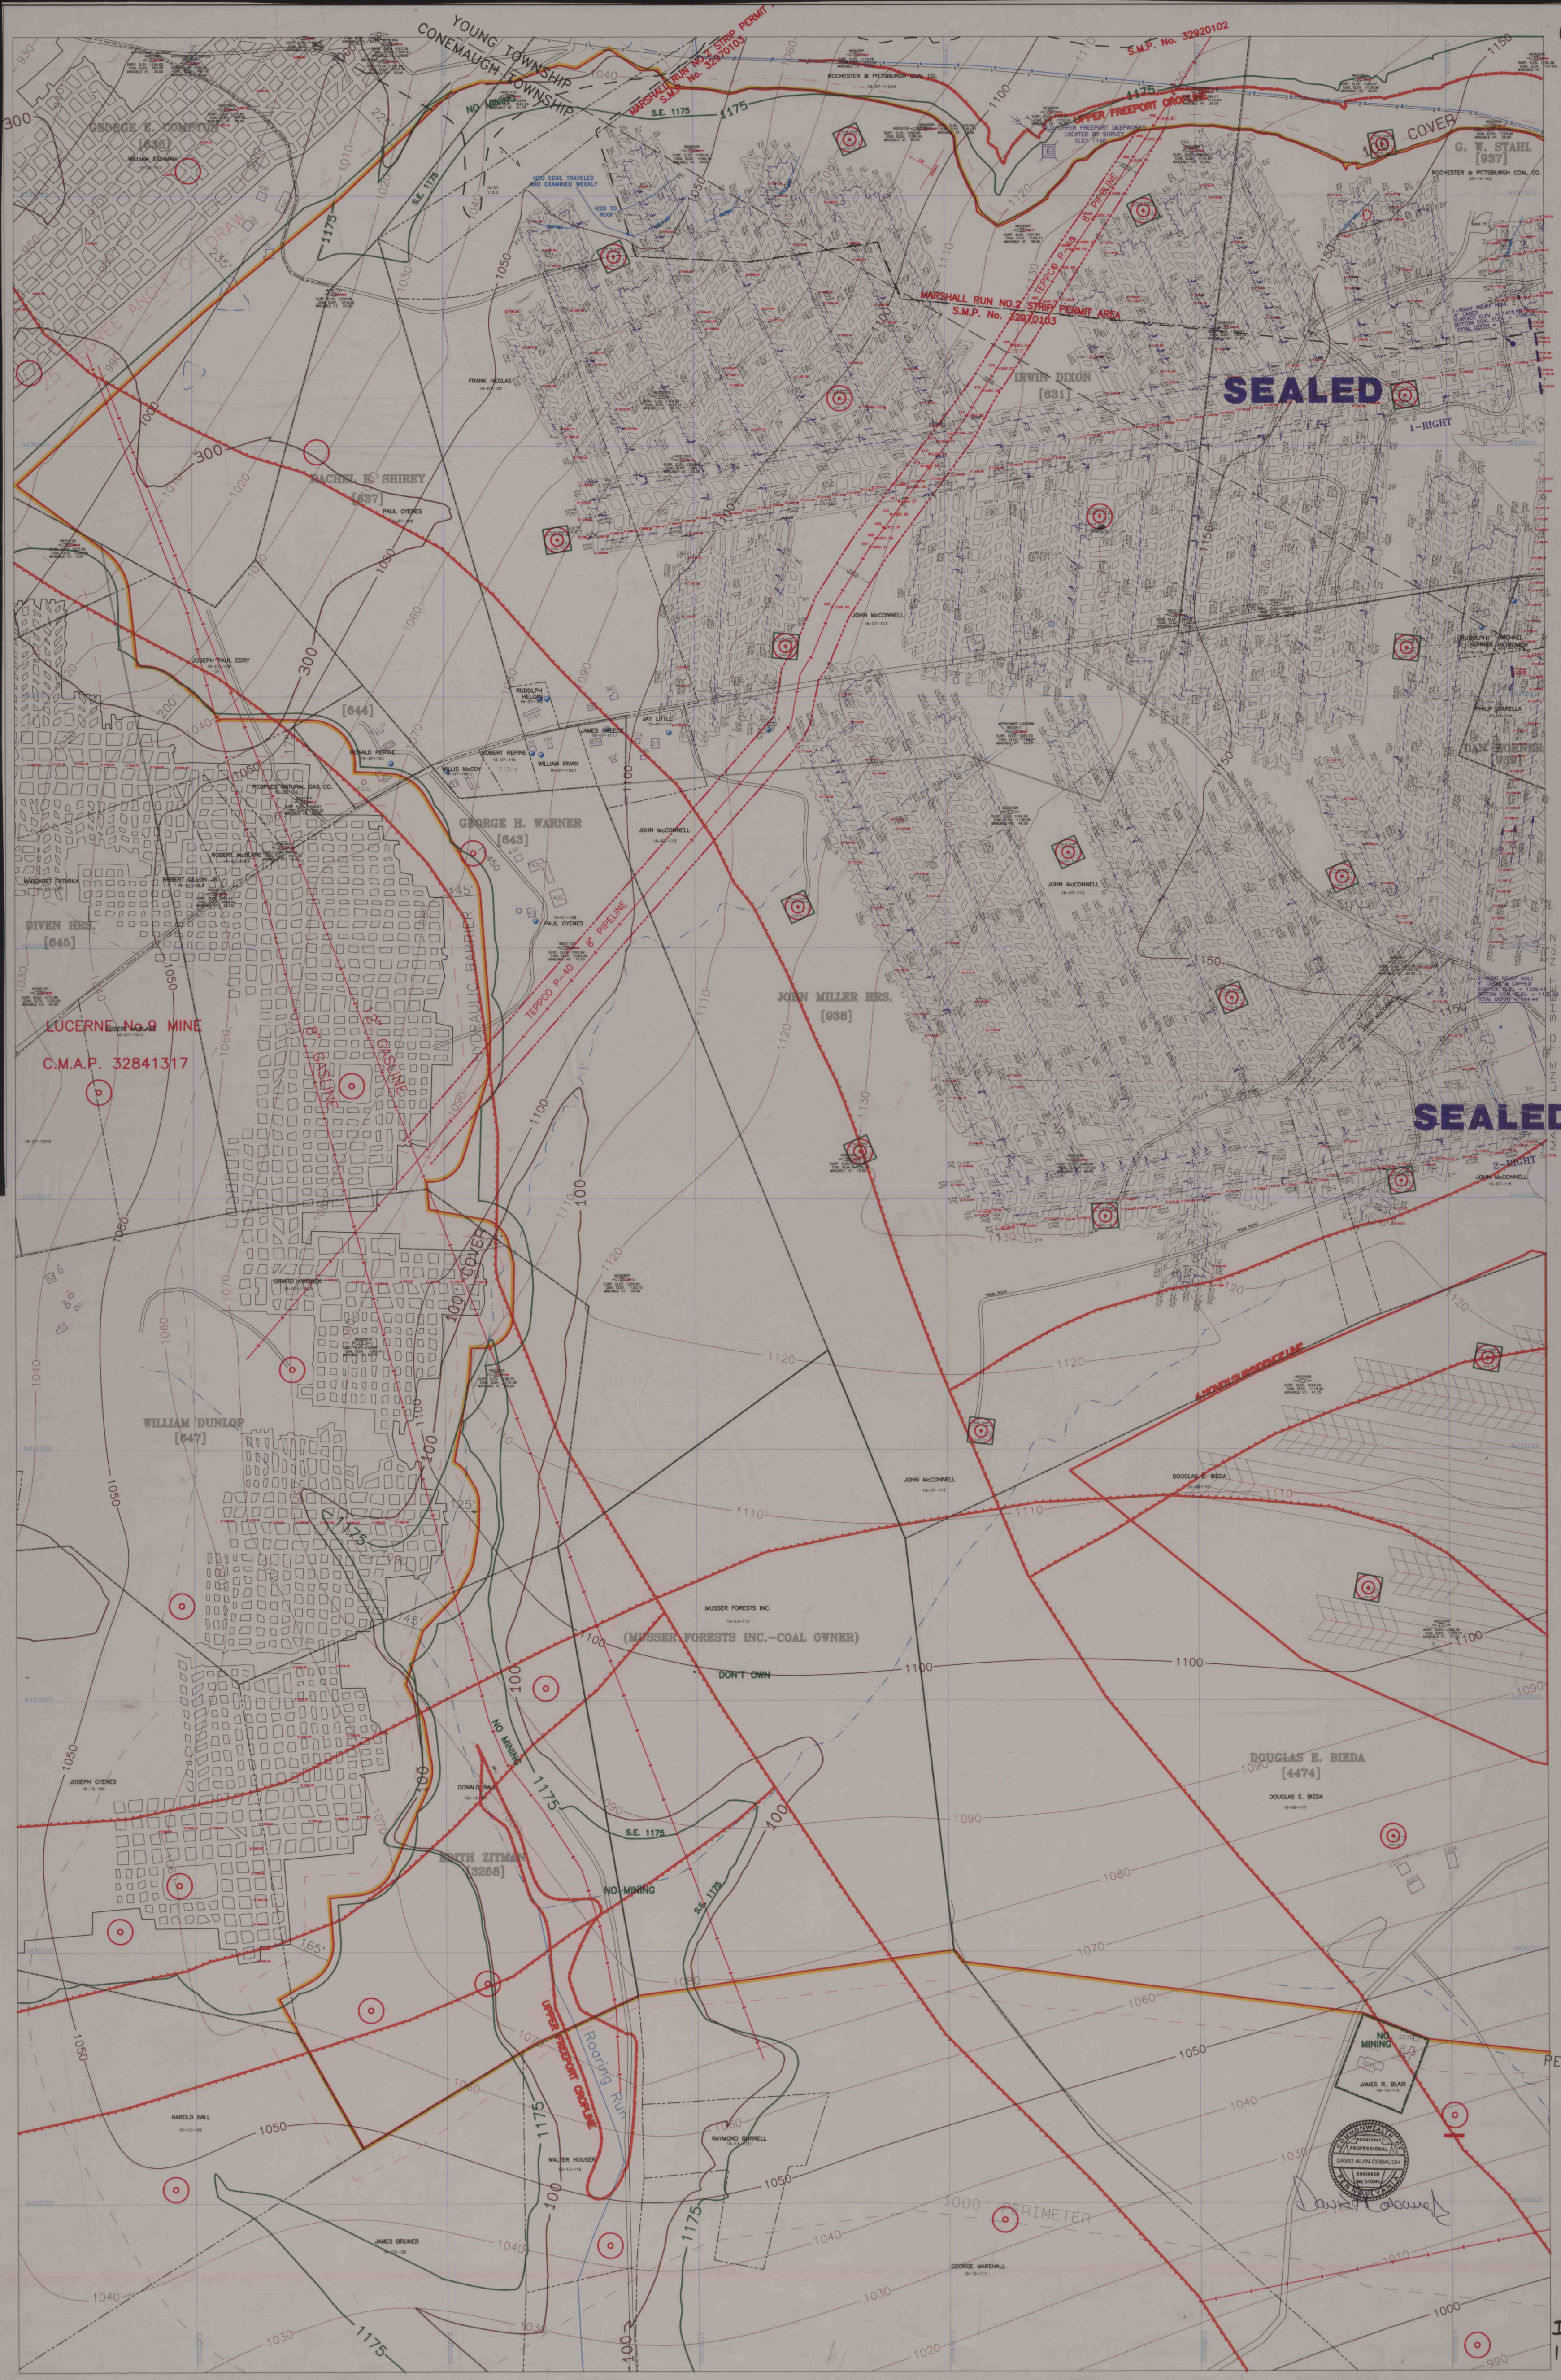

POSTED 3-1-1998 CONTEMPLATED MINING FROM 3-1-98 TO 9-1-98

PERMIT BO
IMAPS#
10092